

SEE 4-00-015-H

580.


-025  
3.52A

THIS PARCEL DROPPED  
FROM MAP & TAX  
RECORDS PER  
MAP DEPT.

-026  
1.85A

539.91

Put Ac Back  
on

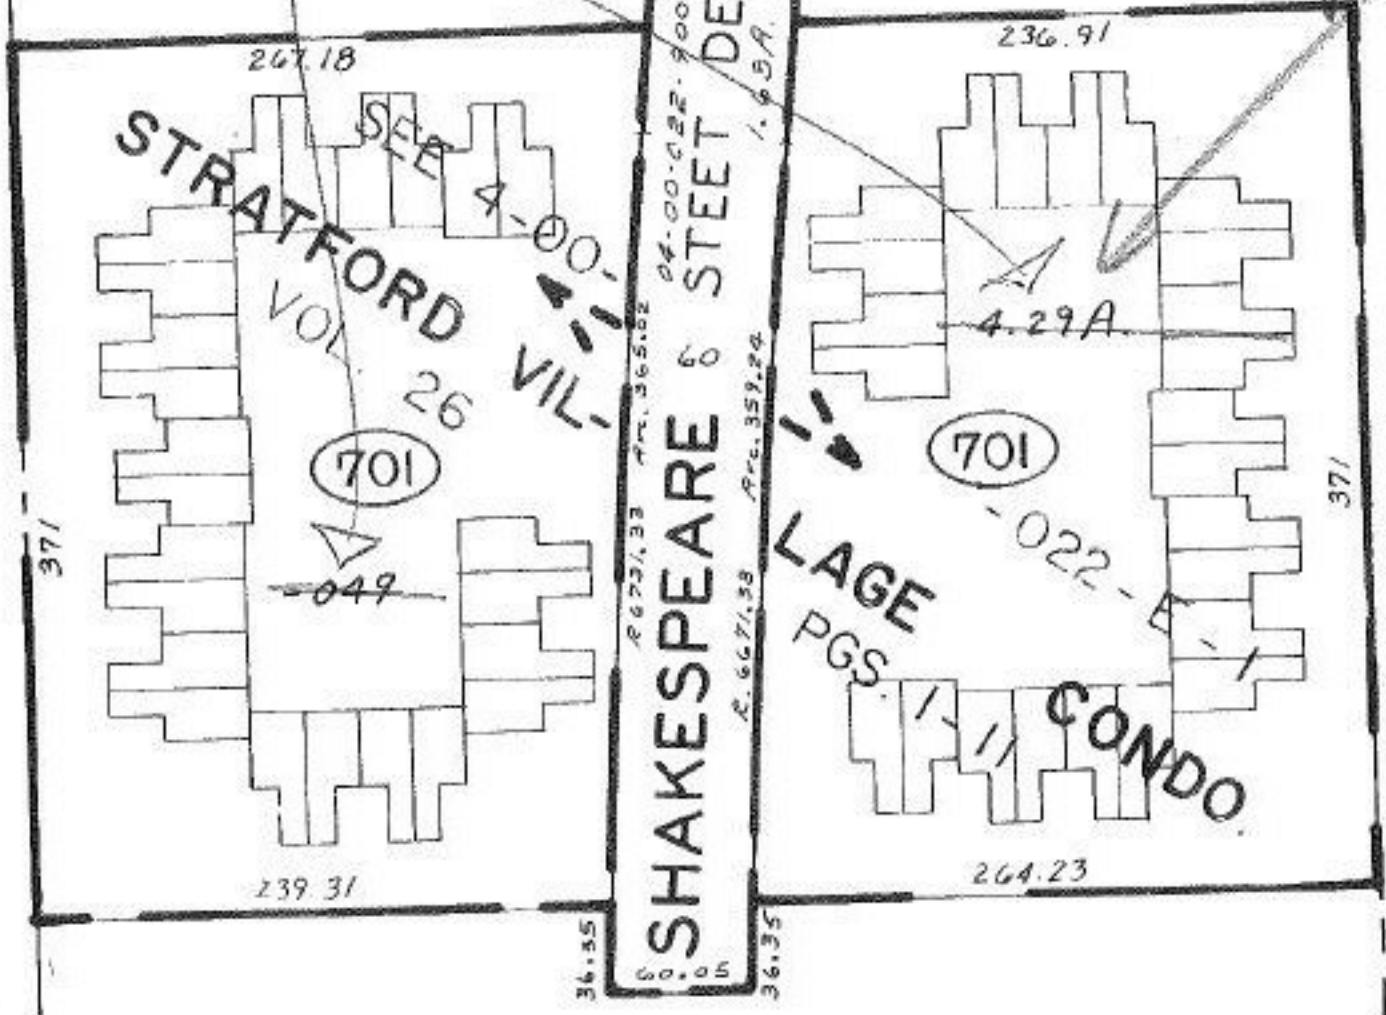

DELETE FROM RECORDS

#15471

APPROVED  
LORAIN CO.  
MAP DEPT.

DATE 3.14.84

PAGE 4-00-022

BY T. McNair

T.H. 3/14/85

103

-004M  
5.16A.

-027  
9.00A

700.73  
700.73