


06-24-035 106-018
 810-901
 019
 20734
 1500

SEE 6-79

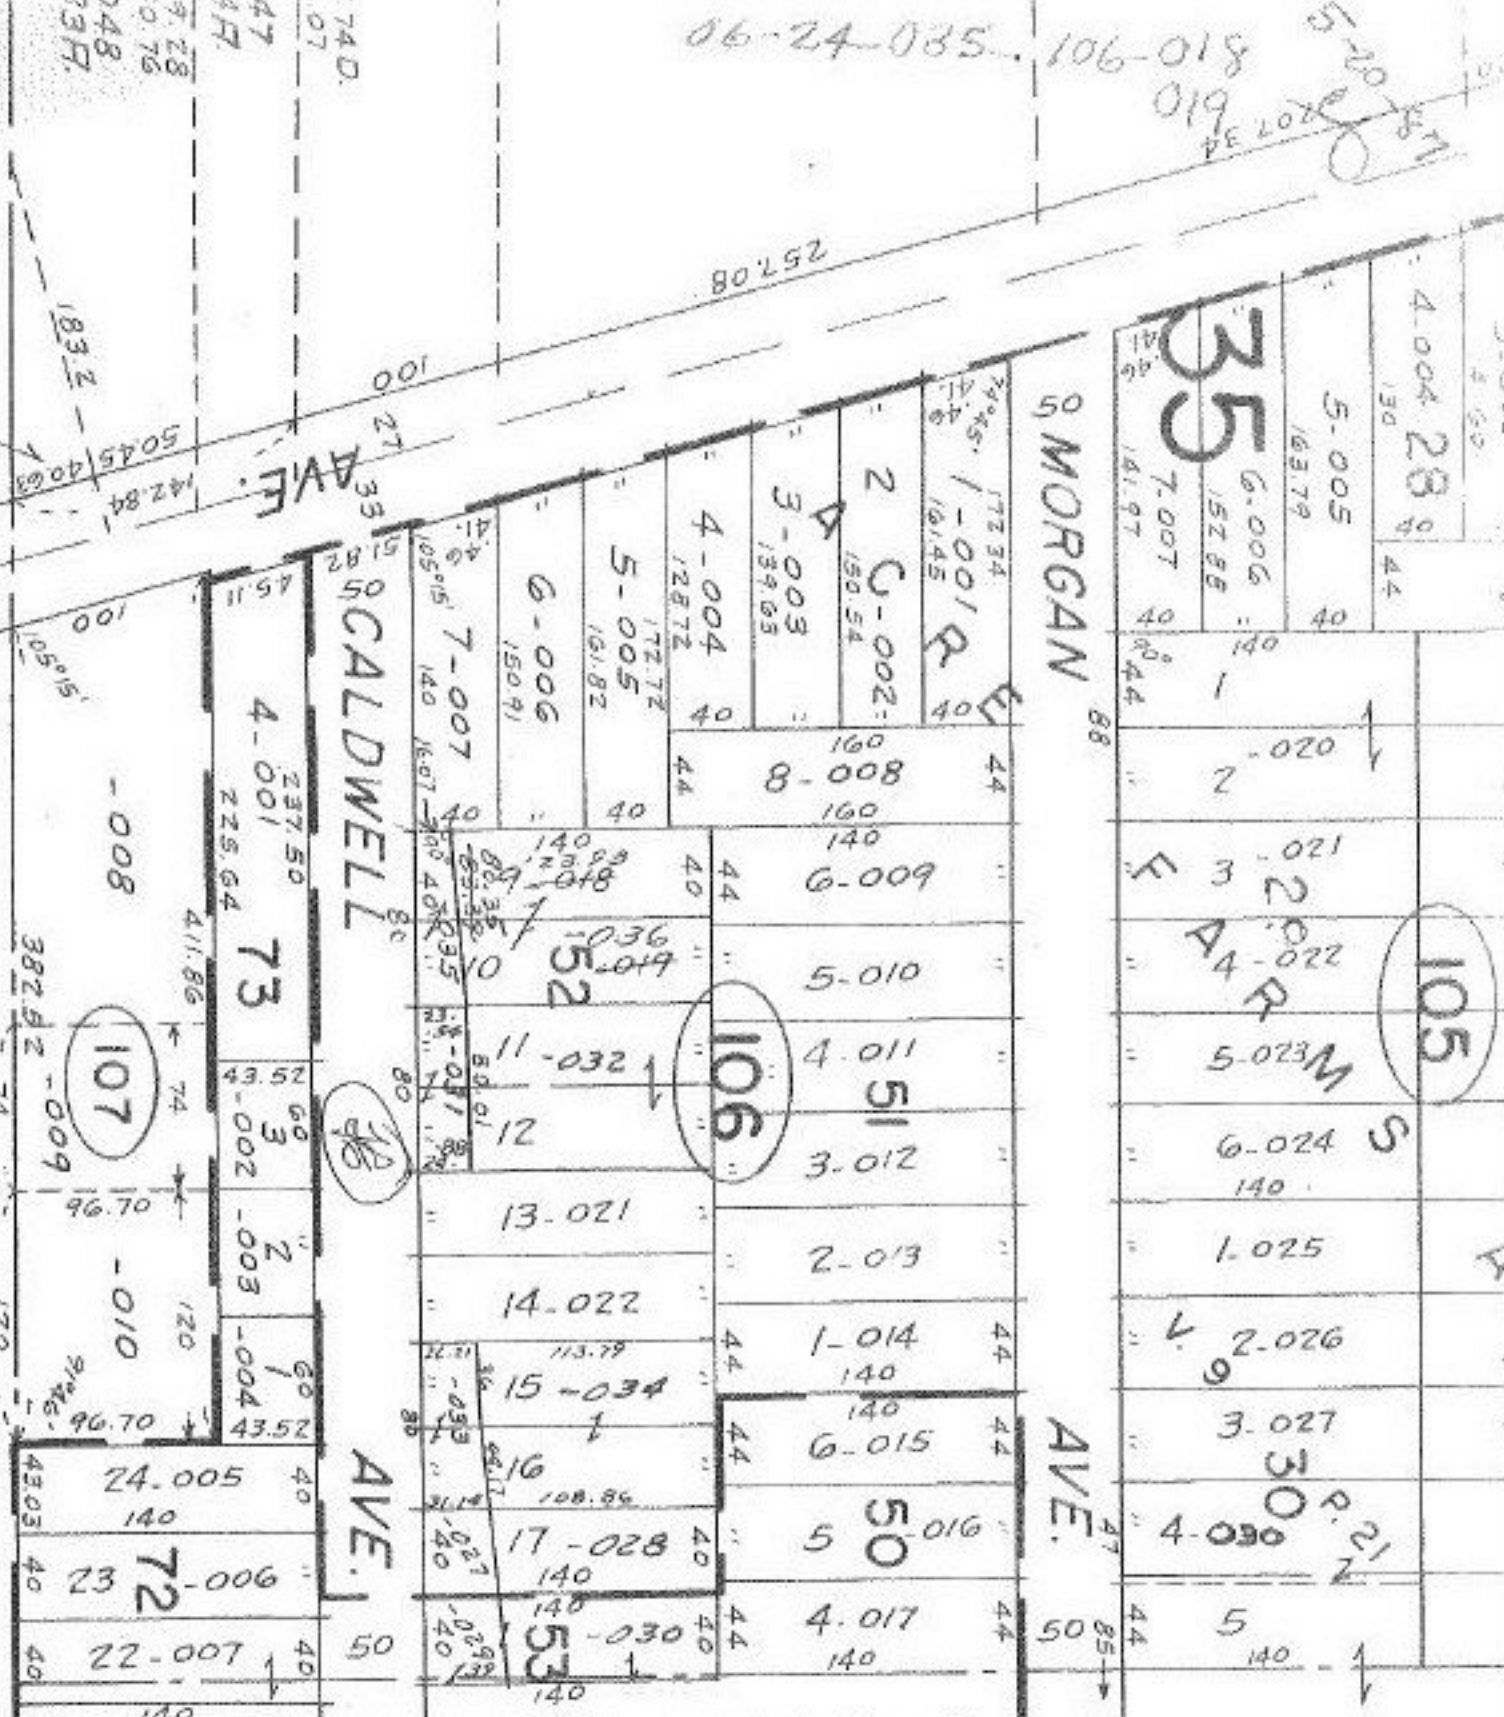

ACRE FARMS ALLT. 2

V. II. P. 29

APPROVED
 LORAIN CO.
 MAP DEPT.
 DATE 2-15-68
 #15570
 BY [Signature]

Done 5-4-68
 D. [Signature]

Page - 6-61

140
 135