


SEE 3-00-034-A

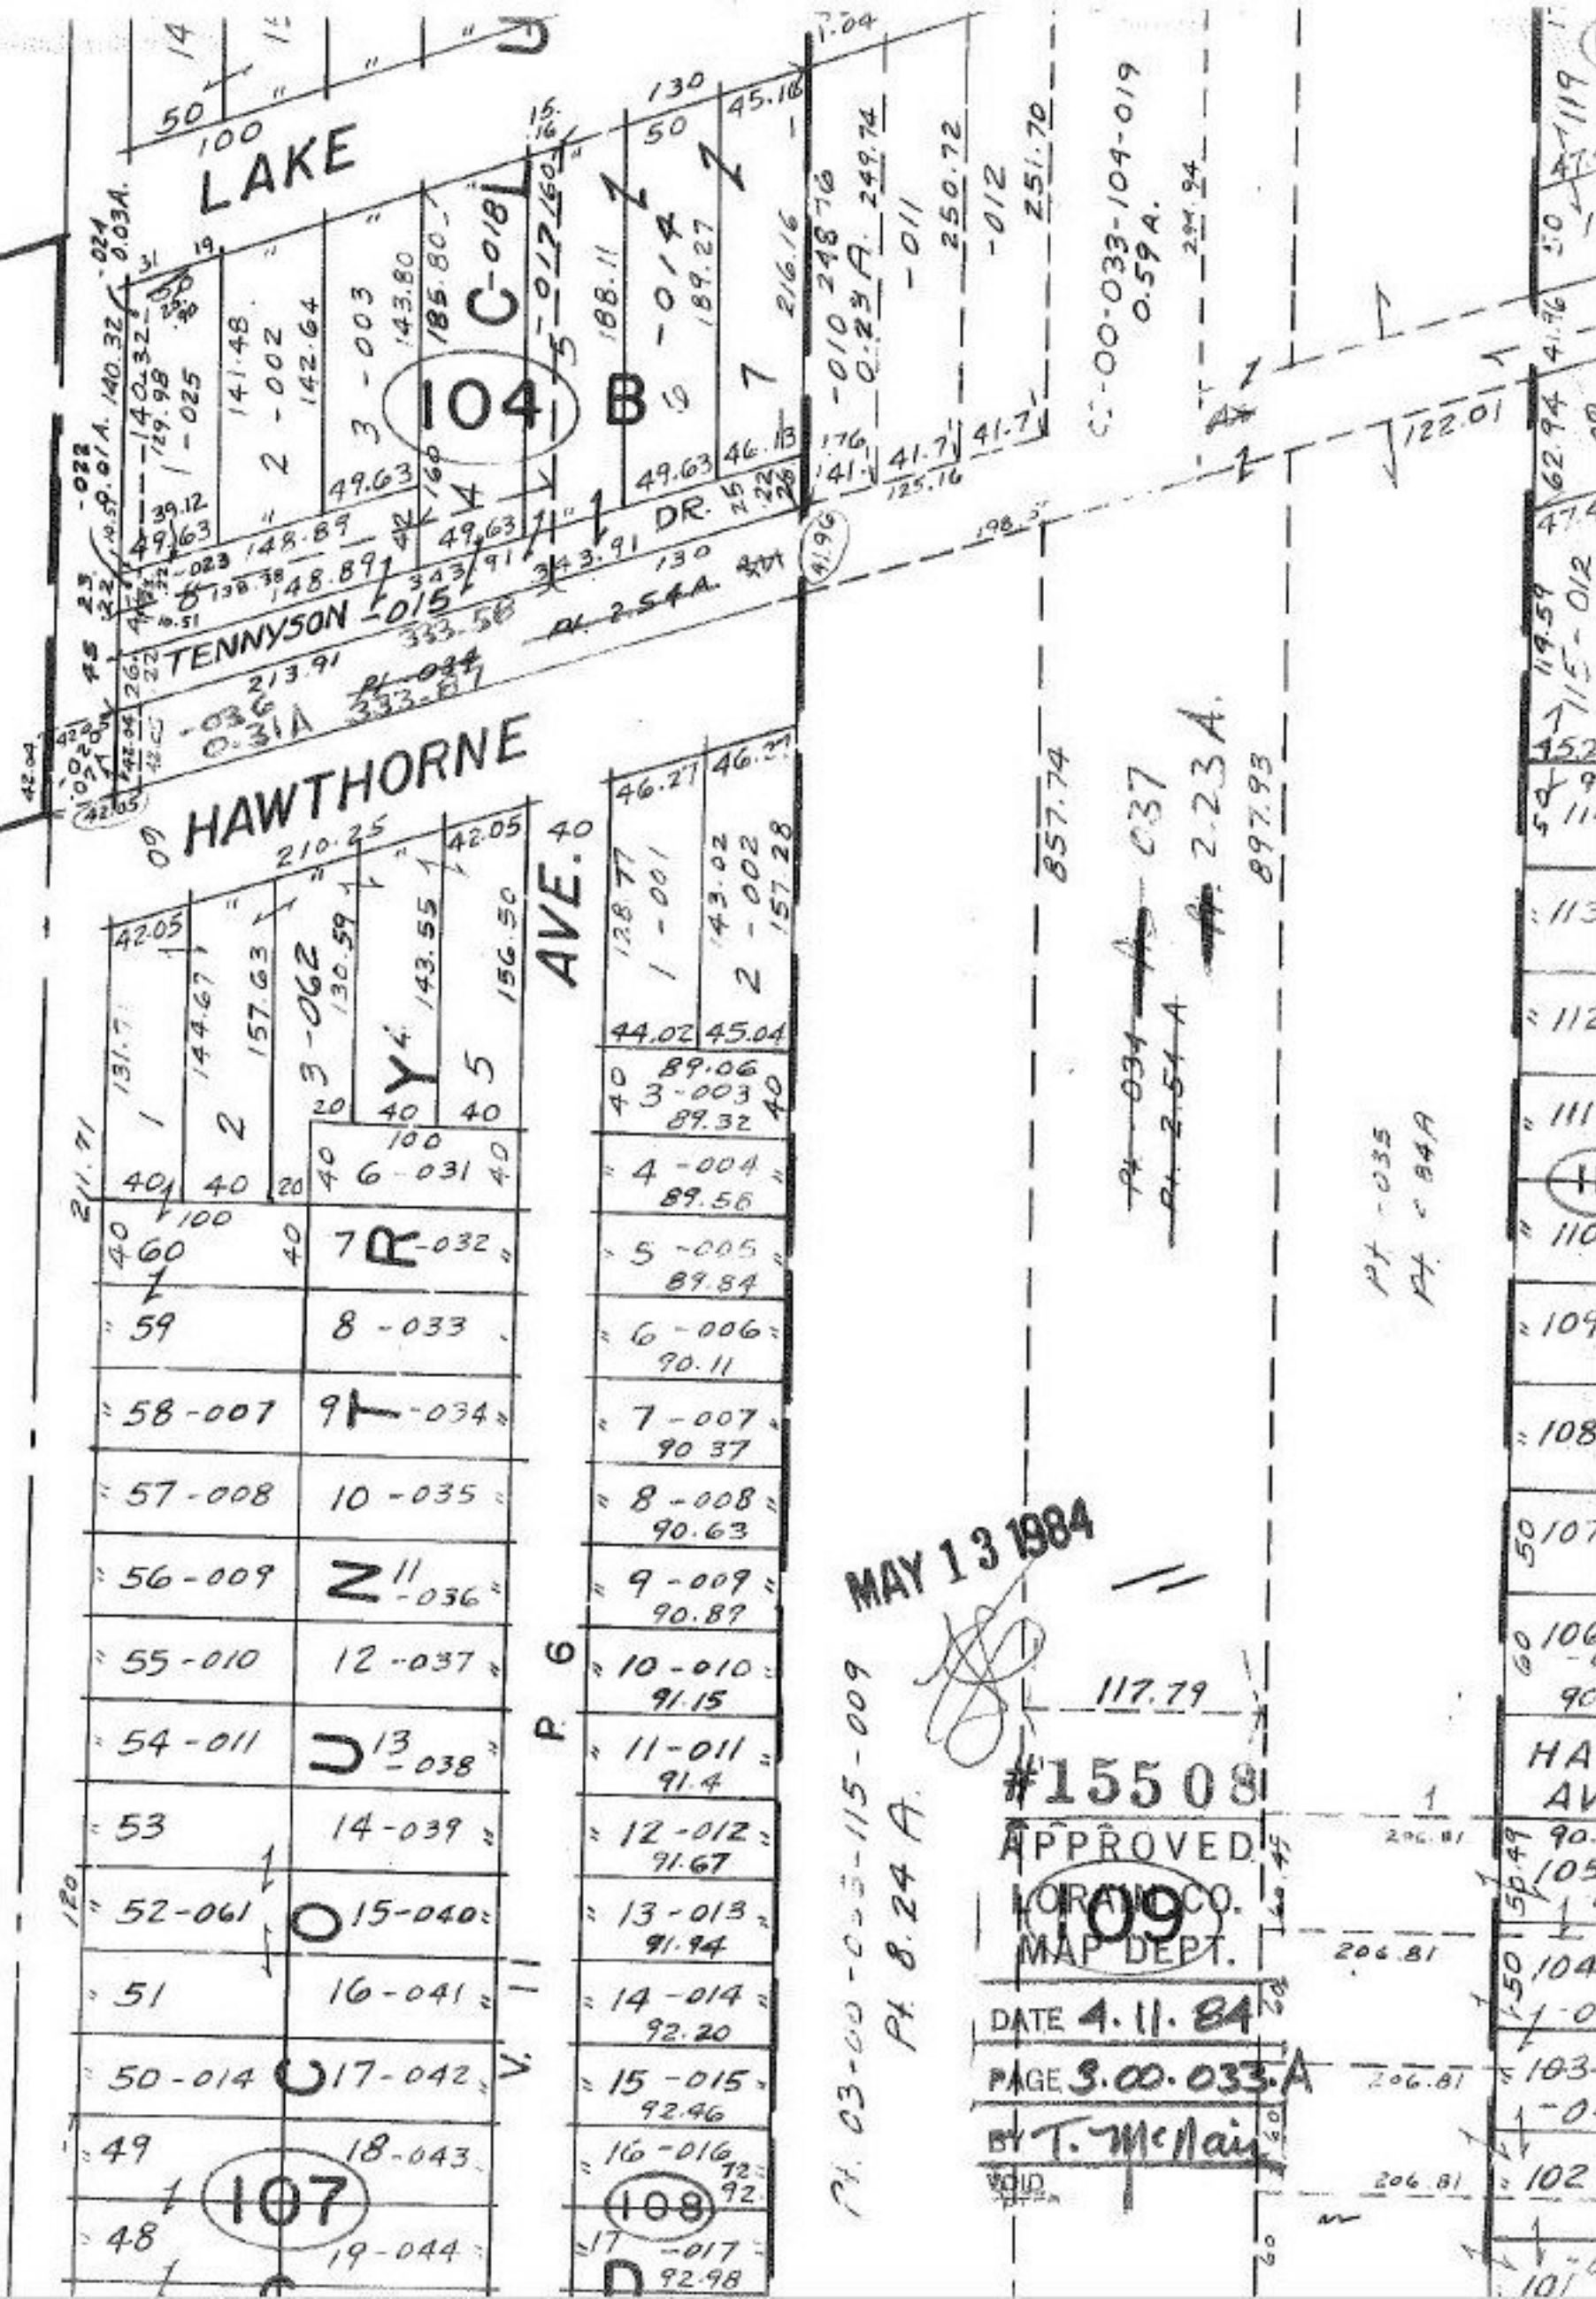

48	19-044	108	92.98
49	18-043	107	92.92
50-014	17-042	106	92.20
51	16-041	105	92.46
52-061	15-040	104	91.94
53	14-039	103	91.67
54-011	13-038	102	91.4
55-010	12-037	101	91.15
56-009	11-036	100	90.87
57-008	10-035	99	90.63
58-007	9-034	98	90.37
59	8-033	97	90.11
60	7-032	96	89.84
40	6-031	95	89.56
40	5	94	89.32
40	4	93	89.06
40	3	92	88.77
40	2	91	88.49
40	1	90	88.21

MAY 13 1984

PT. 03-00-033-115-009
PT. 8.24 A.

#15508
 APPROVED
 MORNING CO.
 MAP DEPT.
 DATE 4.11.84
 PAGE 3.00.033.A
 BY T. McLean

PT. 035
PT. 034A

101	101.0
102	101.0
103	101.0
