


LORAIN COUNTY
TAX MAP DEPARTMENT

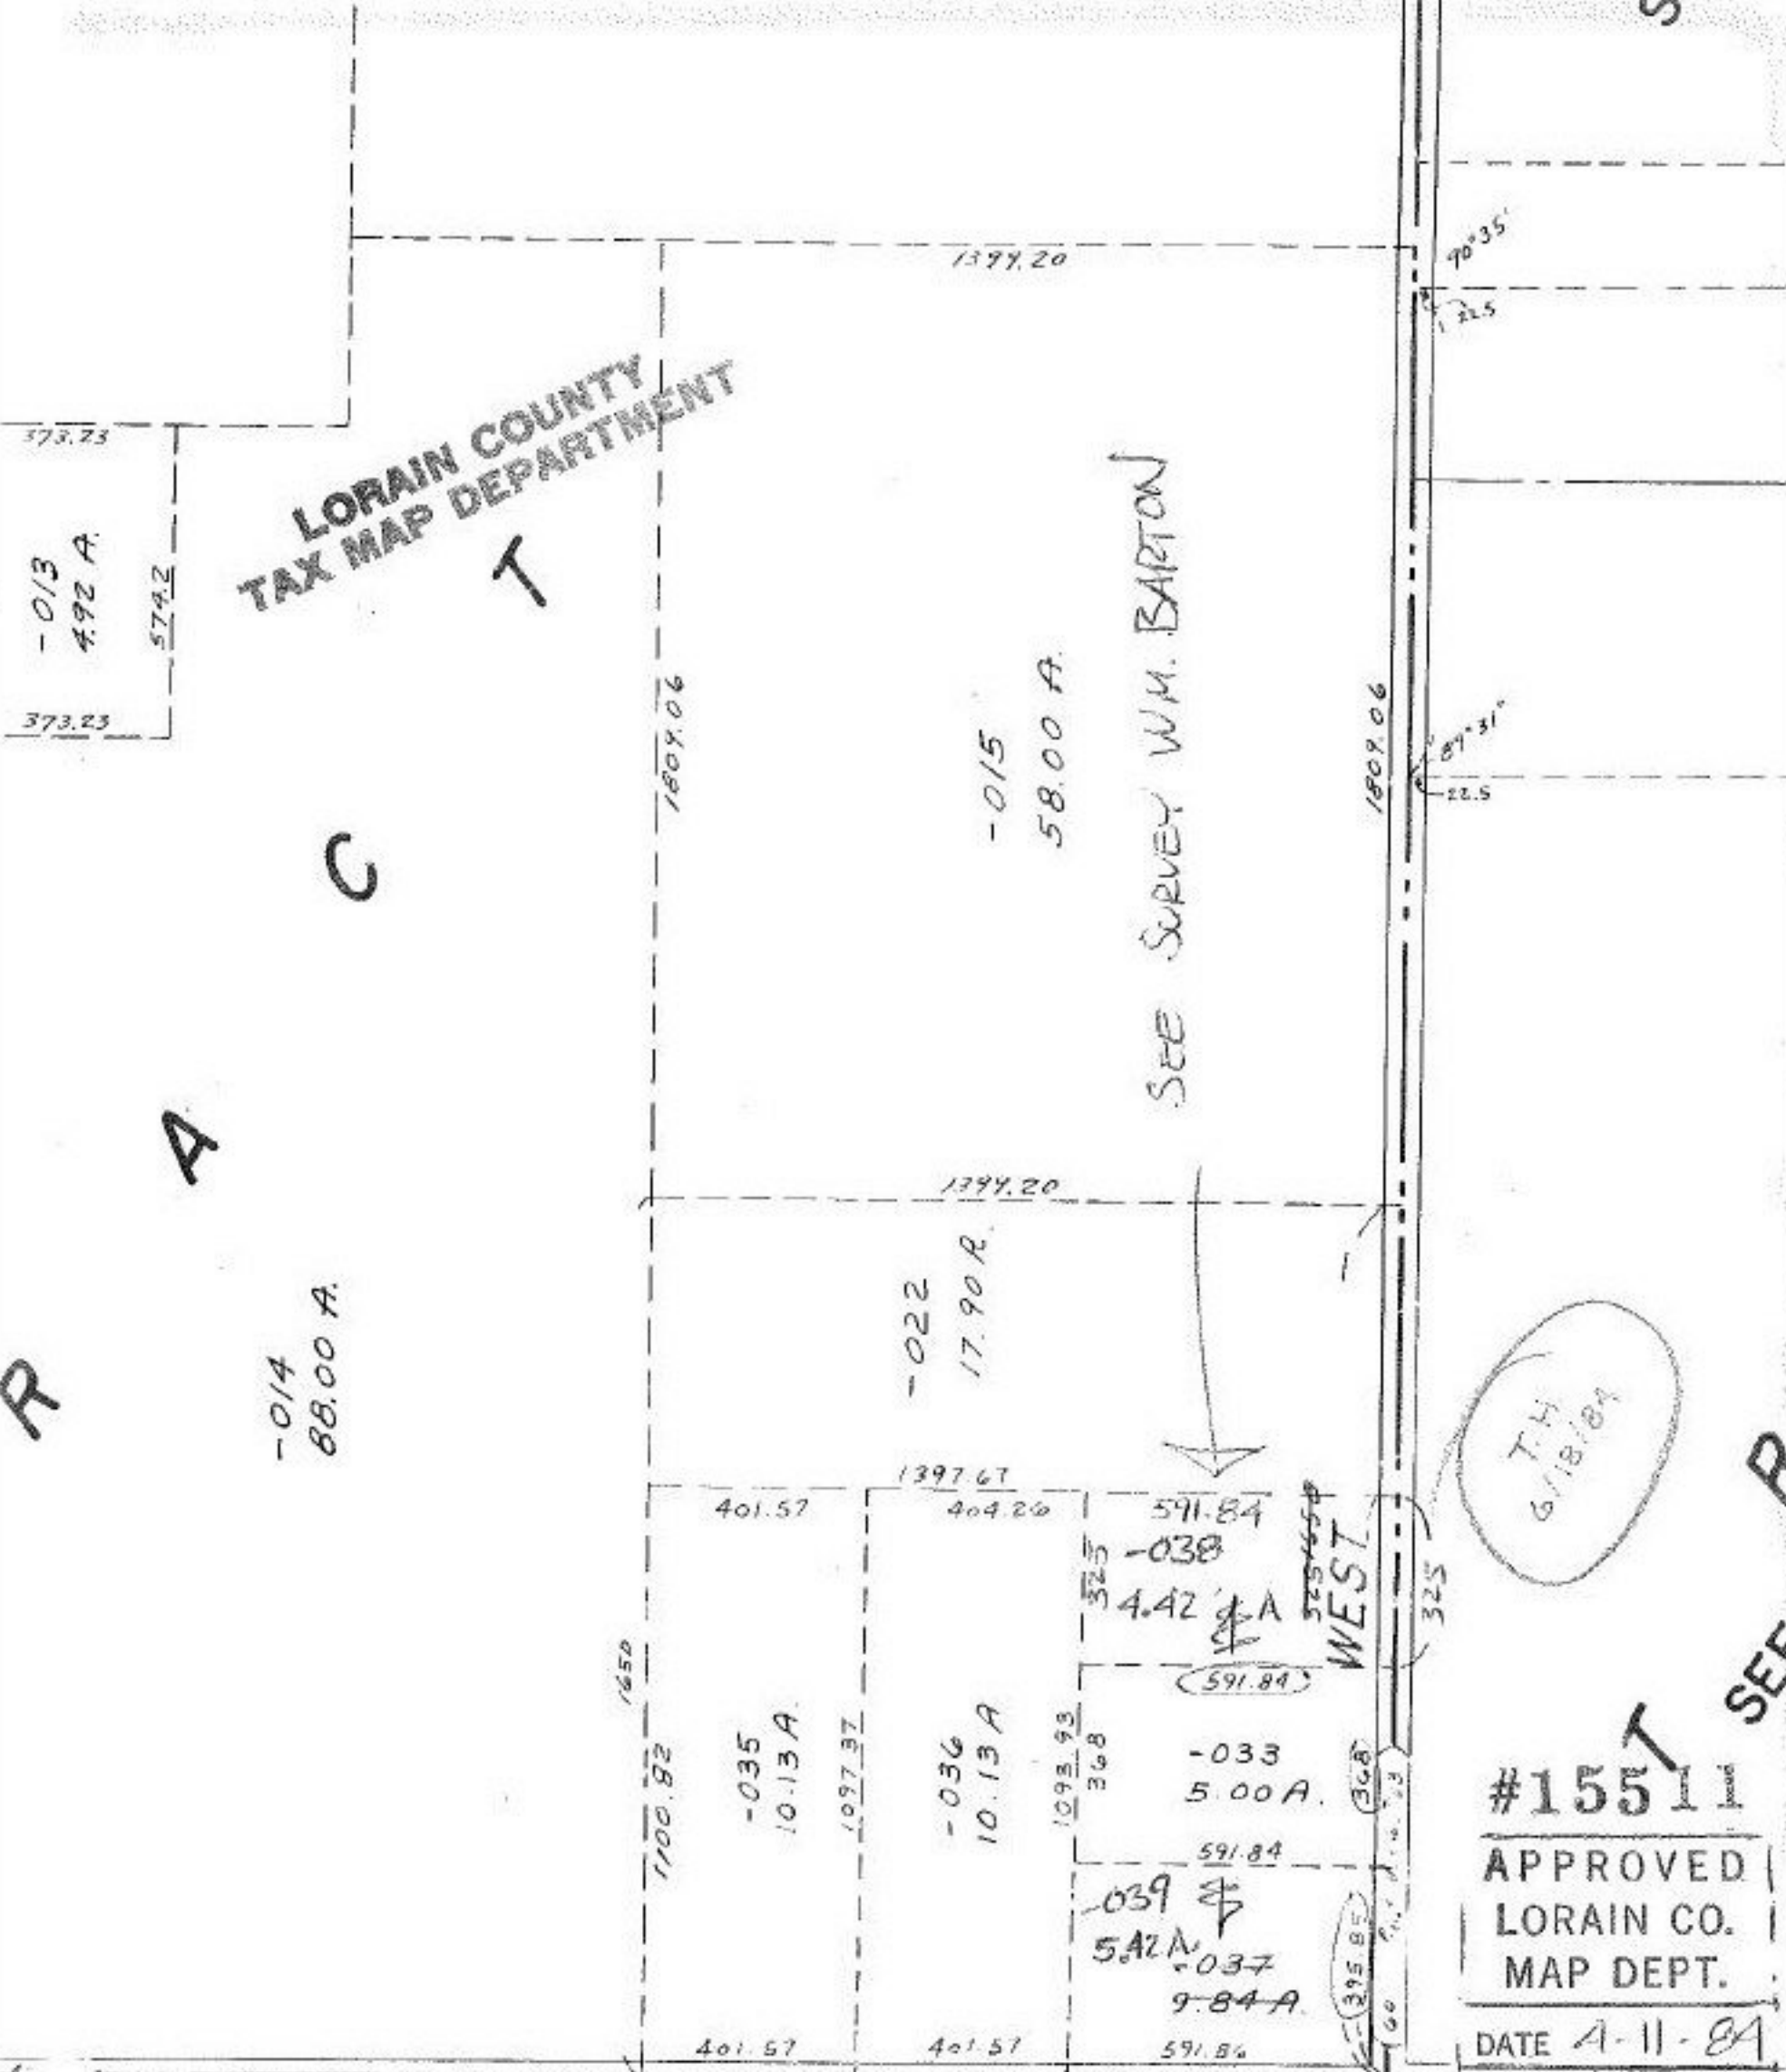

T.H.
6/18/84

#15511
APPROVED
LORAIN CO.
MAP DEPT.

DATE 4-11-84

PAGE 21-D

BY T. McNeil

VOID

ELY PT

TRACT

LONDON - LAFAYETTE

TINGTON TWP.