



3-00-034-A

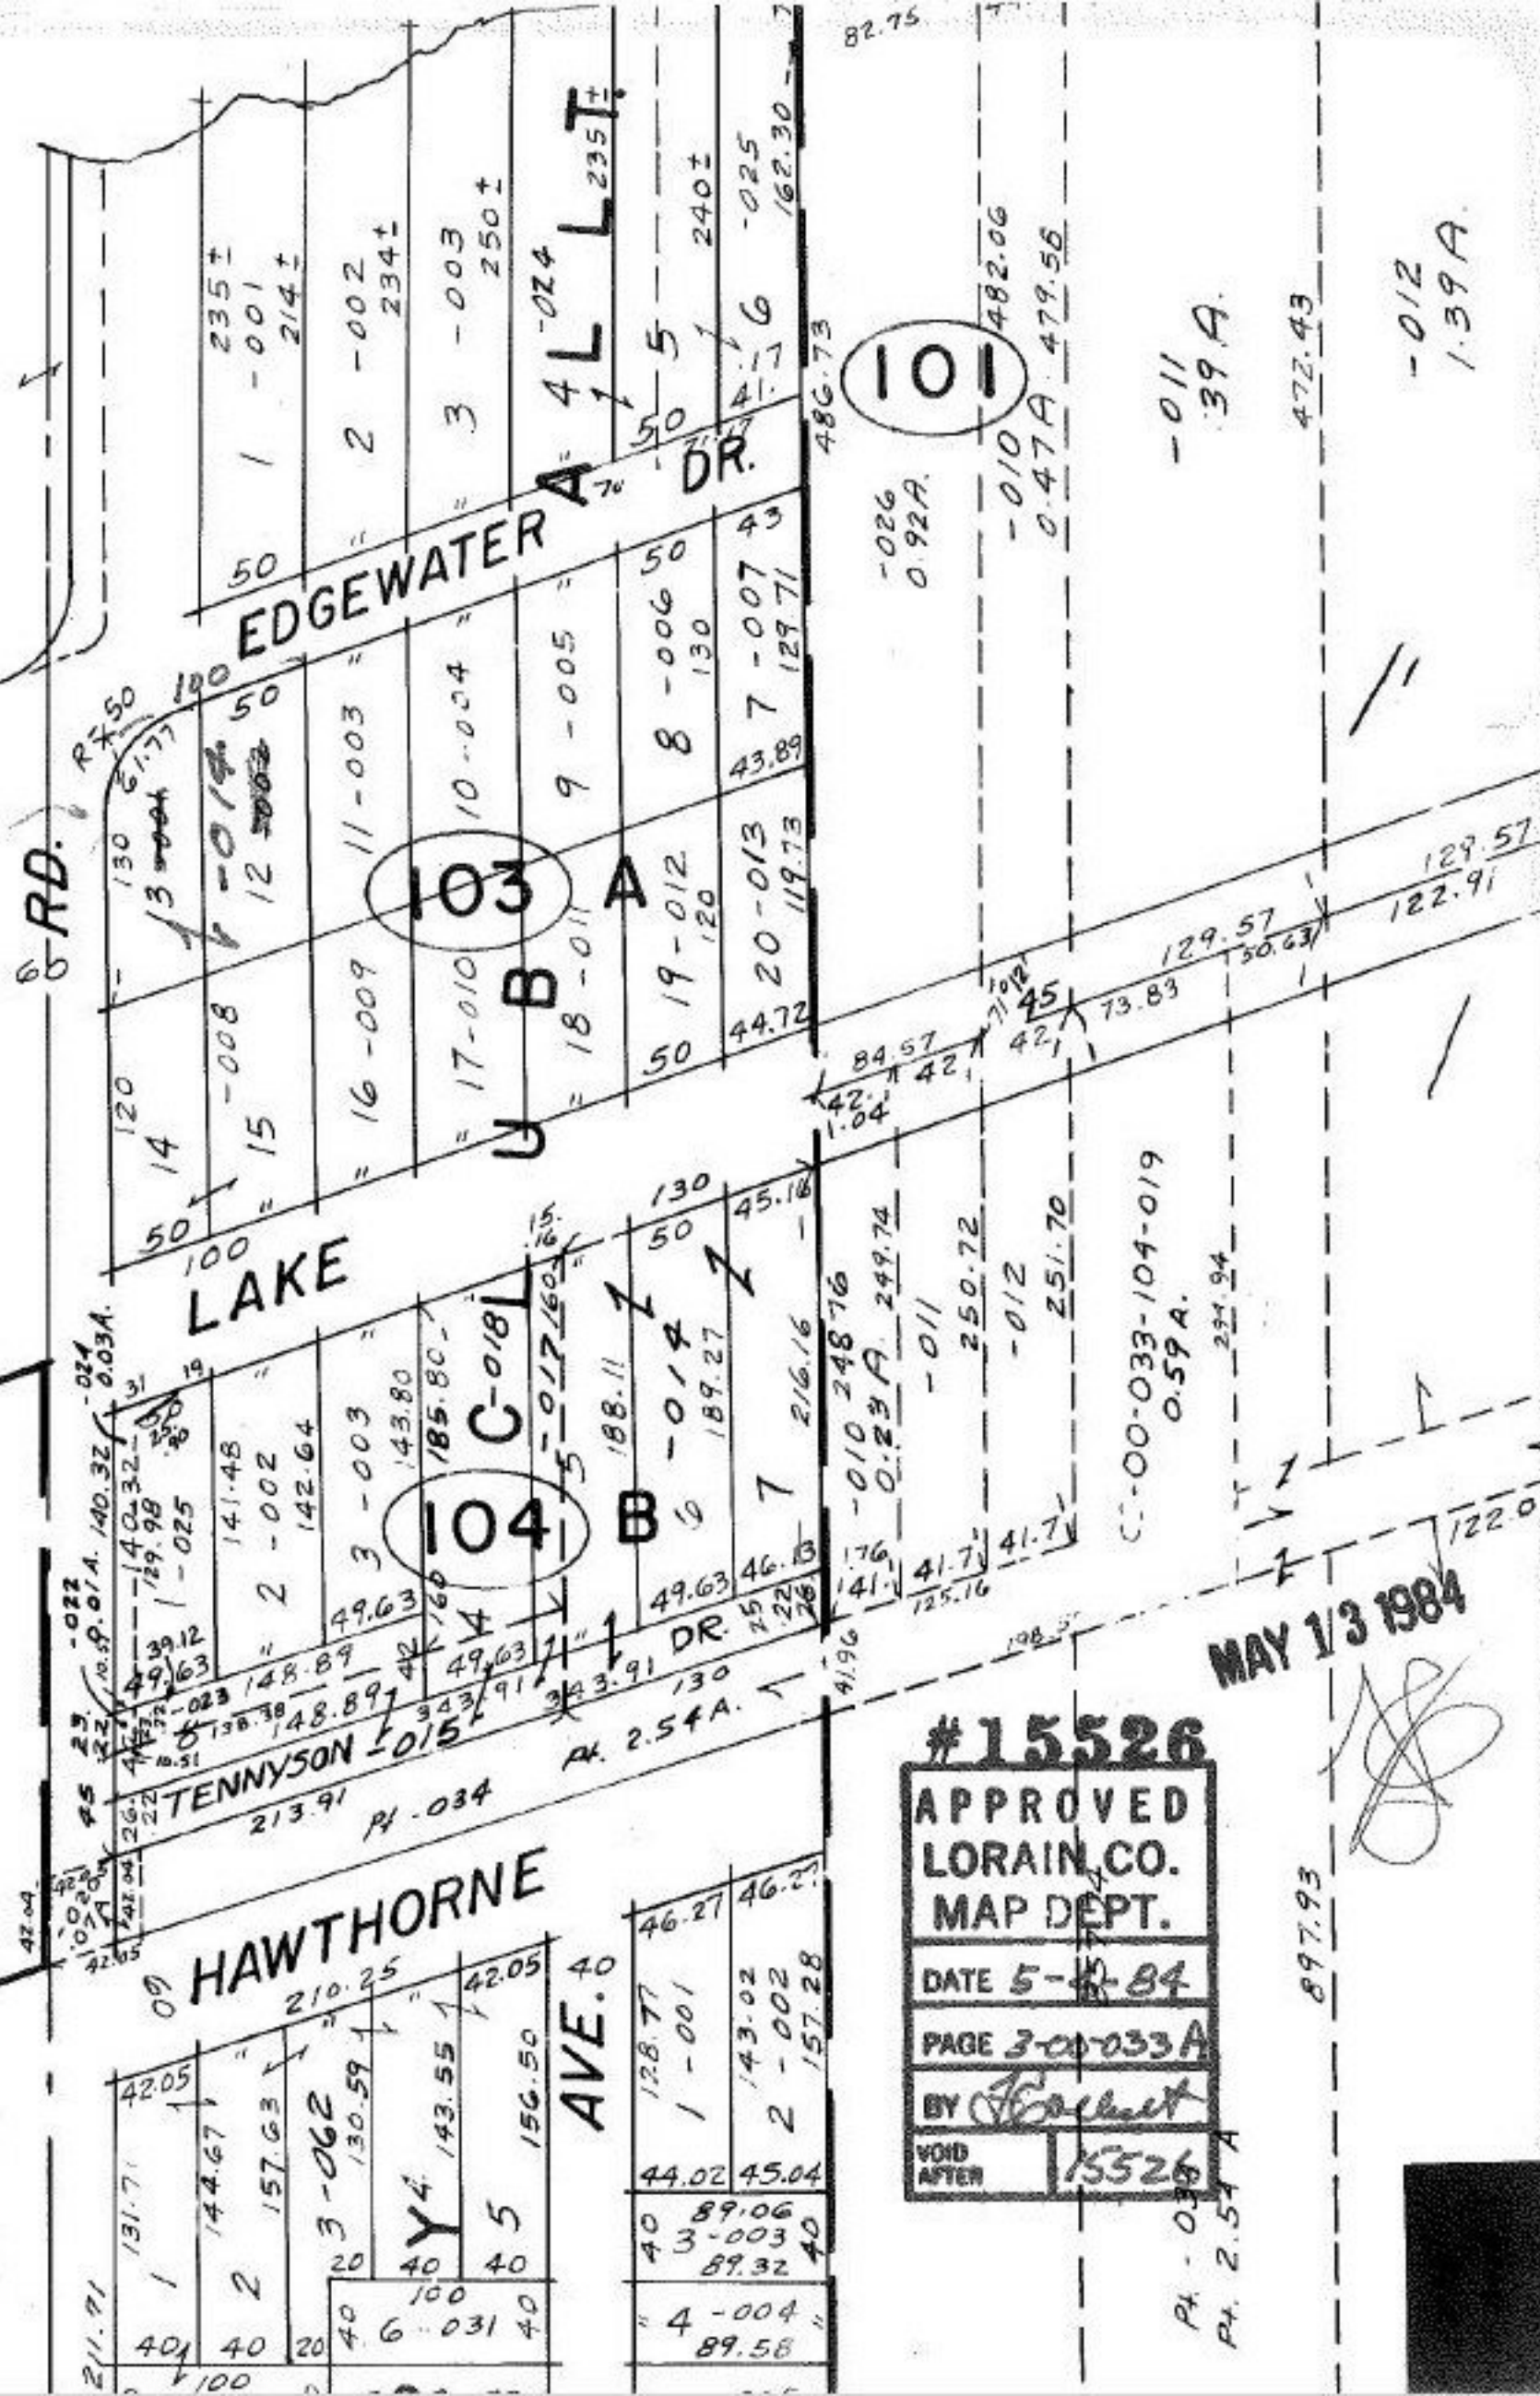

15526

3-00-034-A

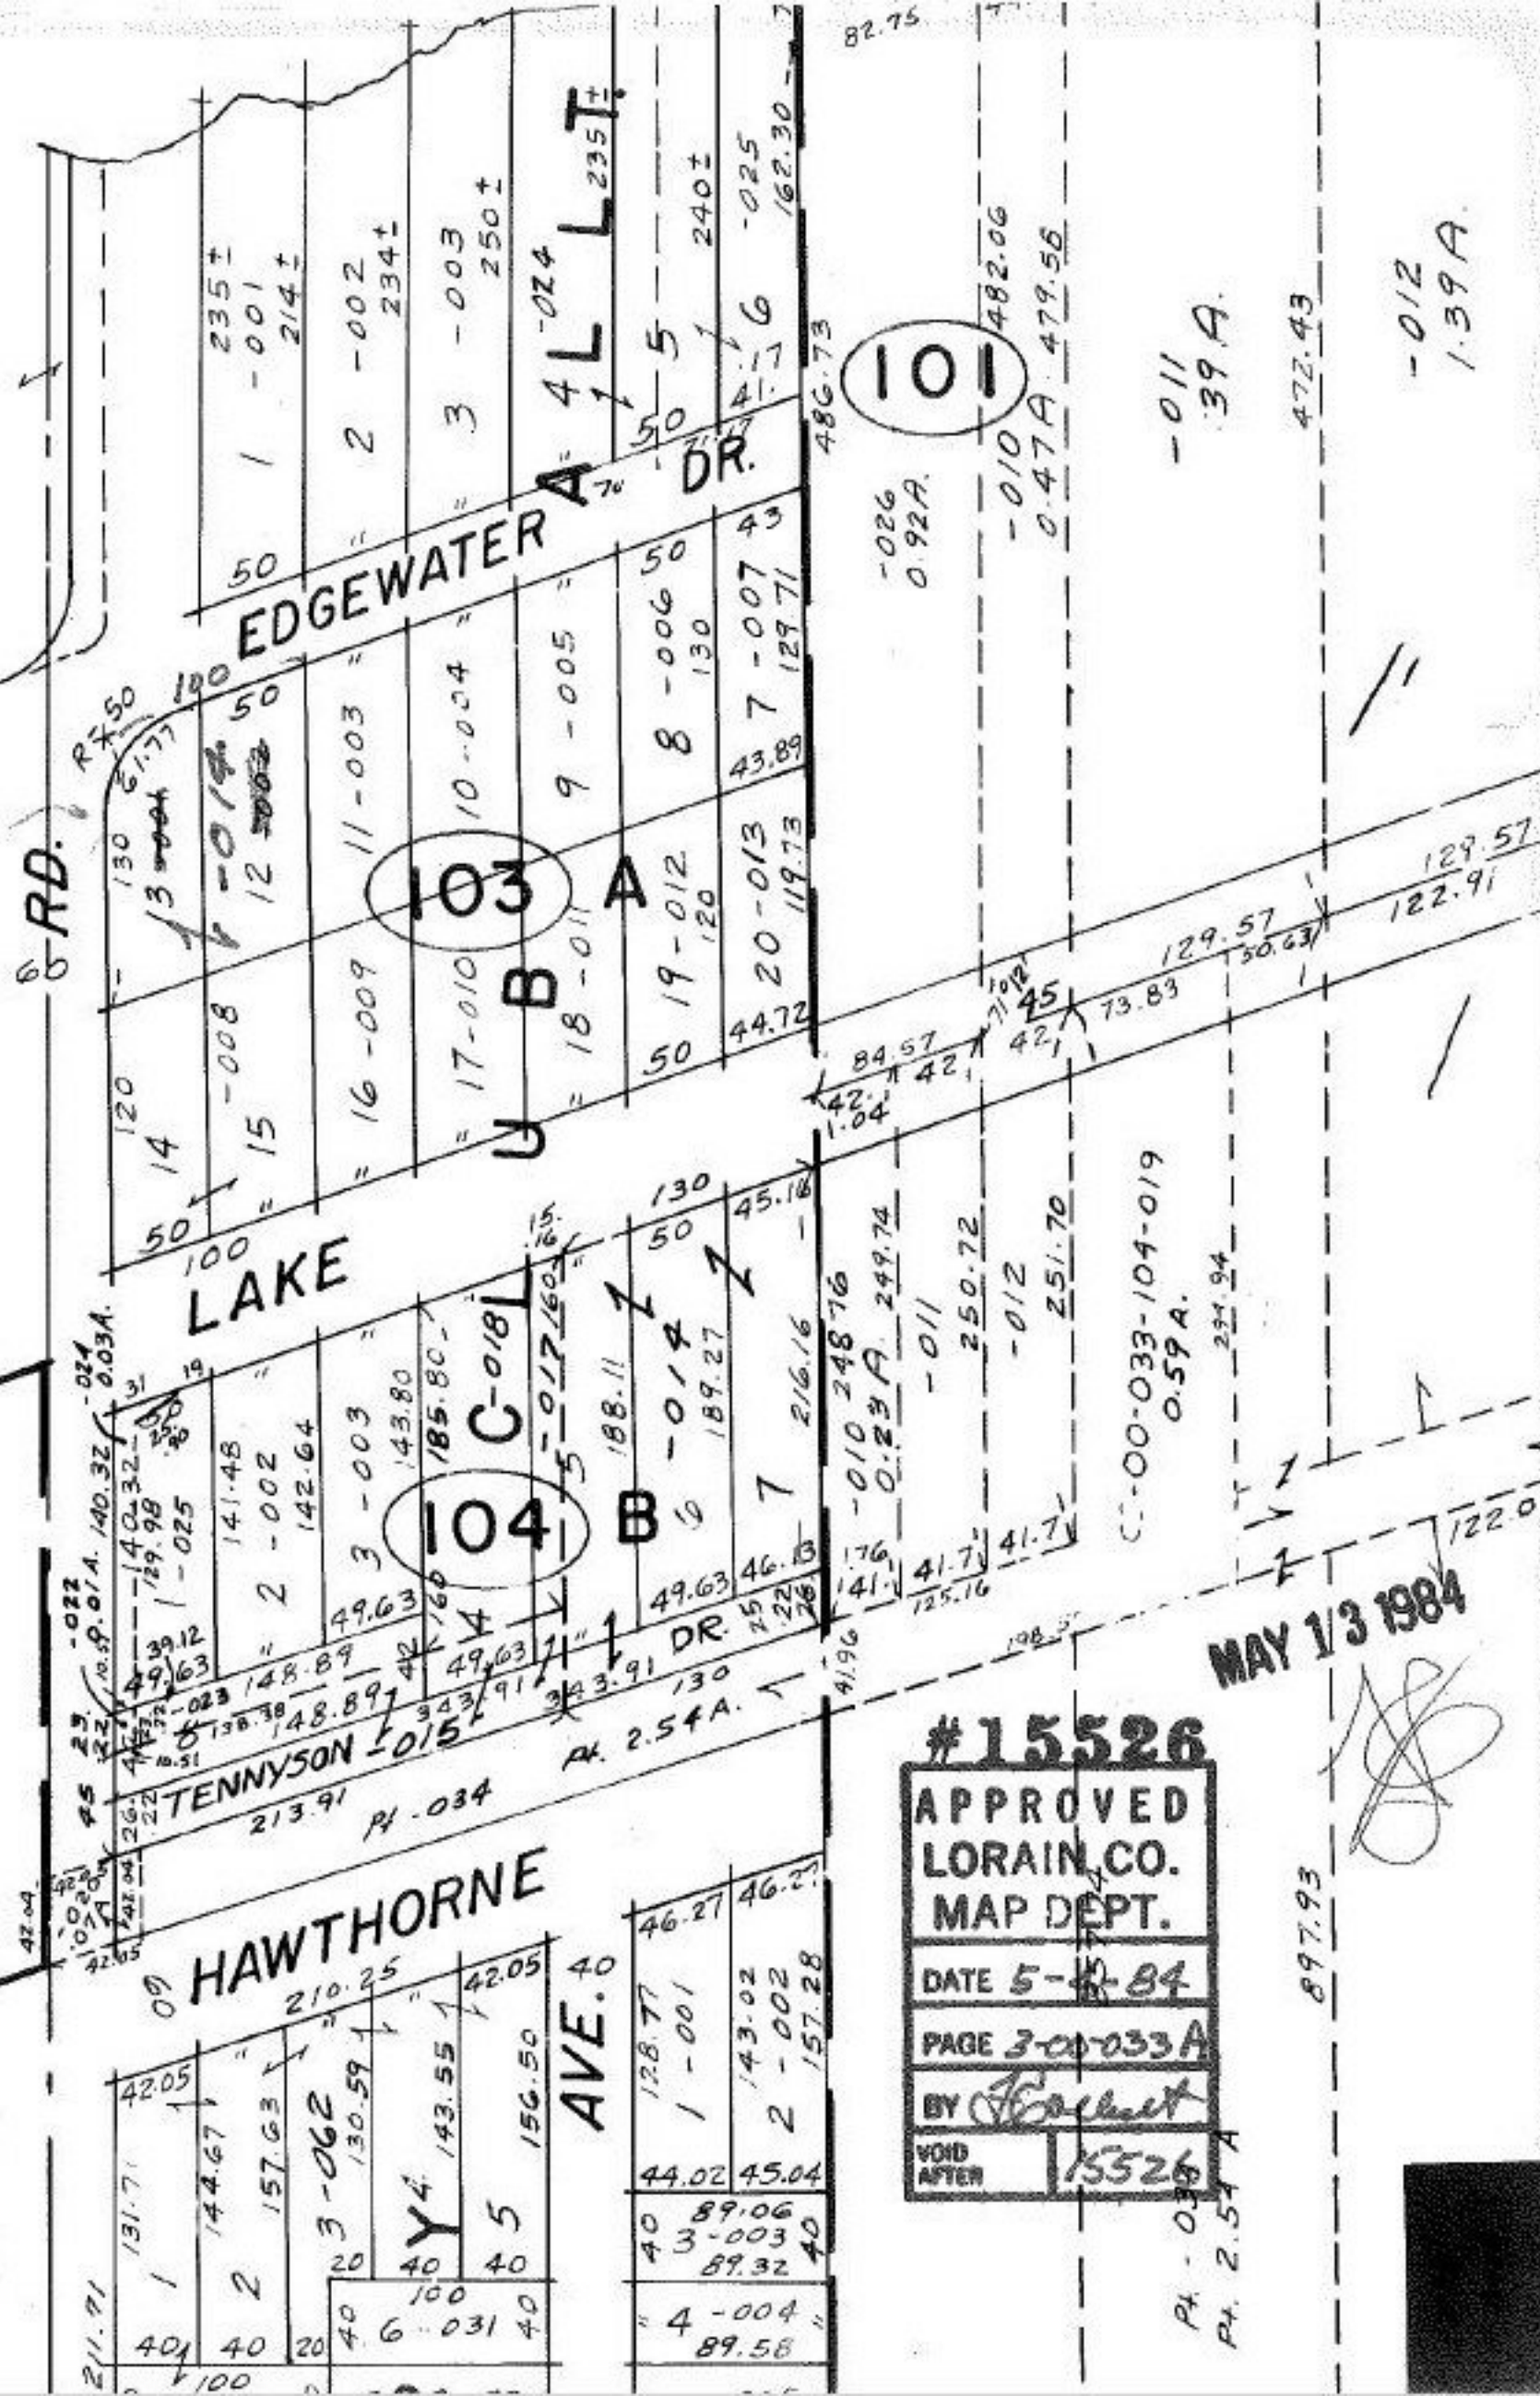

15526

3-00-034-A

15526
 APPROVED
 LORAIN CO.
 MAP DEPT.
 DATE 5-18-84
 PAGE 3-00-033A
 BY [Signature]
 VOID AFTER 15526

MAY 13 1984

897.93

Pt. 2.54A

-012
1.39A

472.43

-011
39A

101

-026
0.92A

-010
0.47A
482.06
479.56

486.73

50 19-012 120
50 8-006 130
43.89 7-007 43
129.71
44.72 20-013 119.73

84.57
42.1
42.1
73.83

129.57
50.63
122.91

45

C-00-033-104-019
0.59A
294.94

122.01

A-4L-024L235T

U B A

103

104

C-018L

B Z

AVE. 40

Y4

HAWTHORNE

LAKE

EDGEWATER DR.

6 RD.

42.05

131.71

144.67

157.63

210.25

42.05

130.59

143.55

156.50

46.27

46.27

89.06

89.32

89.58

40

40

