


MAY 13 1984

15535

APPROVED
LORAIN CO.
MAP DEPT.
DATE 4-30-84
PAGE 3-00-040
BY <i>Hall</i>
VOID AFTER 15535

SEE 3-00-041

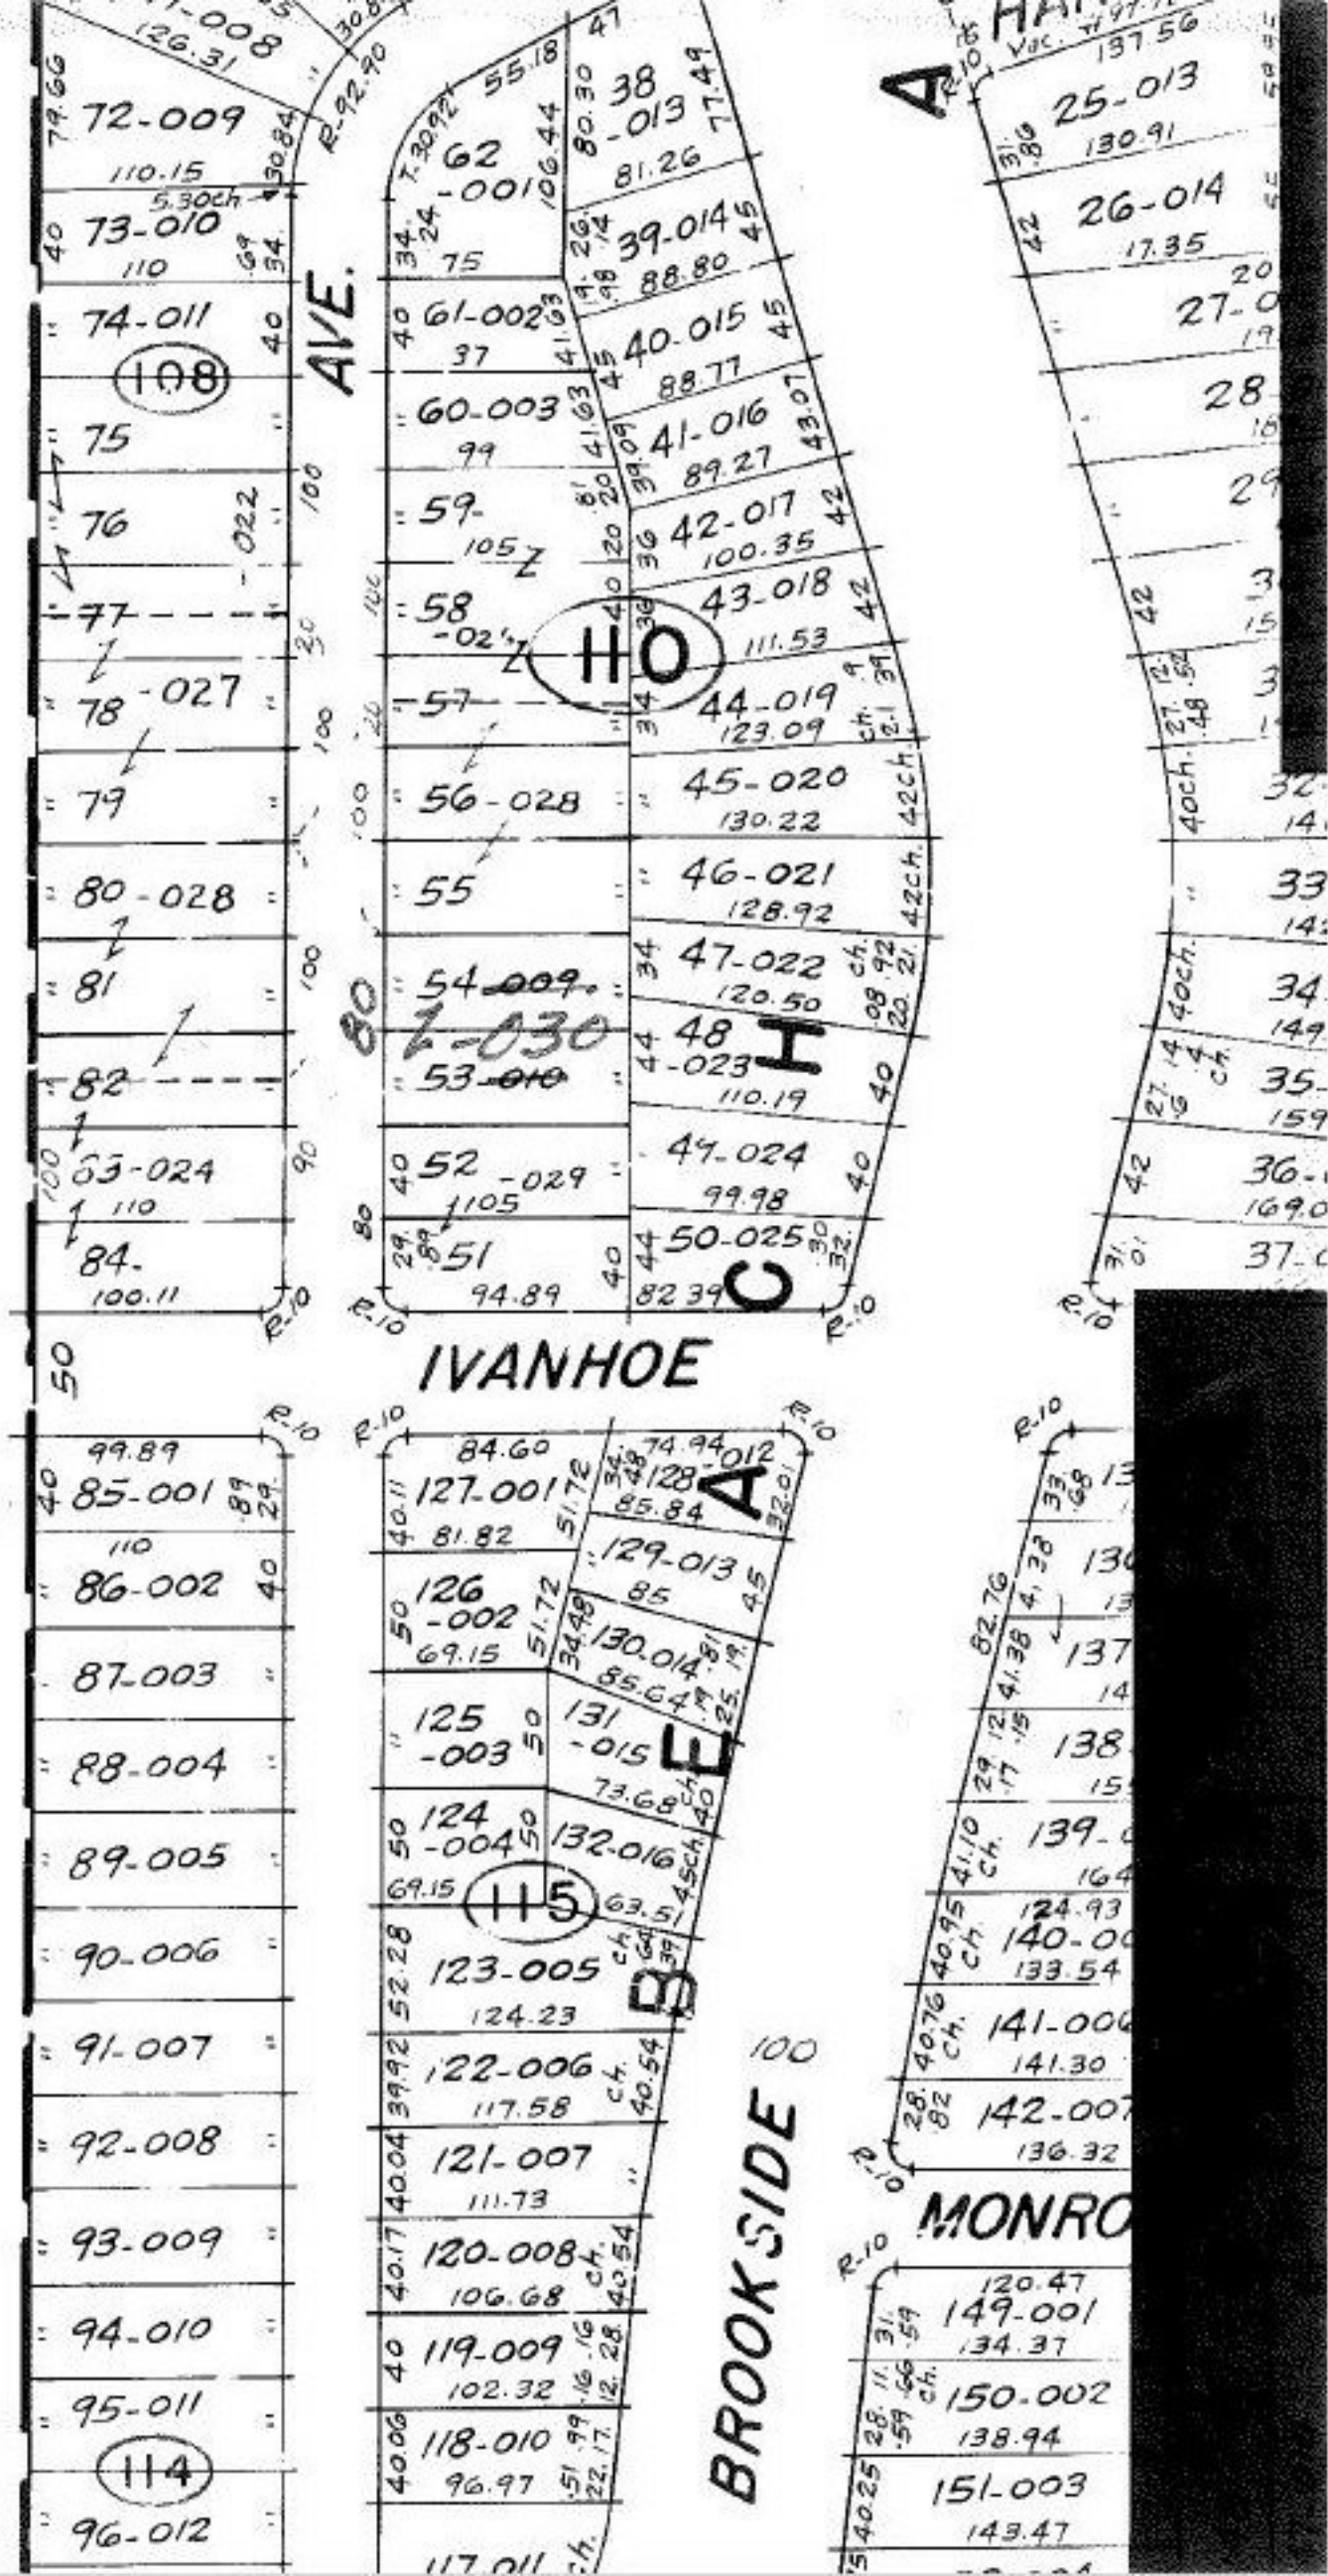

5/1/84