

ROAD RECORD


180 01  
-015  
180  
-016  
-017  
-018  
-019  
-020  
-021  
-022  
-023  
-024  
-025  
-026

ALLOT

PG. 85

RIDGE

RD. 1.65 A. Pt 1.65 A. 00-008-900-001

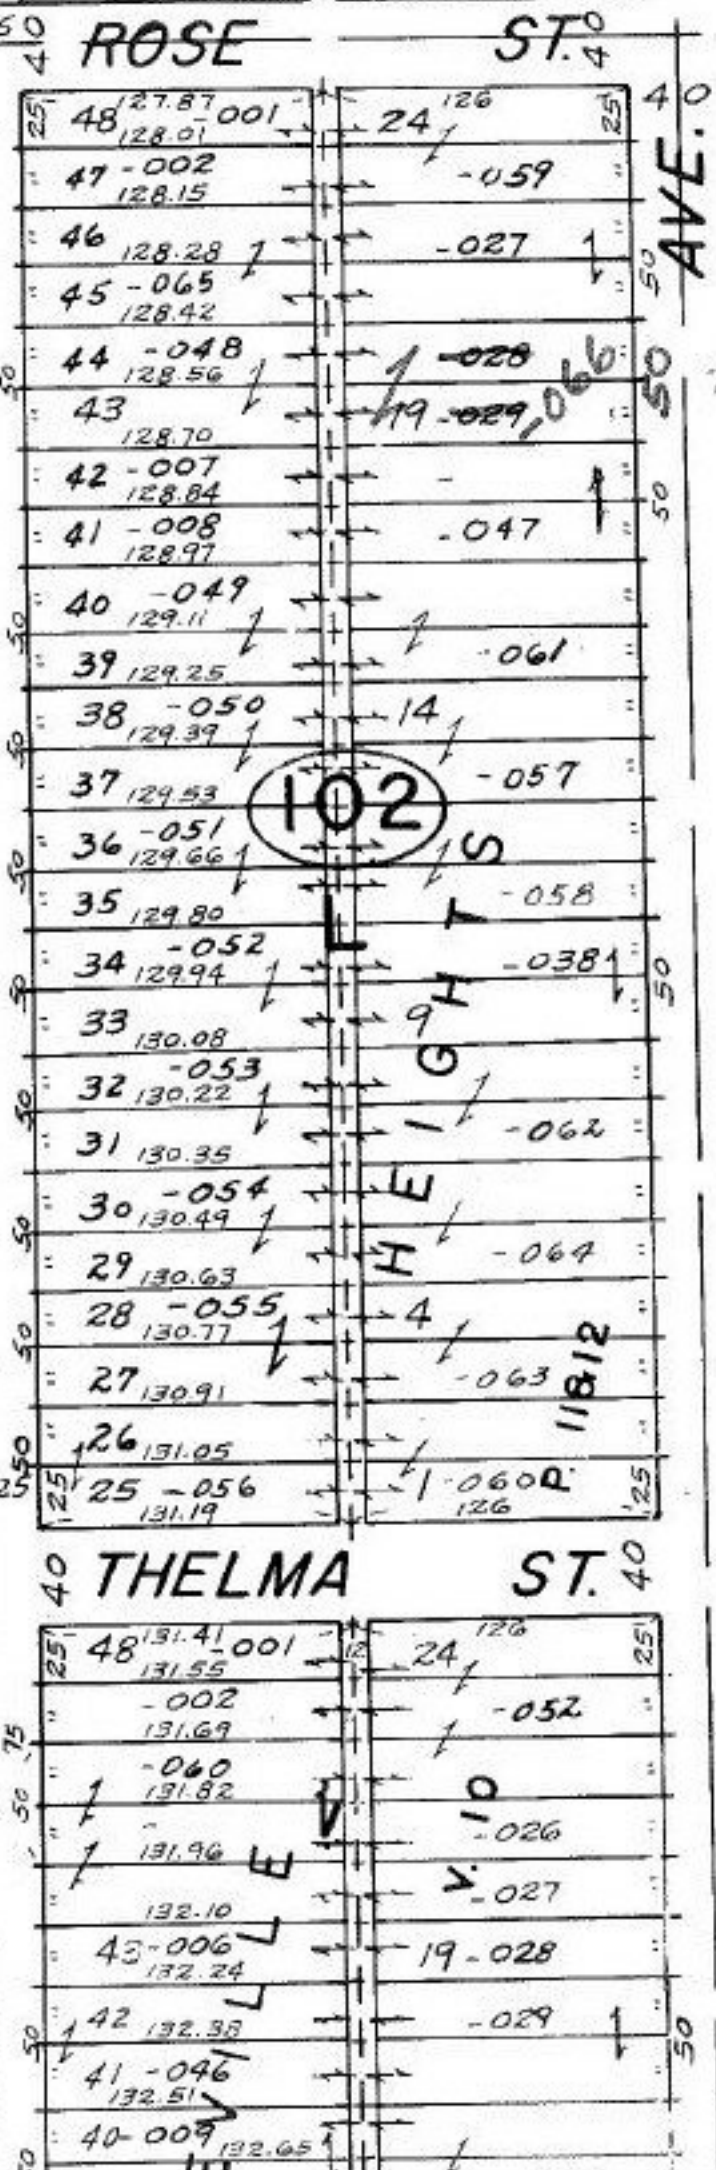

SEE 7-00-008-B

#15539

APPROVED  
LORAIN CO.  
MAP DEPT.

DATE ~~4-30-84~~ 5-7-84

PAGE 7-00-008A

BY *Rollins*

SEND AFTER 15539

6-25-85  
10-10-85