


SEE SURVEY - A. ROEPP

11953
9/3.44

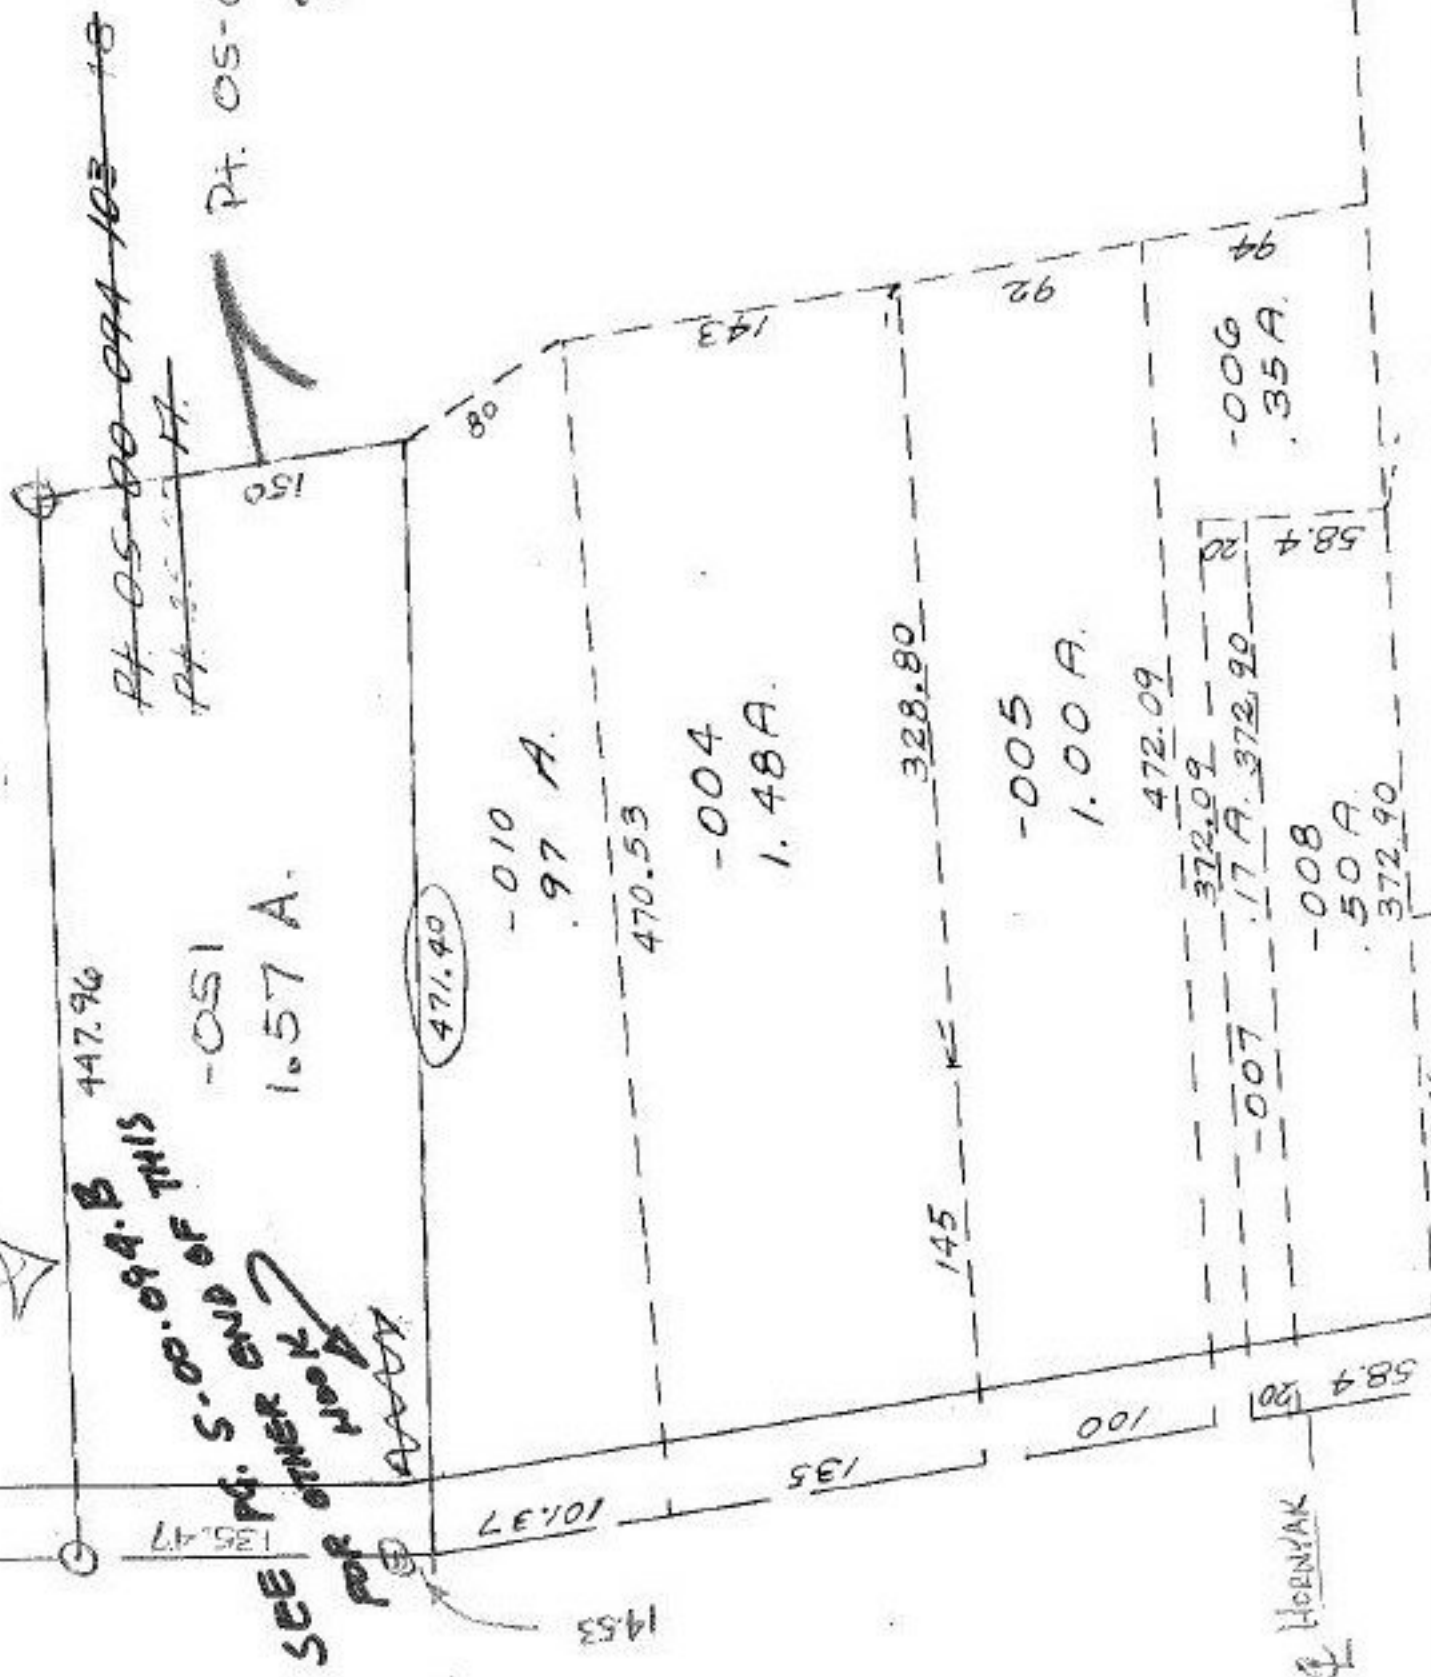

#15563

APPROVED
LORAIN CO.
MAP DEPT.

T.M.
7.18.85

DATE 5.16.84
PAGE 5.00.094-C

BY T. McMain
VOID
VETER

762.96

447.96

135.47

-051

1.57 A.

471.90

-010
97 A.

470.53

-004
1.48 A.

328.80

-005
1.00 A.

472.09

372.09

17 A. 372.90

-007

-008

50 A.

372.90

-006
35 A.

58.4

58.4

198.95

HOBENAK

58.4 20

100

135

1453

101.37

150

80

143

92

94