


OHIO

145'

+35

1198.77

13.5

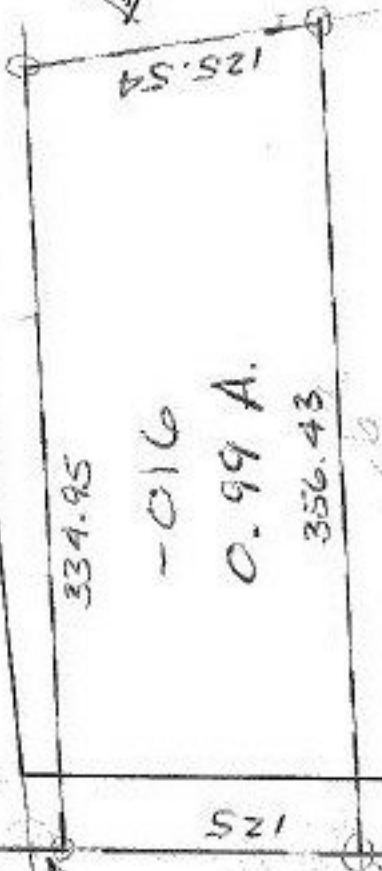

SEE SURVEY
A. KOEPP

-017

~~011~~
~~9.31 A.~~

8.32 A.

105

445.75
138.50

307.25

SEE 5-00-094-B 654 TO HOM. BOX

SEE 5-E

#15563

APPROVED
LORAIN CO.
MAP DEPT.

DATE 5.16.84

PAGE 5-00-094-C

BY T. McMain
VOID
VETER

T.M.
7.18.85

1195.3
9/3.44