


20-5
25-5

~~024~~
~~19.00A~~
-040
10-28A

H1557
APPROVED
LORAIN CO.
MAP DEPT.
DATE 2-19-68
4-00-028-F
BY *D. Maynard*

7-15-86LL

(Signature)

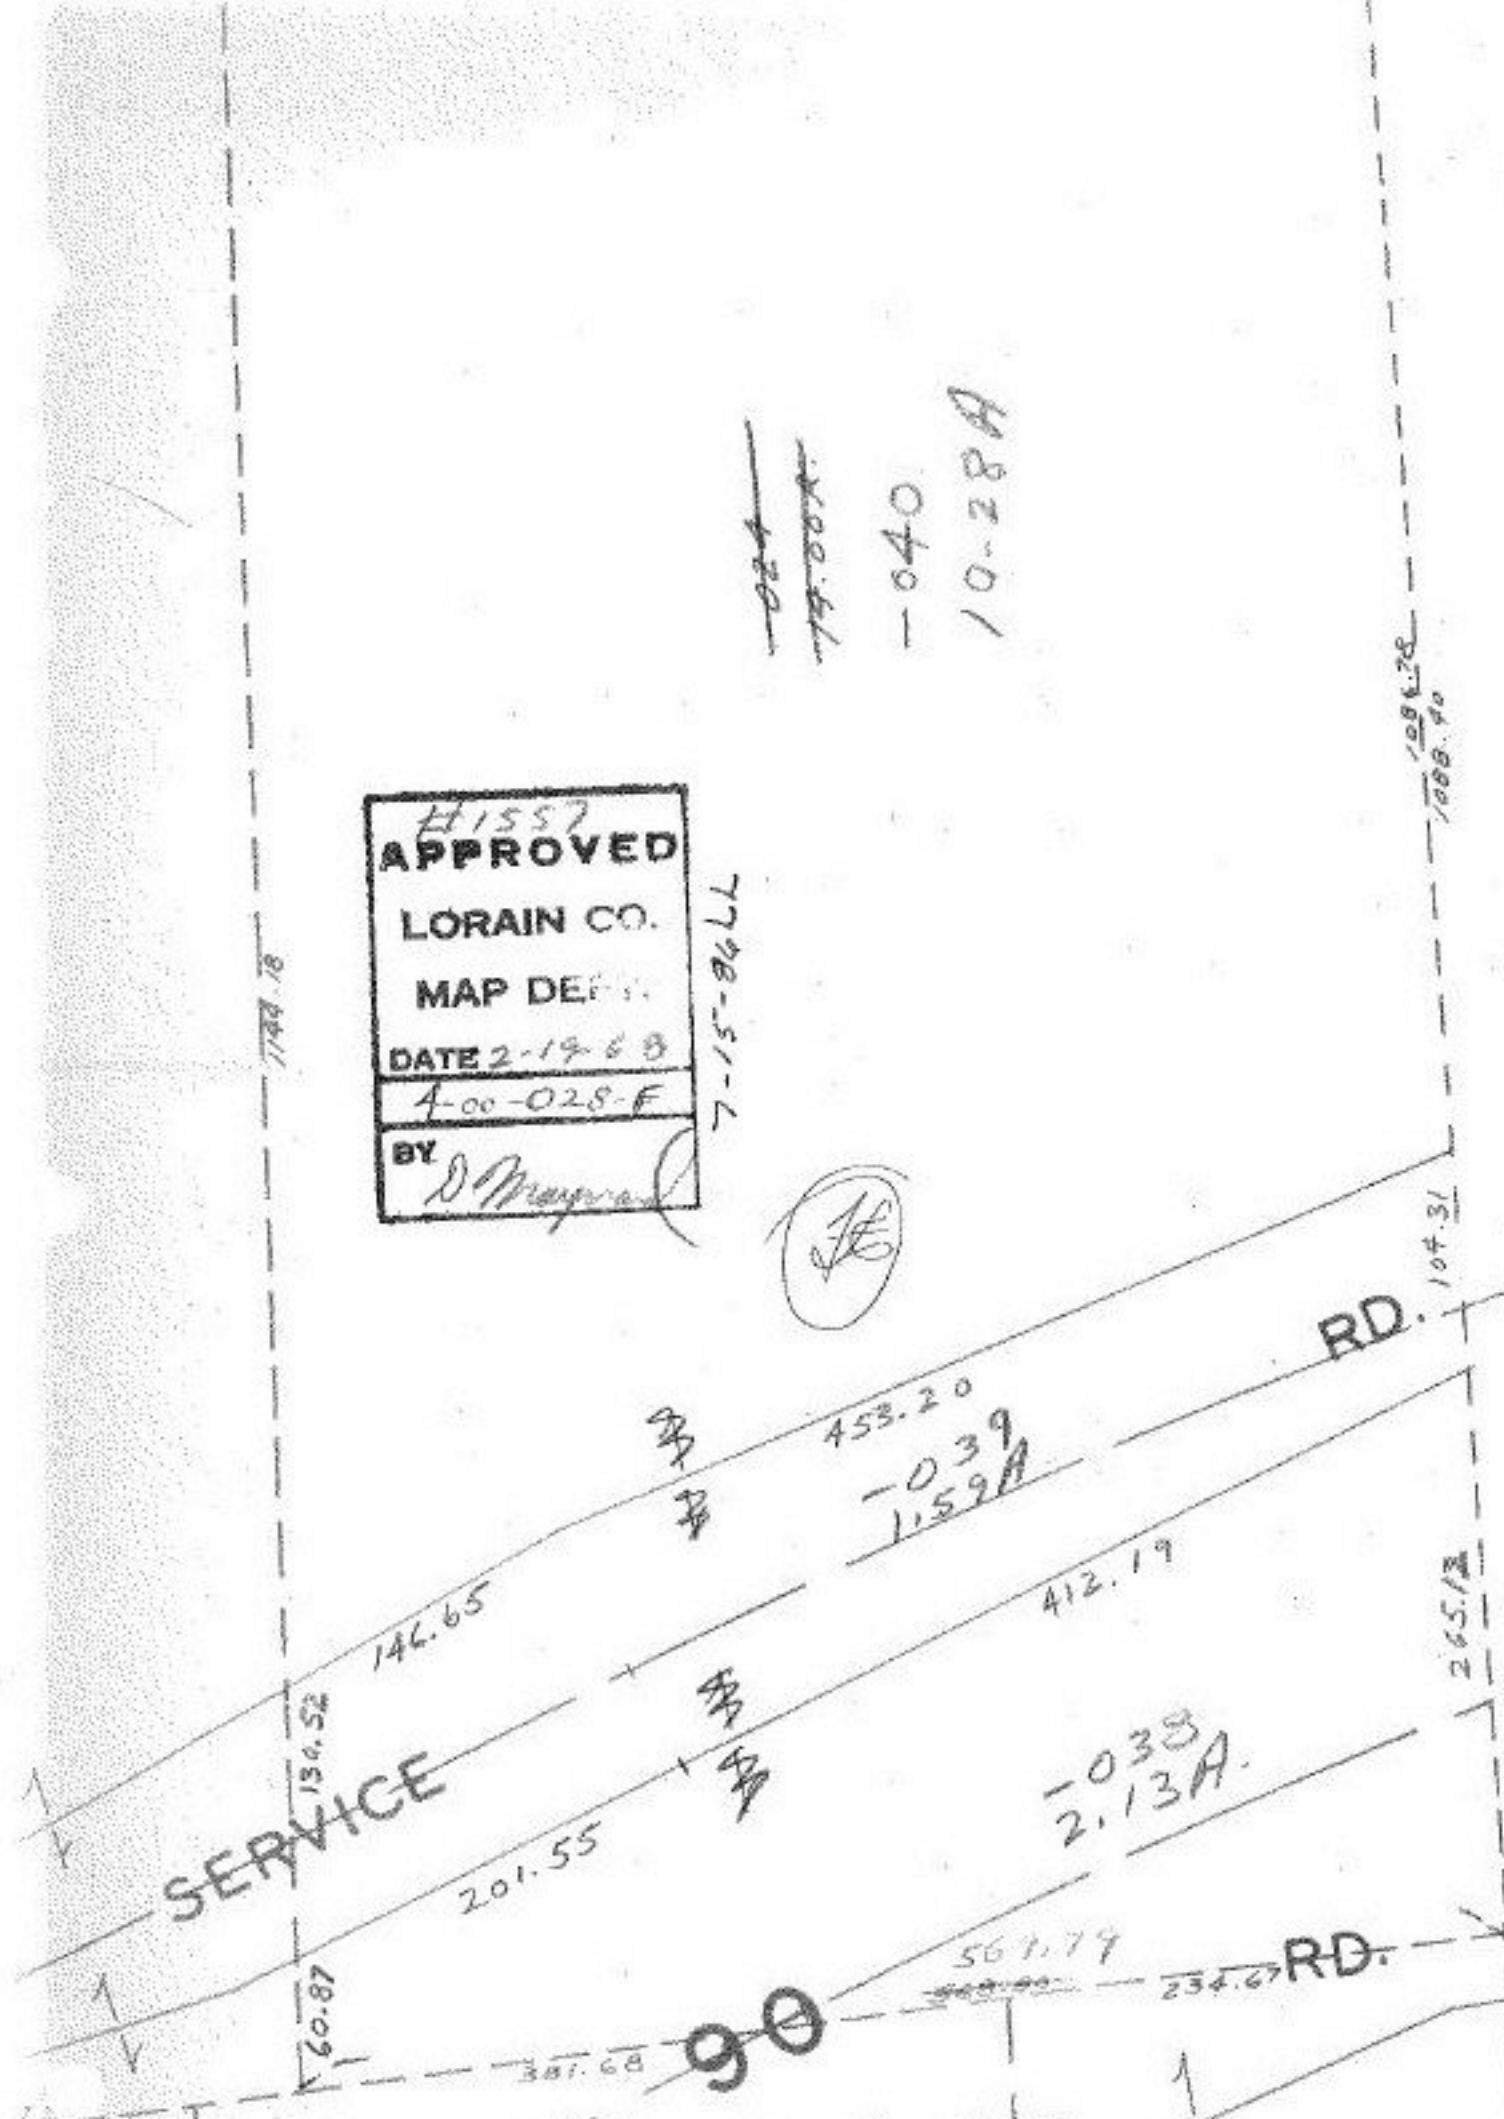

DONE 5-4-68
FRANK COLBERT.

SEE 4-00-028-G