


#15592  
#15593

APPROVED	
LORAIN CO.	
MAP DEPT.	
DATE	6-12-84
PAGE	4-00-018 J
BY	<i>Forrest</i>
VOID AFTER	15593

1985  
FEB 8

WOOSTER AVON LAKE 220

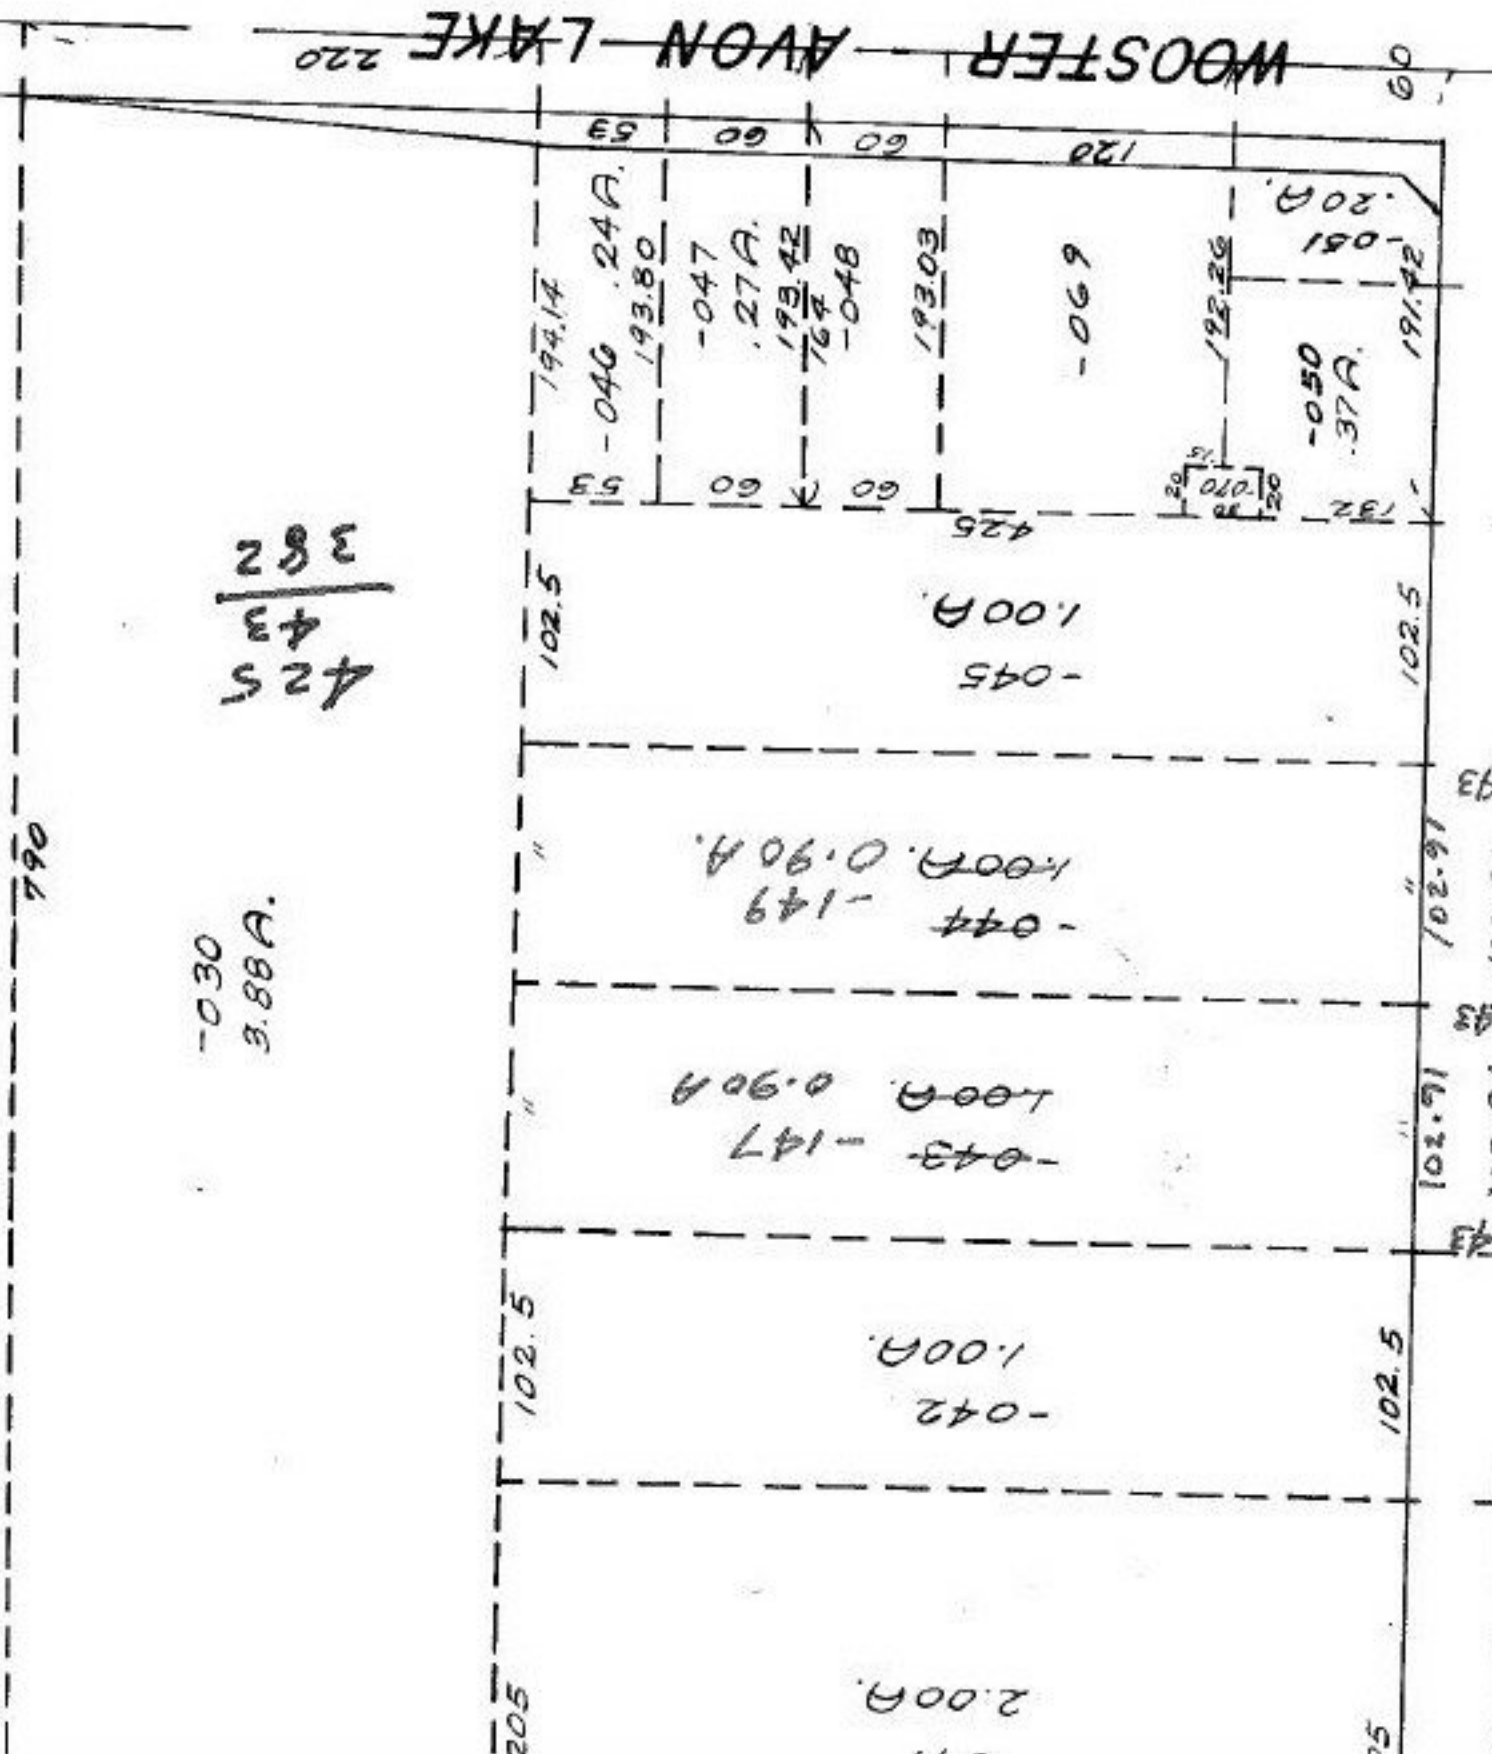

-030  
3.88A.

425  
43  
382

4-00-017-B

Y

-148  
#15593  
-146  
#15592

0.10 A.  
77WD  
0.10 A.  
76WD

E 110