

24648  
BAINBRIDGE

.76 A 3'18" 46"  
CENTERLINE SURVEY PLAT

187.76

-062

185.61


-063  
1.24A.

480.40


-019 153.17  
1.00A.

300

A = 218.63  
R = 50  
 $\Delta = 250^\circ - 31' - 44''$   
Ch = 81.65

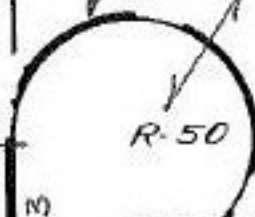

Pt. -061  
~~Pt. 6.65A~~  
Pt. 6.89A.

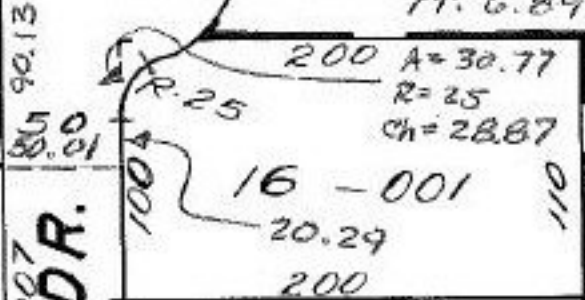

200 A = 30.77  
R = 25  
Ch = 28.87

16 - 001  
20.29  
200

SEE 7-00-022-A

DR. 107A Dup. #1 07-00-022-102-007  
92A Dup. #2 1.76A  
2.00A TOTAL

50

139.43  
115  
110  
110  
110

-002  
-003  
-004

200

12-005  
AXE

ALLT. 80  
279  
164  
-006

101

ROAD VACATION  
SIZE CORRECTION  
#15630

APPROVED	80
LORAIN CO.	
MAP DEPT.	
DATE 7.9.84	
PAGE 7.00-022-B	
BY T. McKain	
VOID	
1.5	
8-30-85	
10-18-85	

103