


Pt 12-00-042-000-

-B

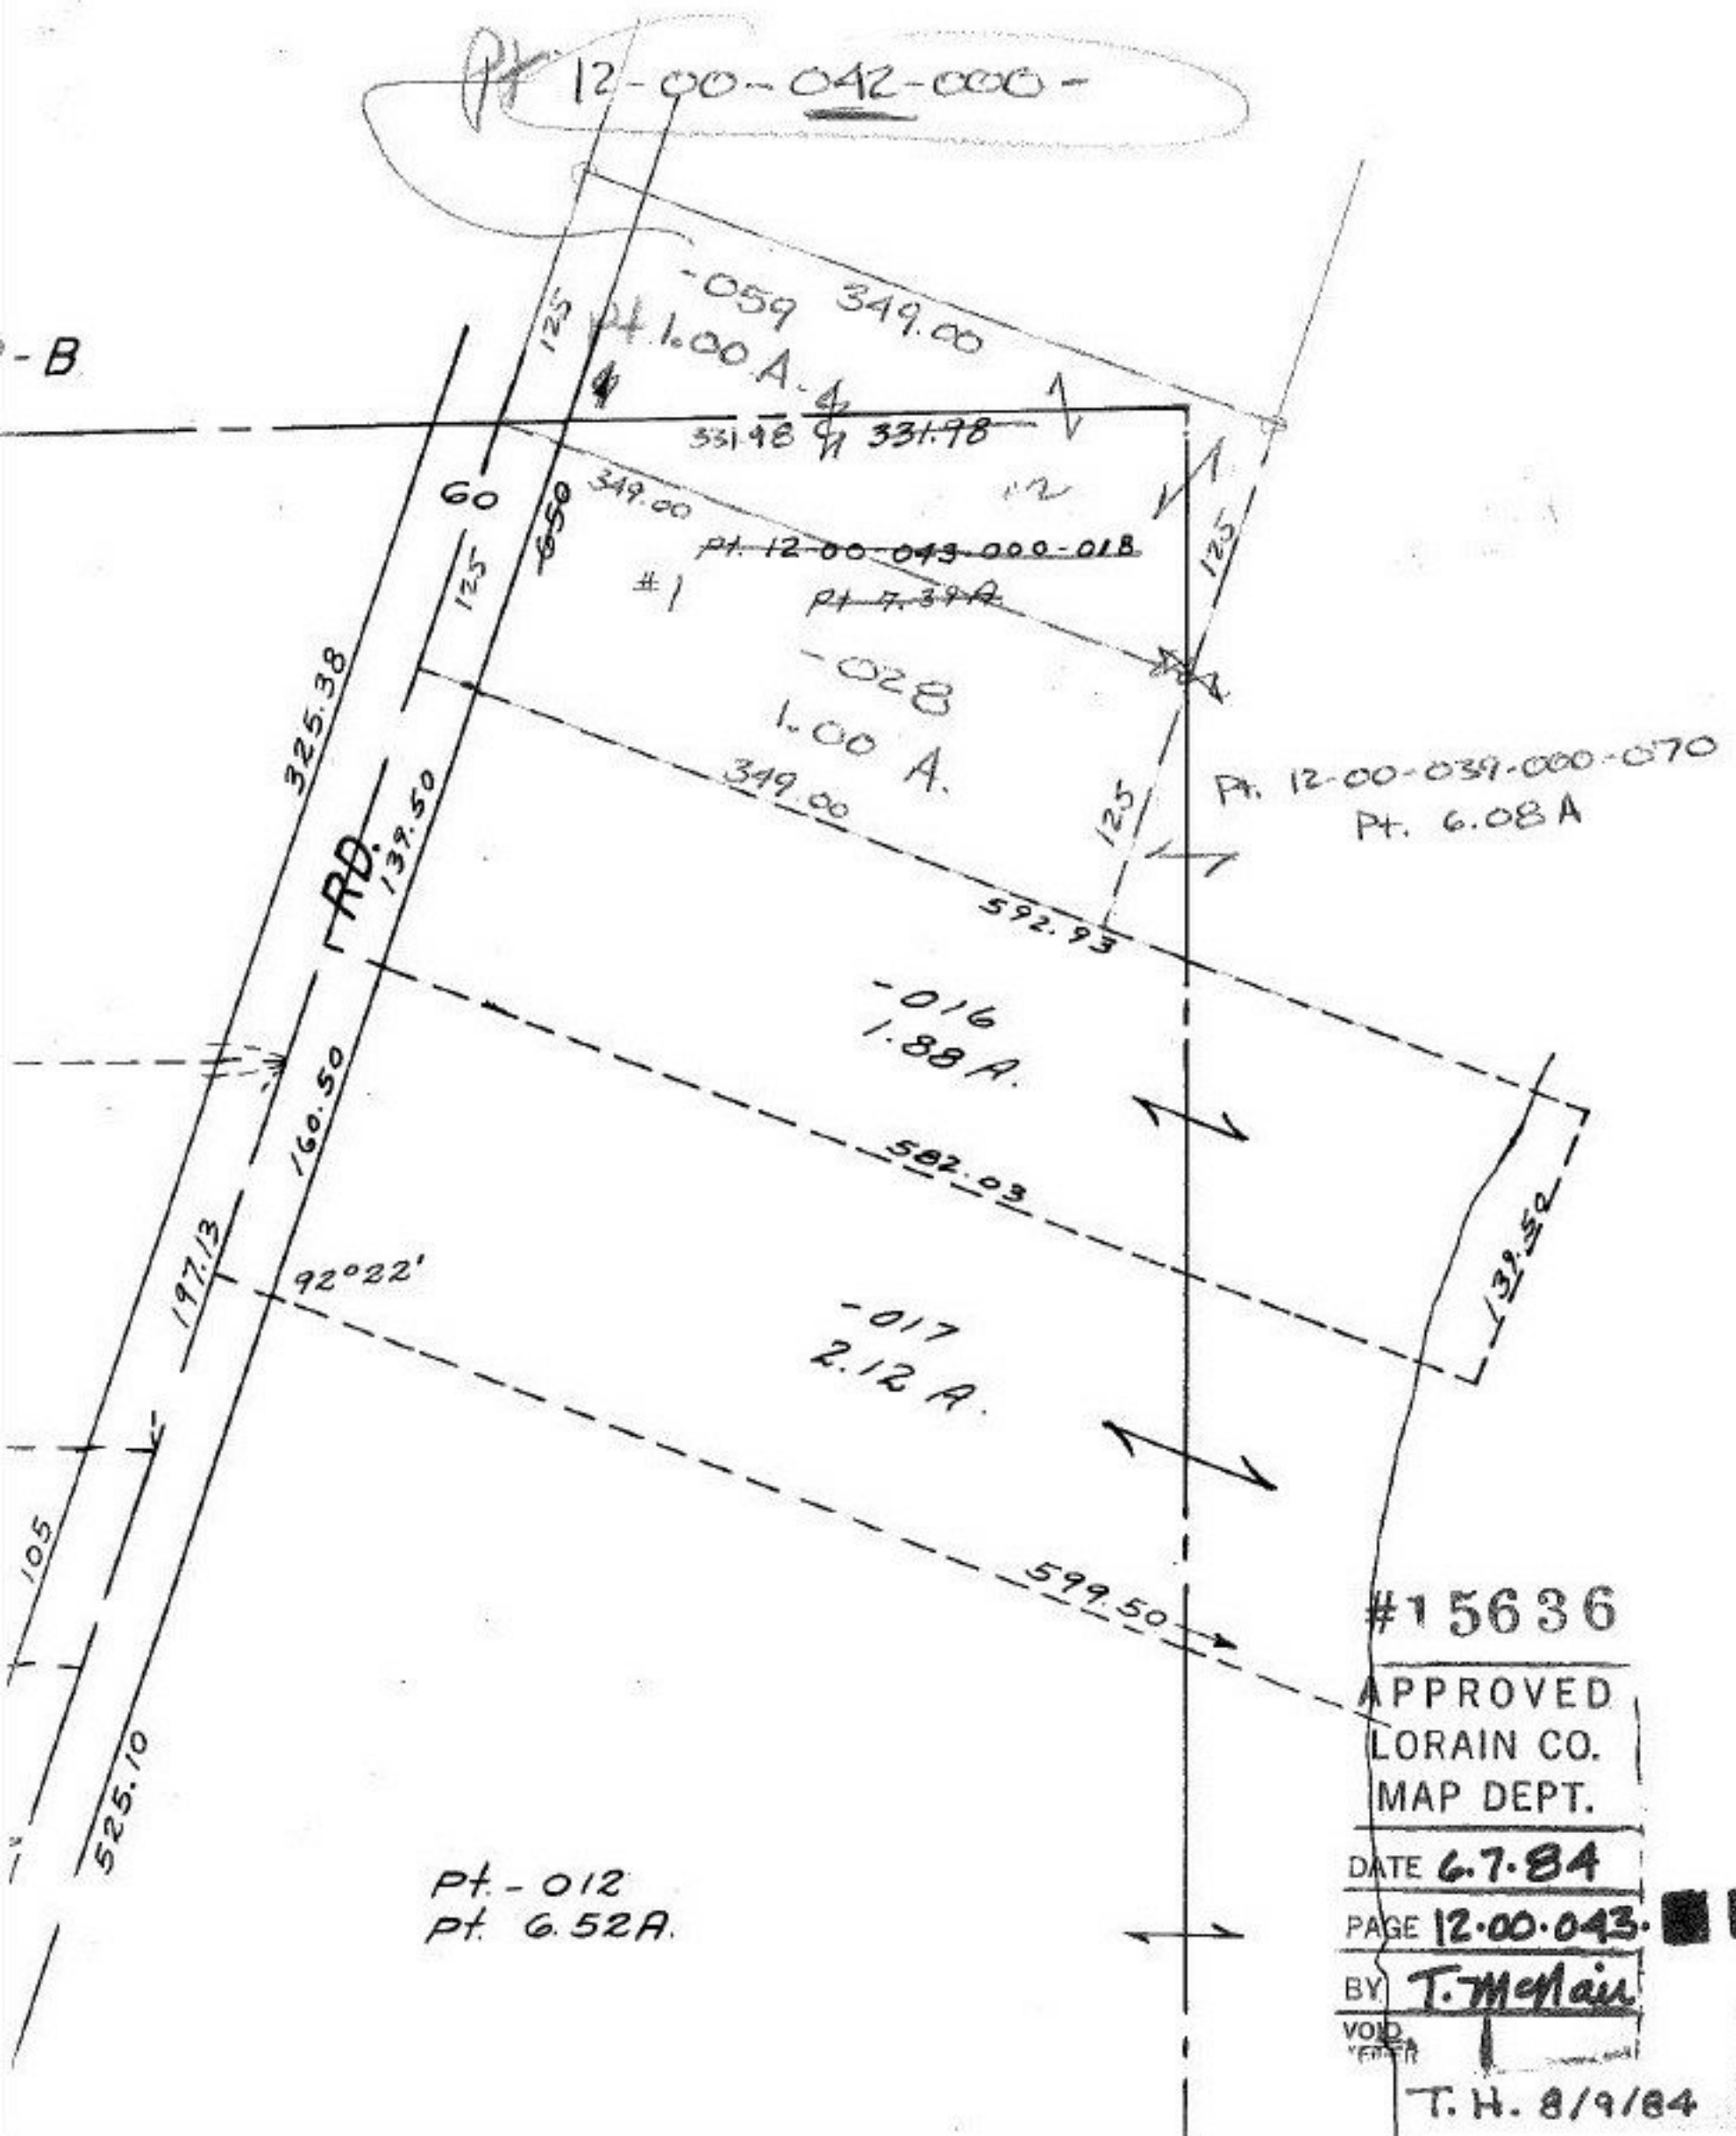

Pt. - 012  
Pt. 6.52A.

#15636  
APPROVED  
LORAIN CO.  
MAP DEPT.

DATE 6.7.84  
PAGE 12.00.043.  
BY T. McMain  
VOID  
IF  
REPRODUCED

■ B

T. H. 8/9/84