


SURVEY BY FOOR & ASSOC.

SEE 10-00-006-D

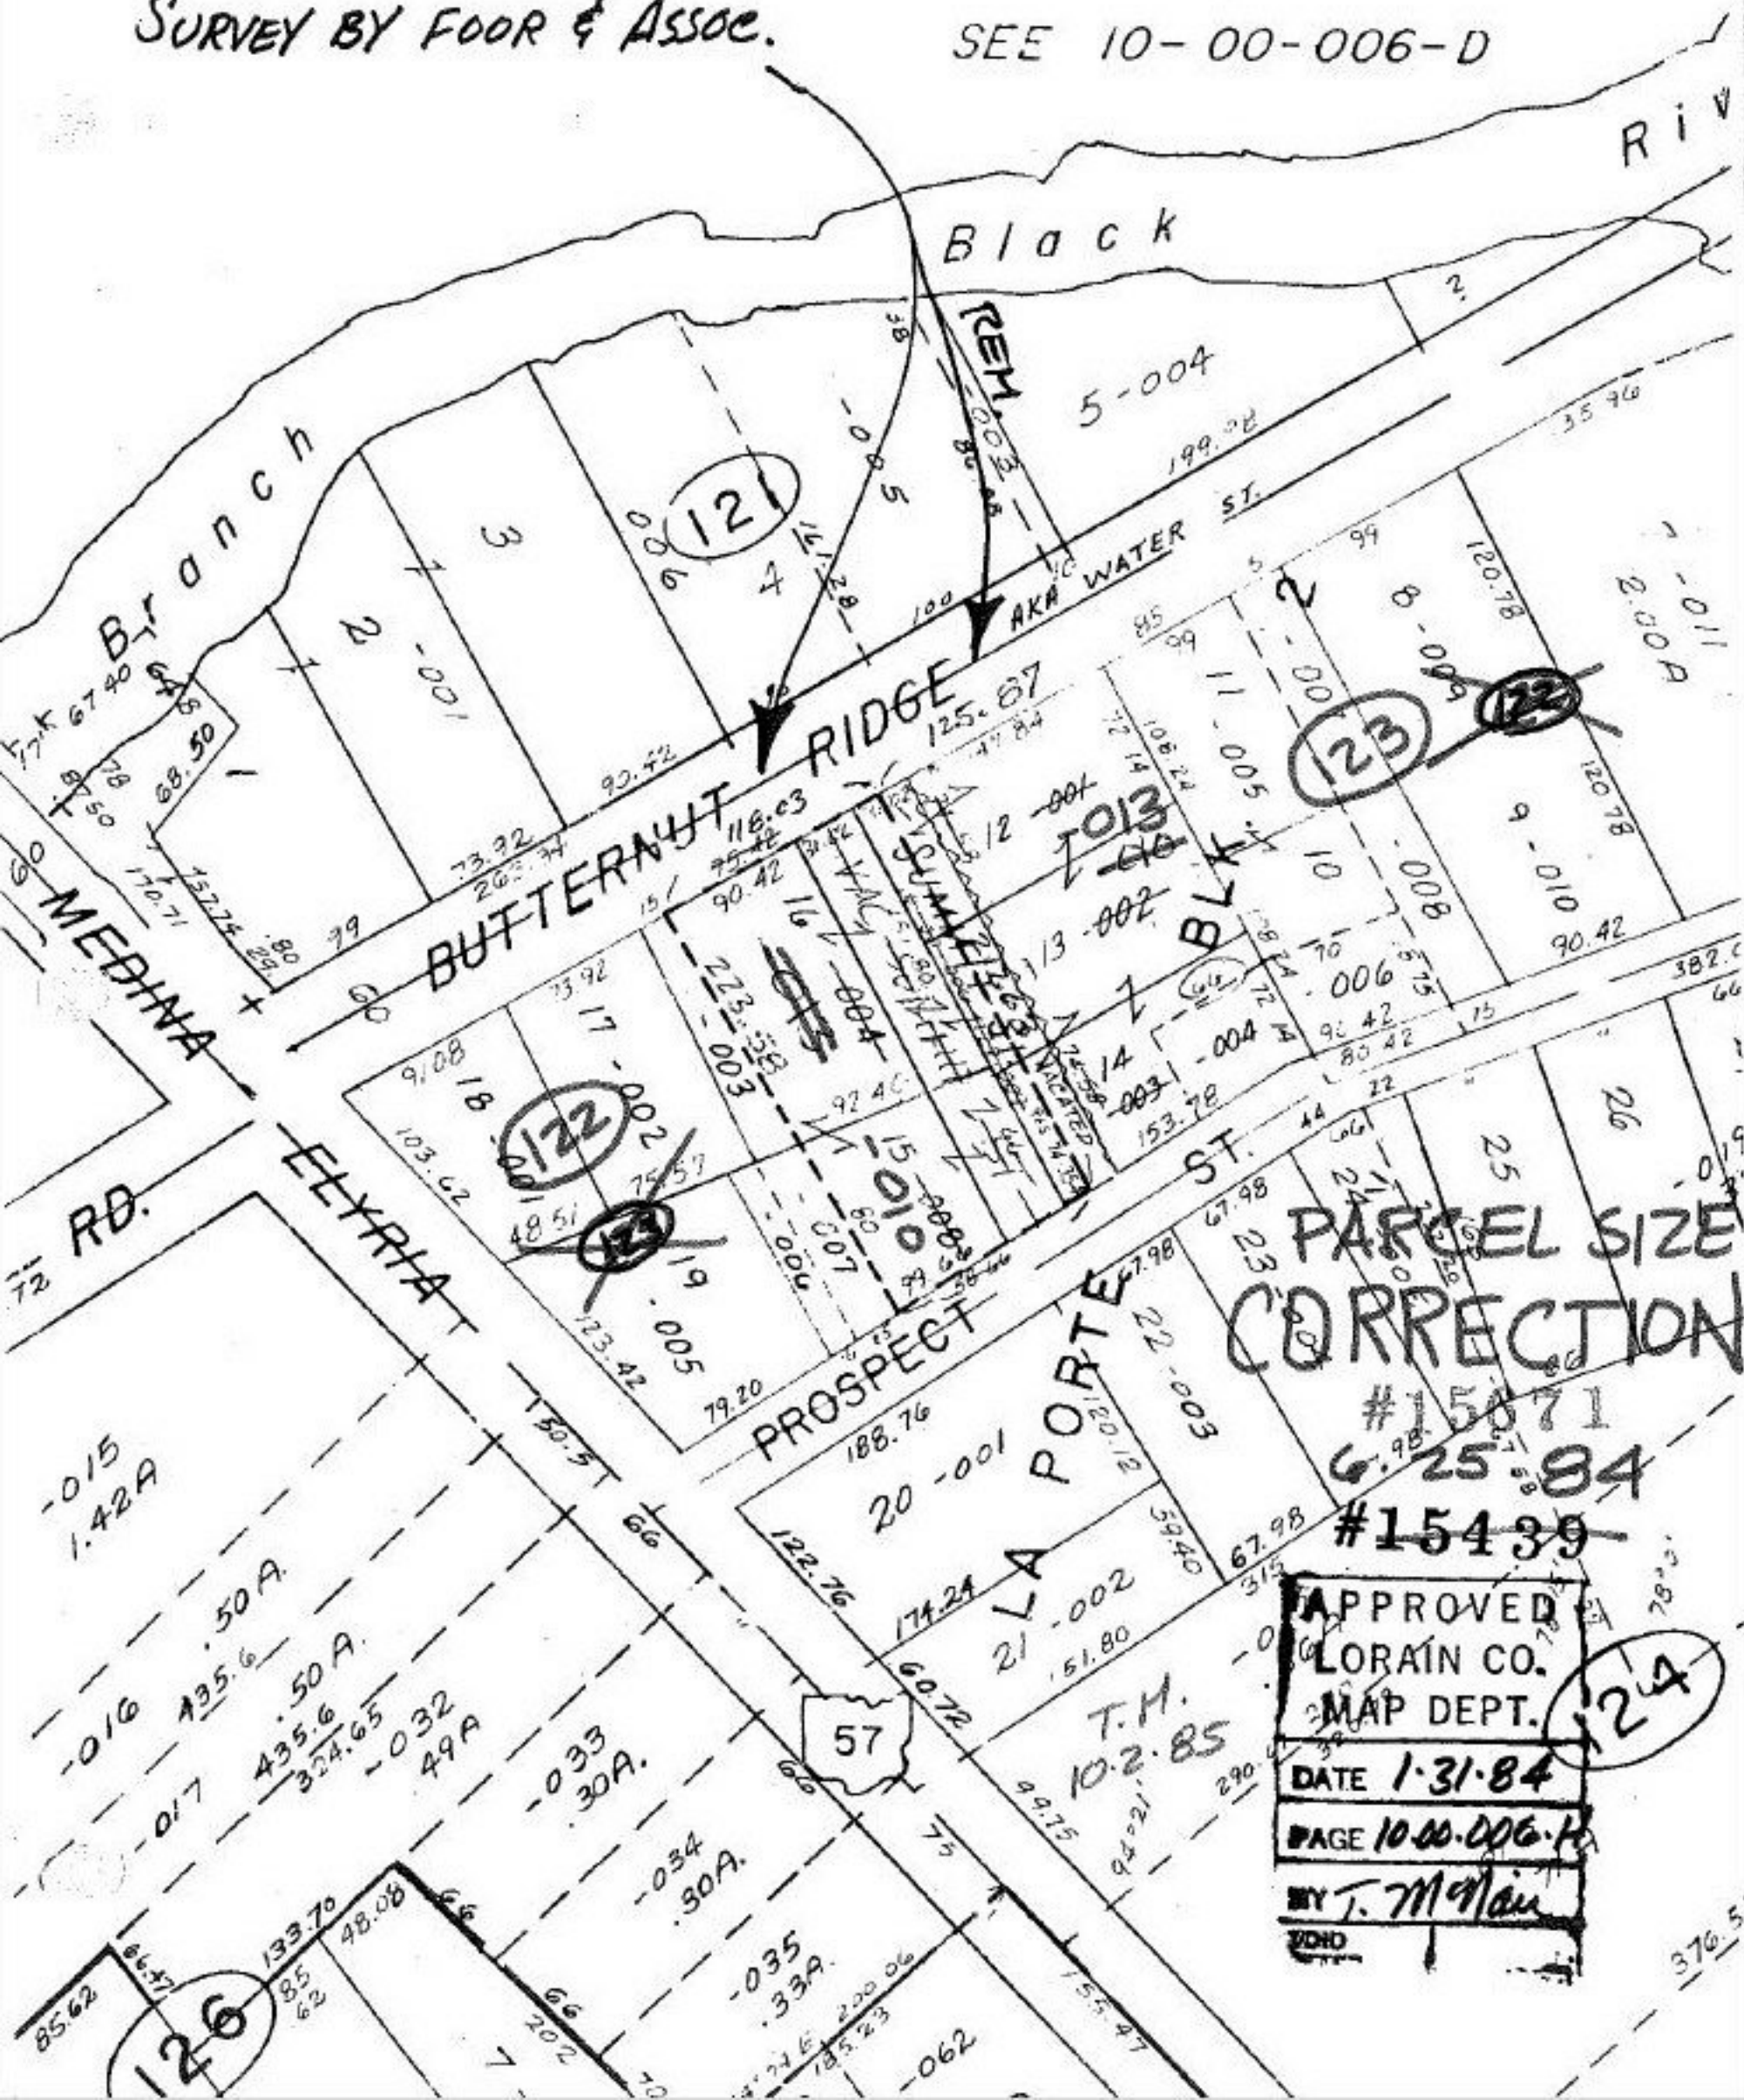

PARCEL SIZE
CORRECTION

#15071
6-25-84
#15439

APPROVED
LORAIN CO.
MAP DEPT.
DATE 1-31-84
PAGE 10-00-006-H
BY T.M. 10-2-85

124

126

57