


10
00A.

192

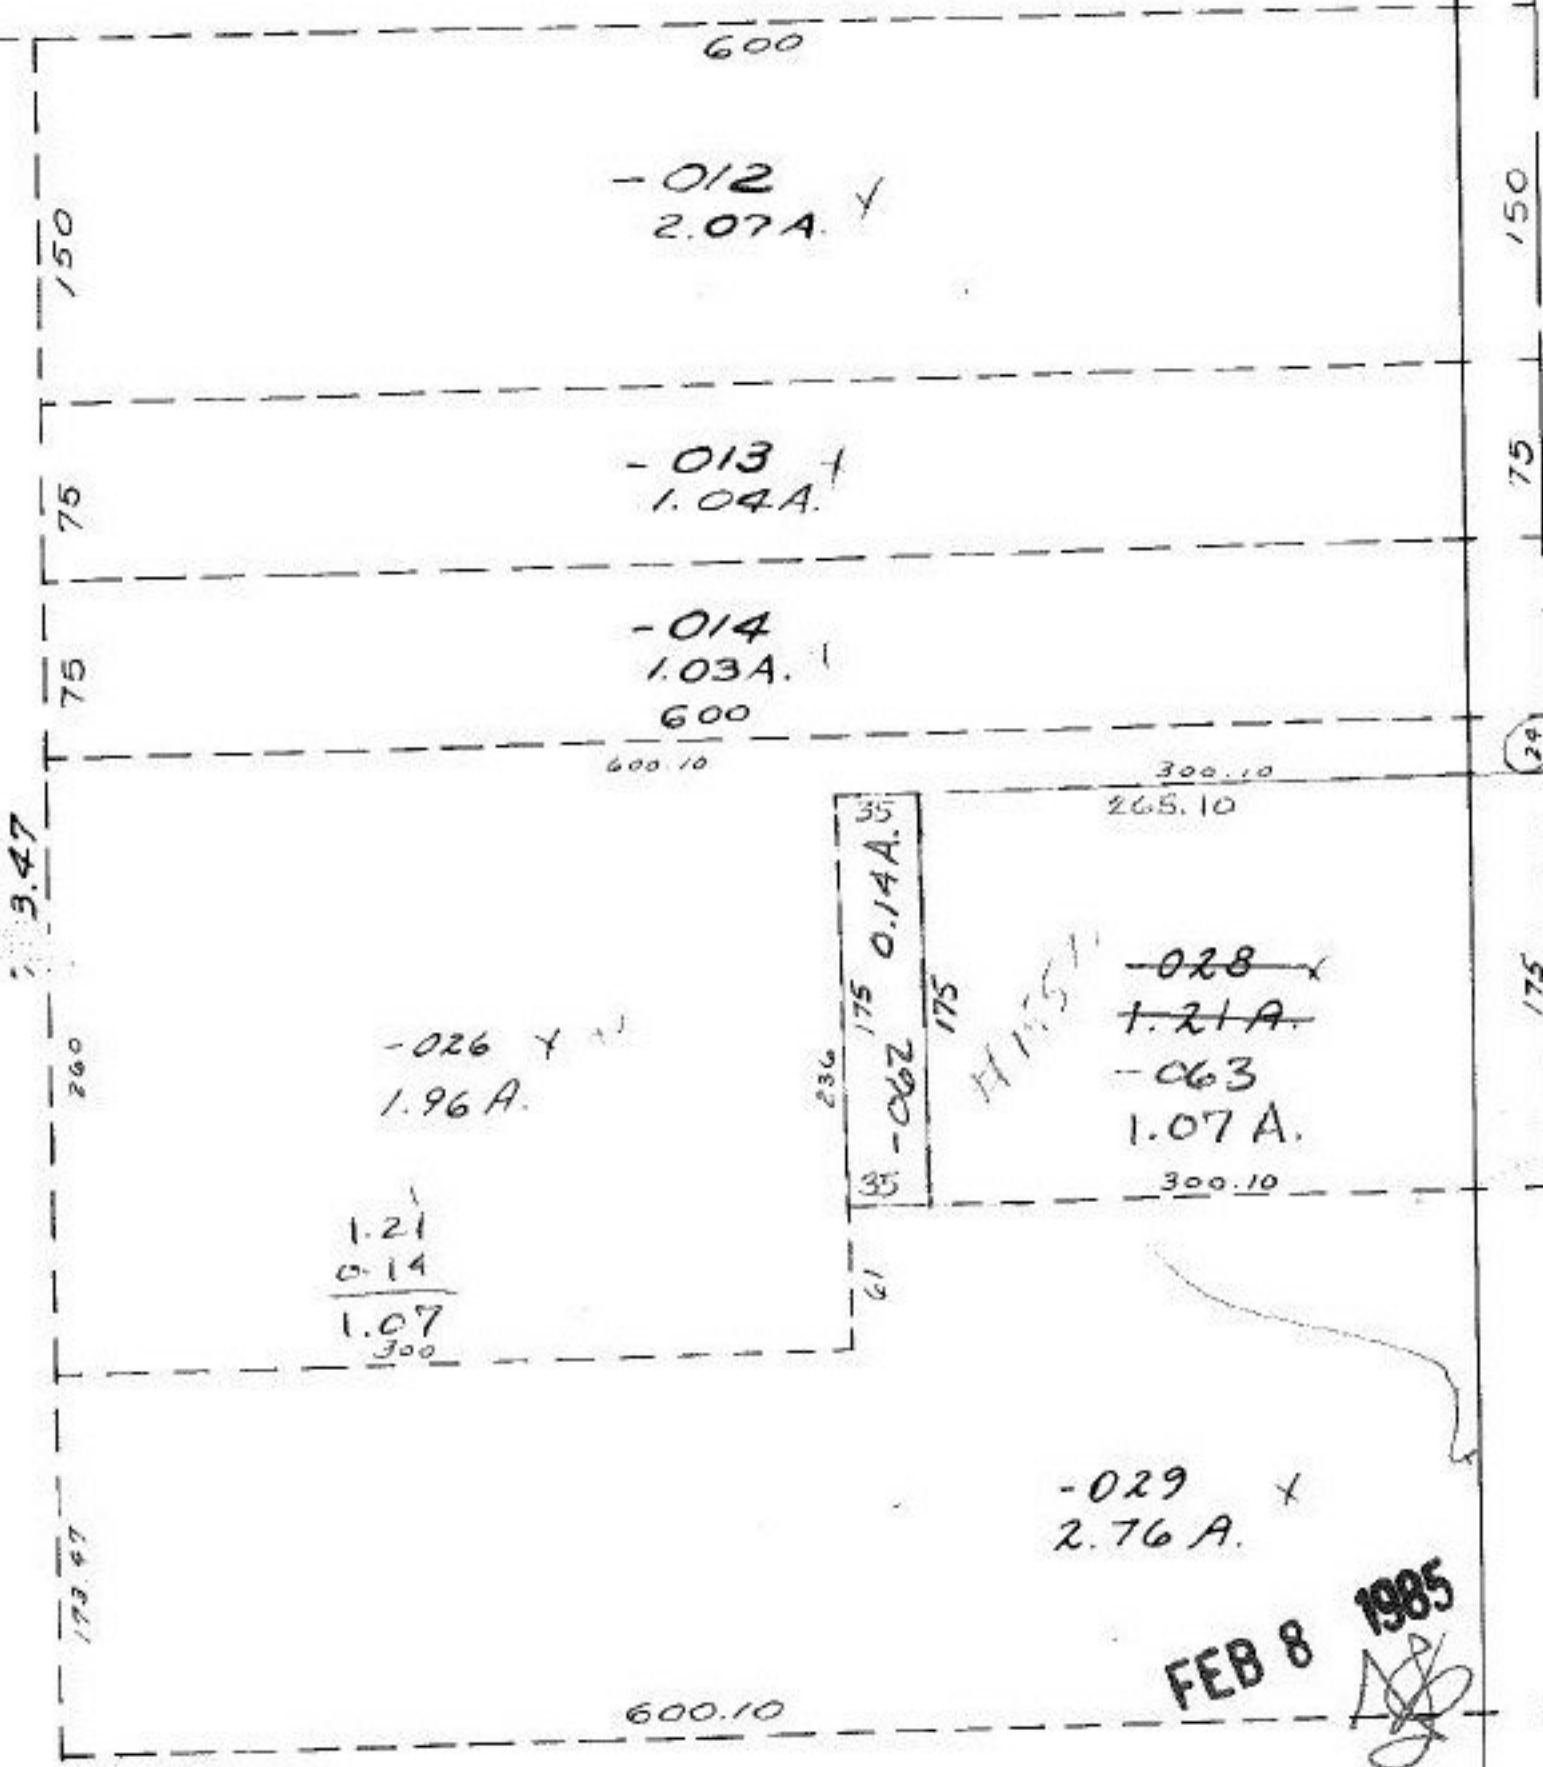

#15677

APPROVED
LORAIN CO.
MAP DEPT.

DATE 6.29.84

PAGE 4 00-017-F

BY T.M. Wain

VOID
IF

J.H.
2/8/85

017-G

102