


SEE 2-01-003-N

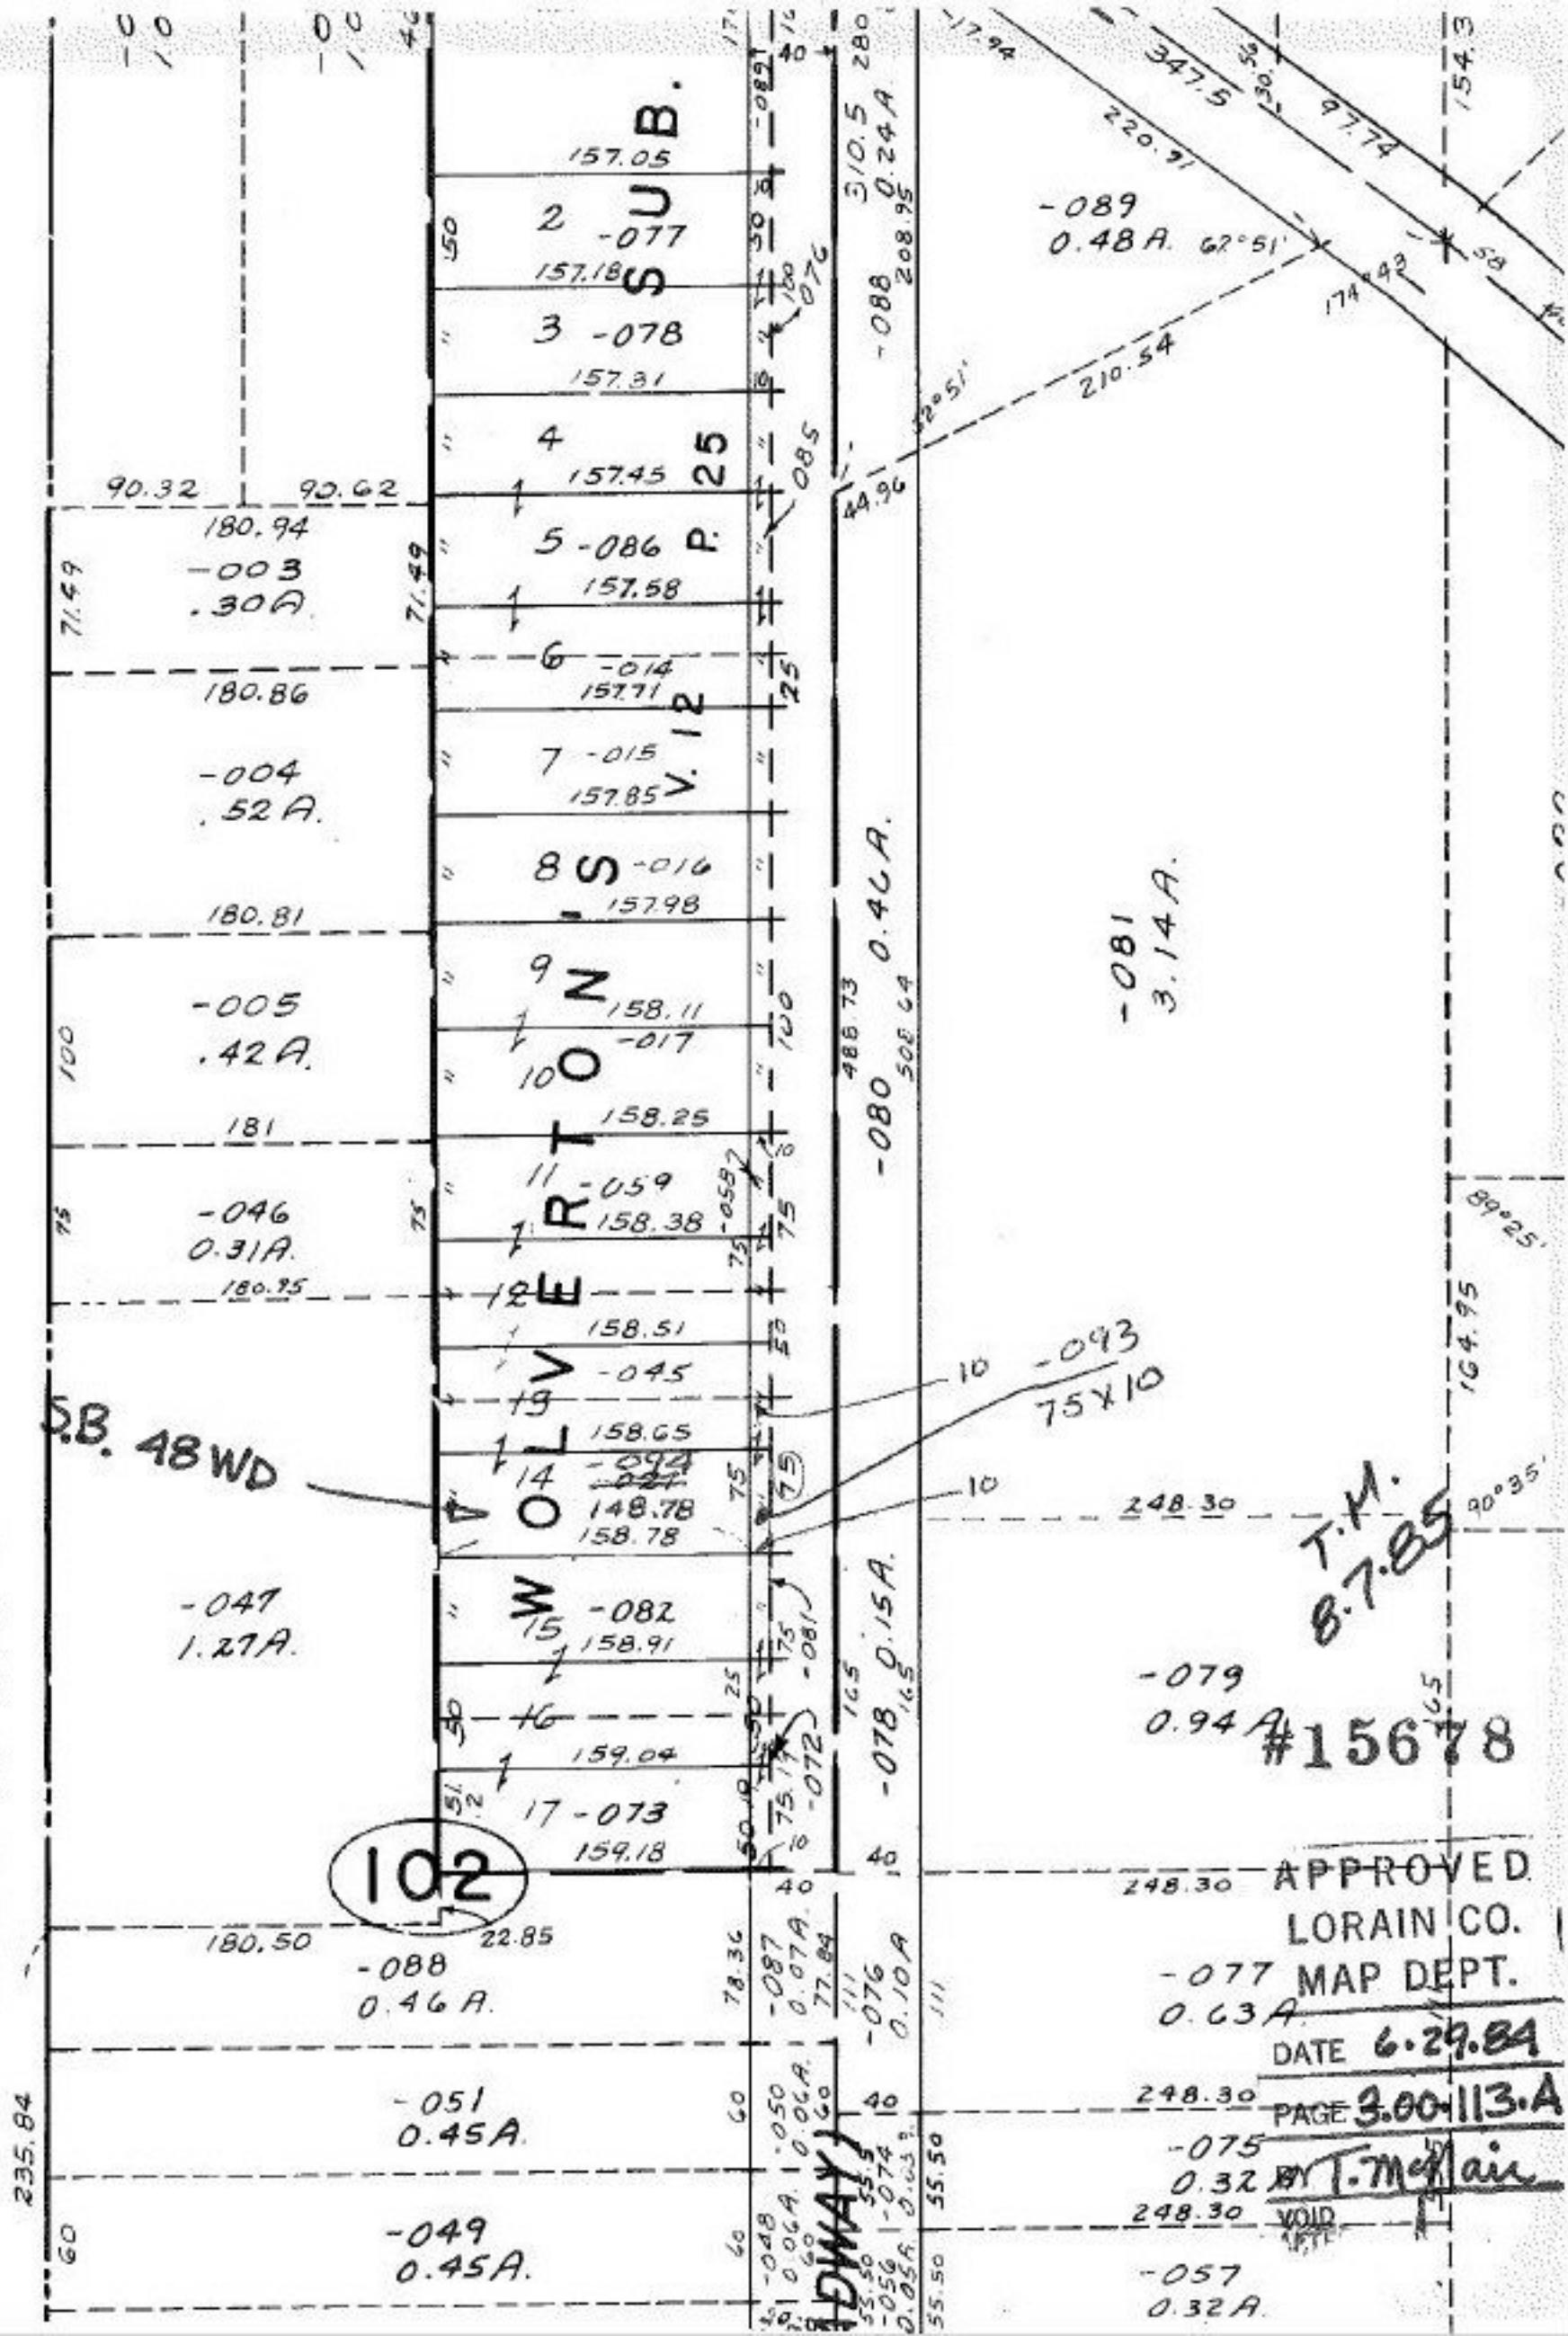

S.B. 48 WD

102

DWAY

-081
3.14 A.

T.M.
8-7-85
#15678

APPROVED
LORAIN CO.
MAP DEPT.
DATE 6-29-84
PAGE 3.00-113.A
BY T. McMain
VOID
-057
0.32 A.