


5-20-57
5-24-55 106-120
207.34

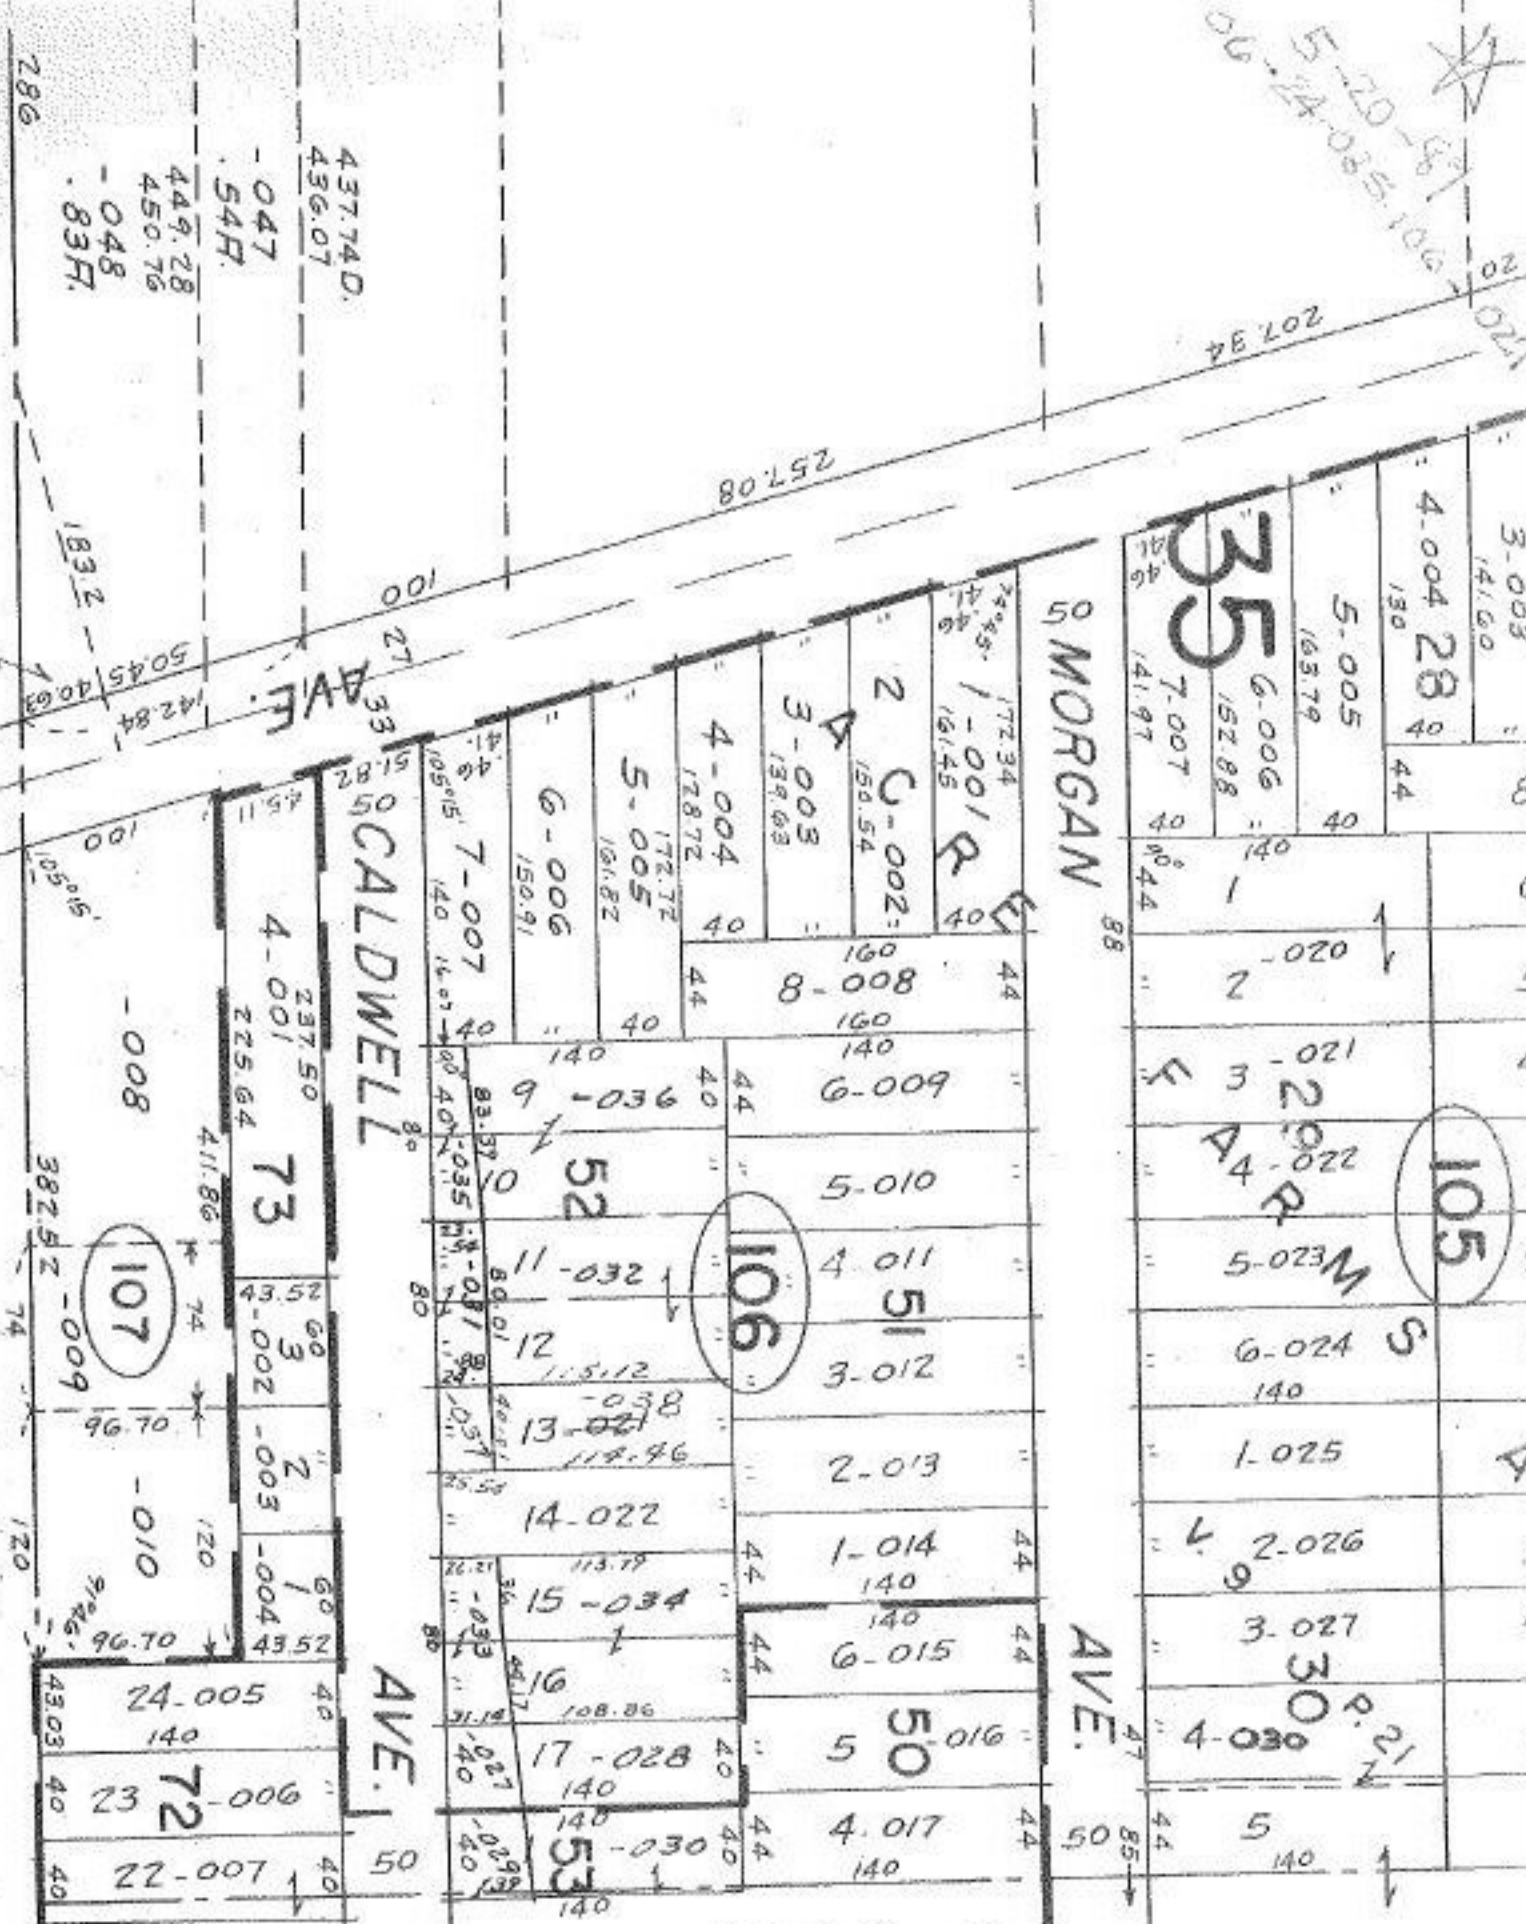


SEE 6-79

1570

ACRE FARMS ALLT

Done 5468
 Ad Map

1 IN. = 100 FT

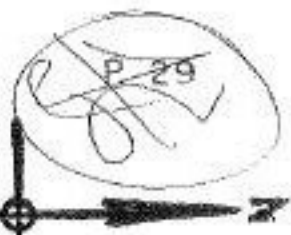

APPROVED
 LORAIN CO.
 MAP DEPT.
 DATE 2-28-68
 # 1570
 BY [Signature]

6-79