


SEE 6-24

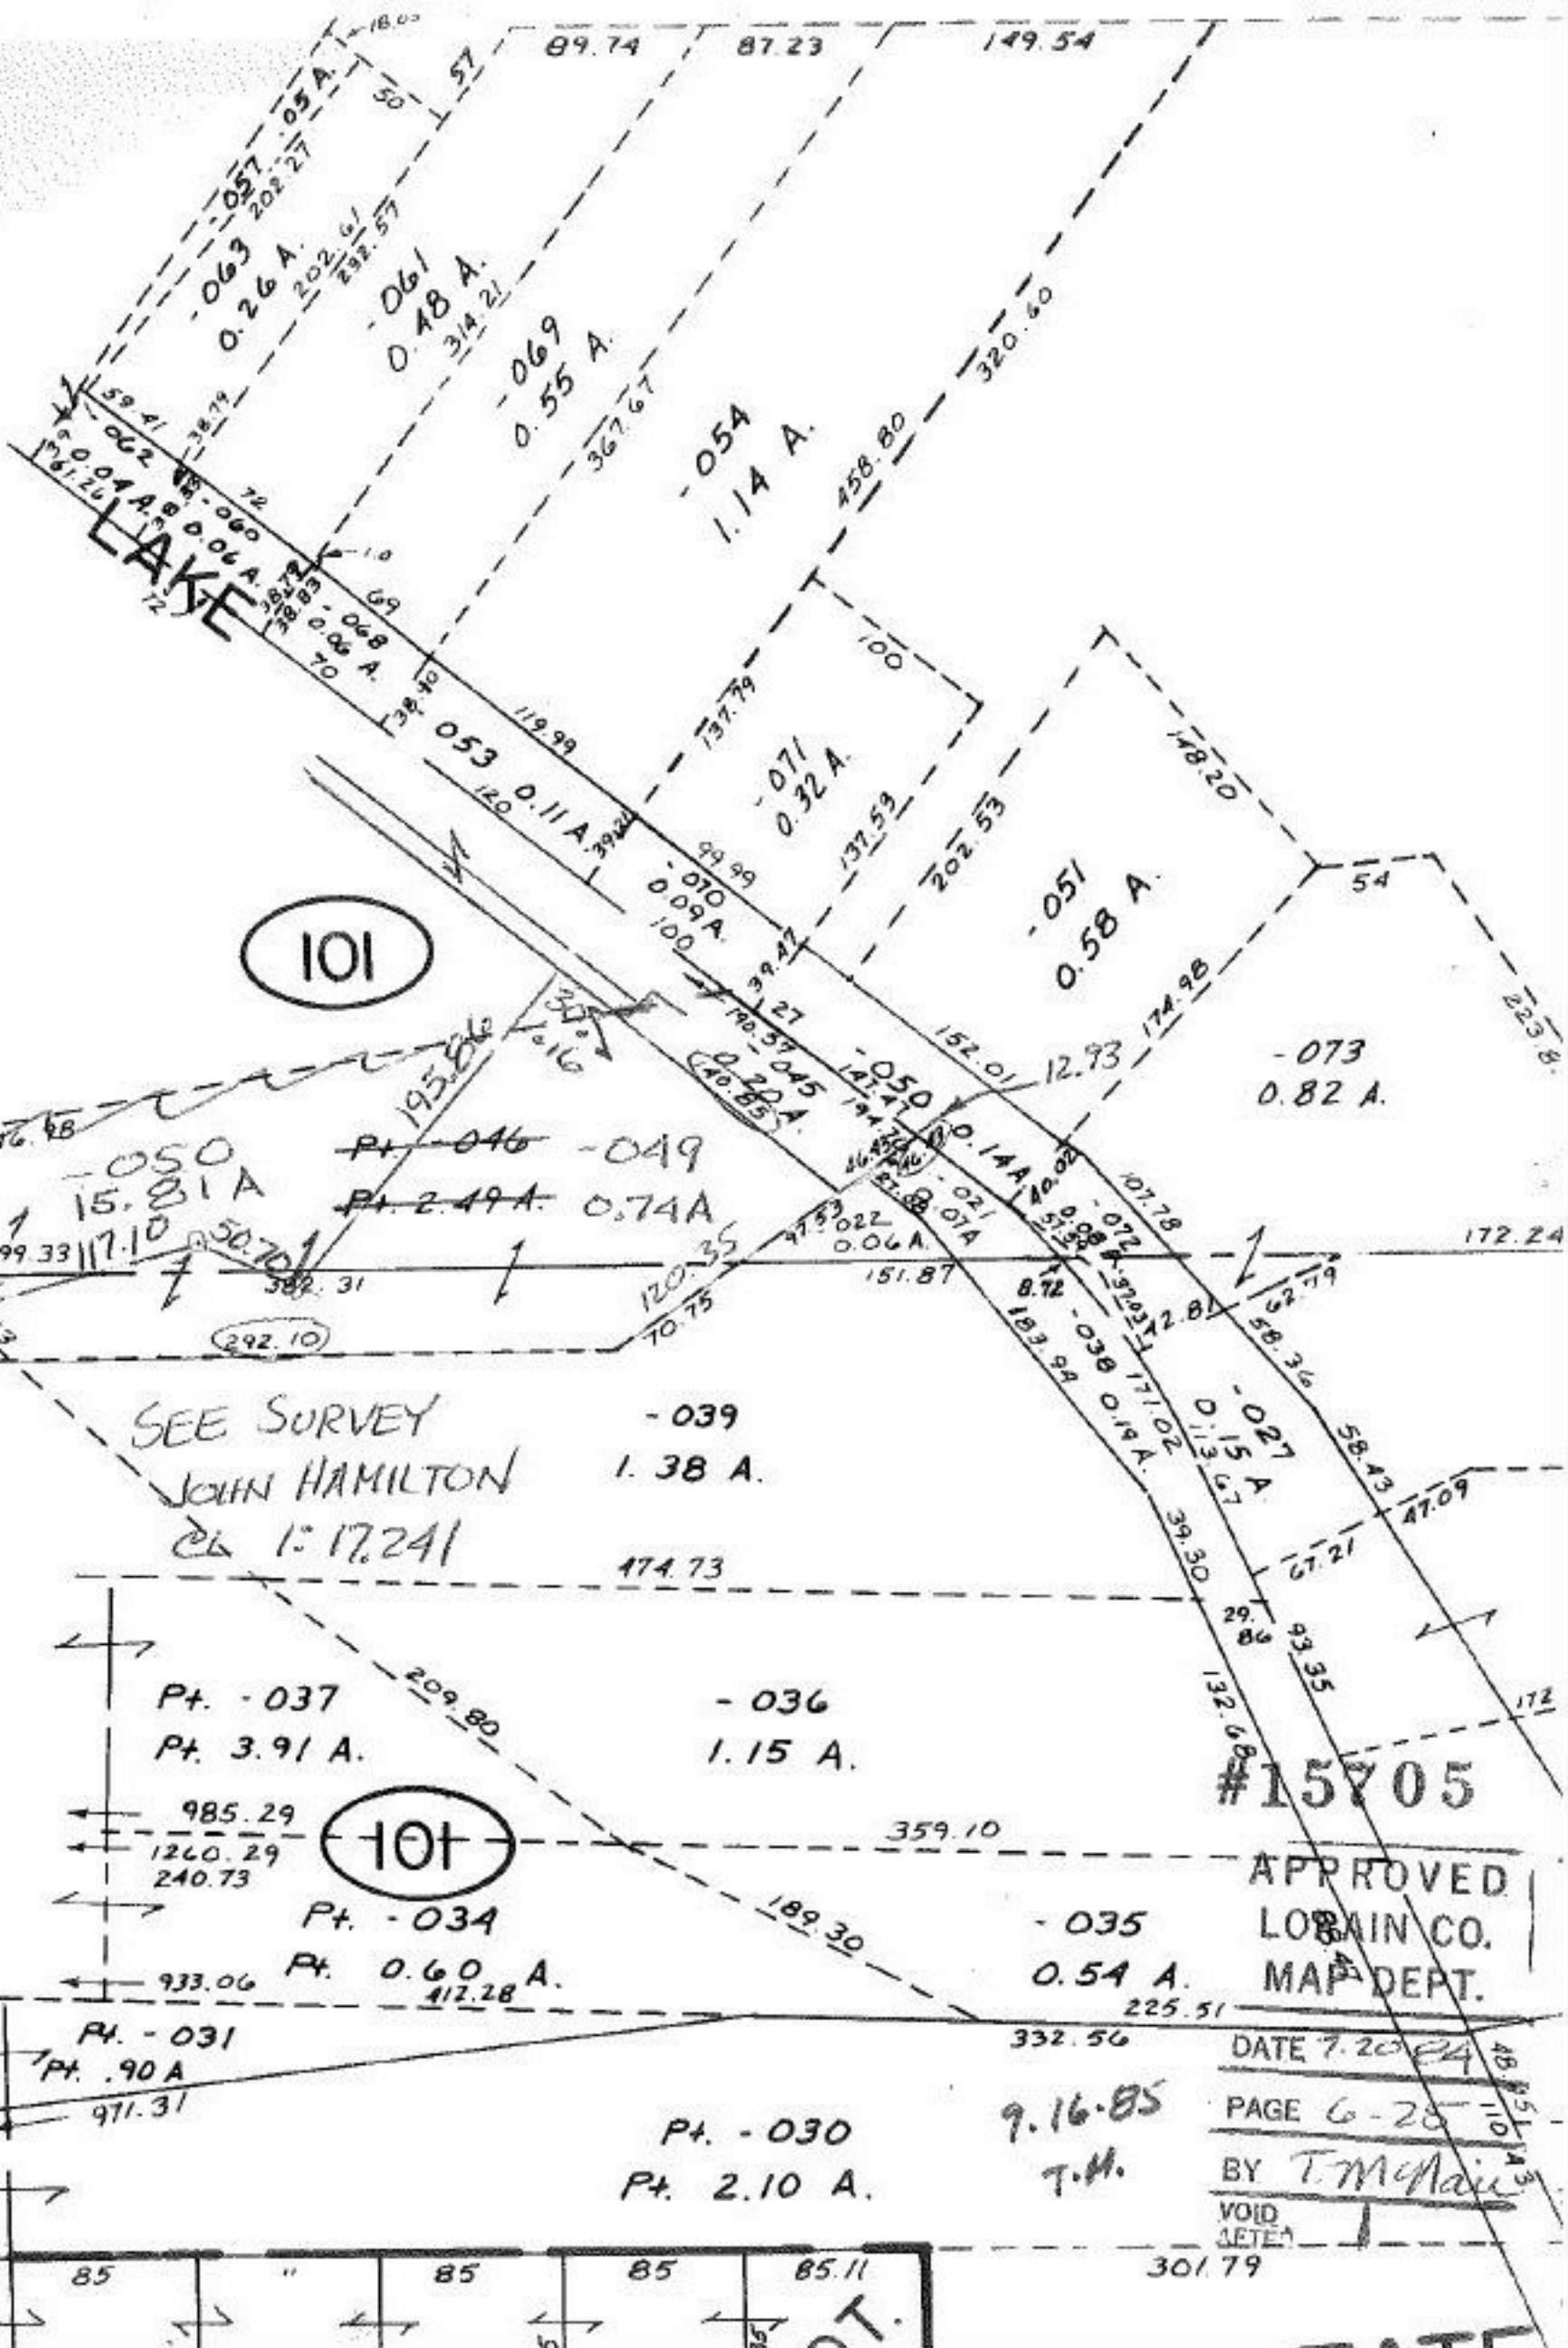

101

LAKE

SEE SURVEY JOHN HAMILTON CB 1:17.241

101

#15705


APPROVED LOGAN CO. MAP DEPT.

DATE 7.20.84

PAGE 6-25

BY T. McMain

VOID SETBACK

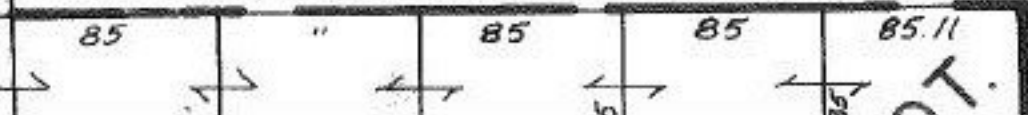

9.16.85 T.M.