


SEE 18-00-C

-010
5.42 A.

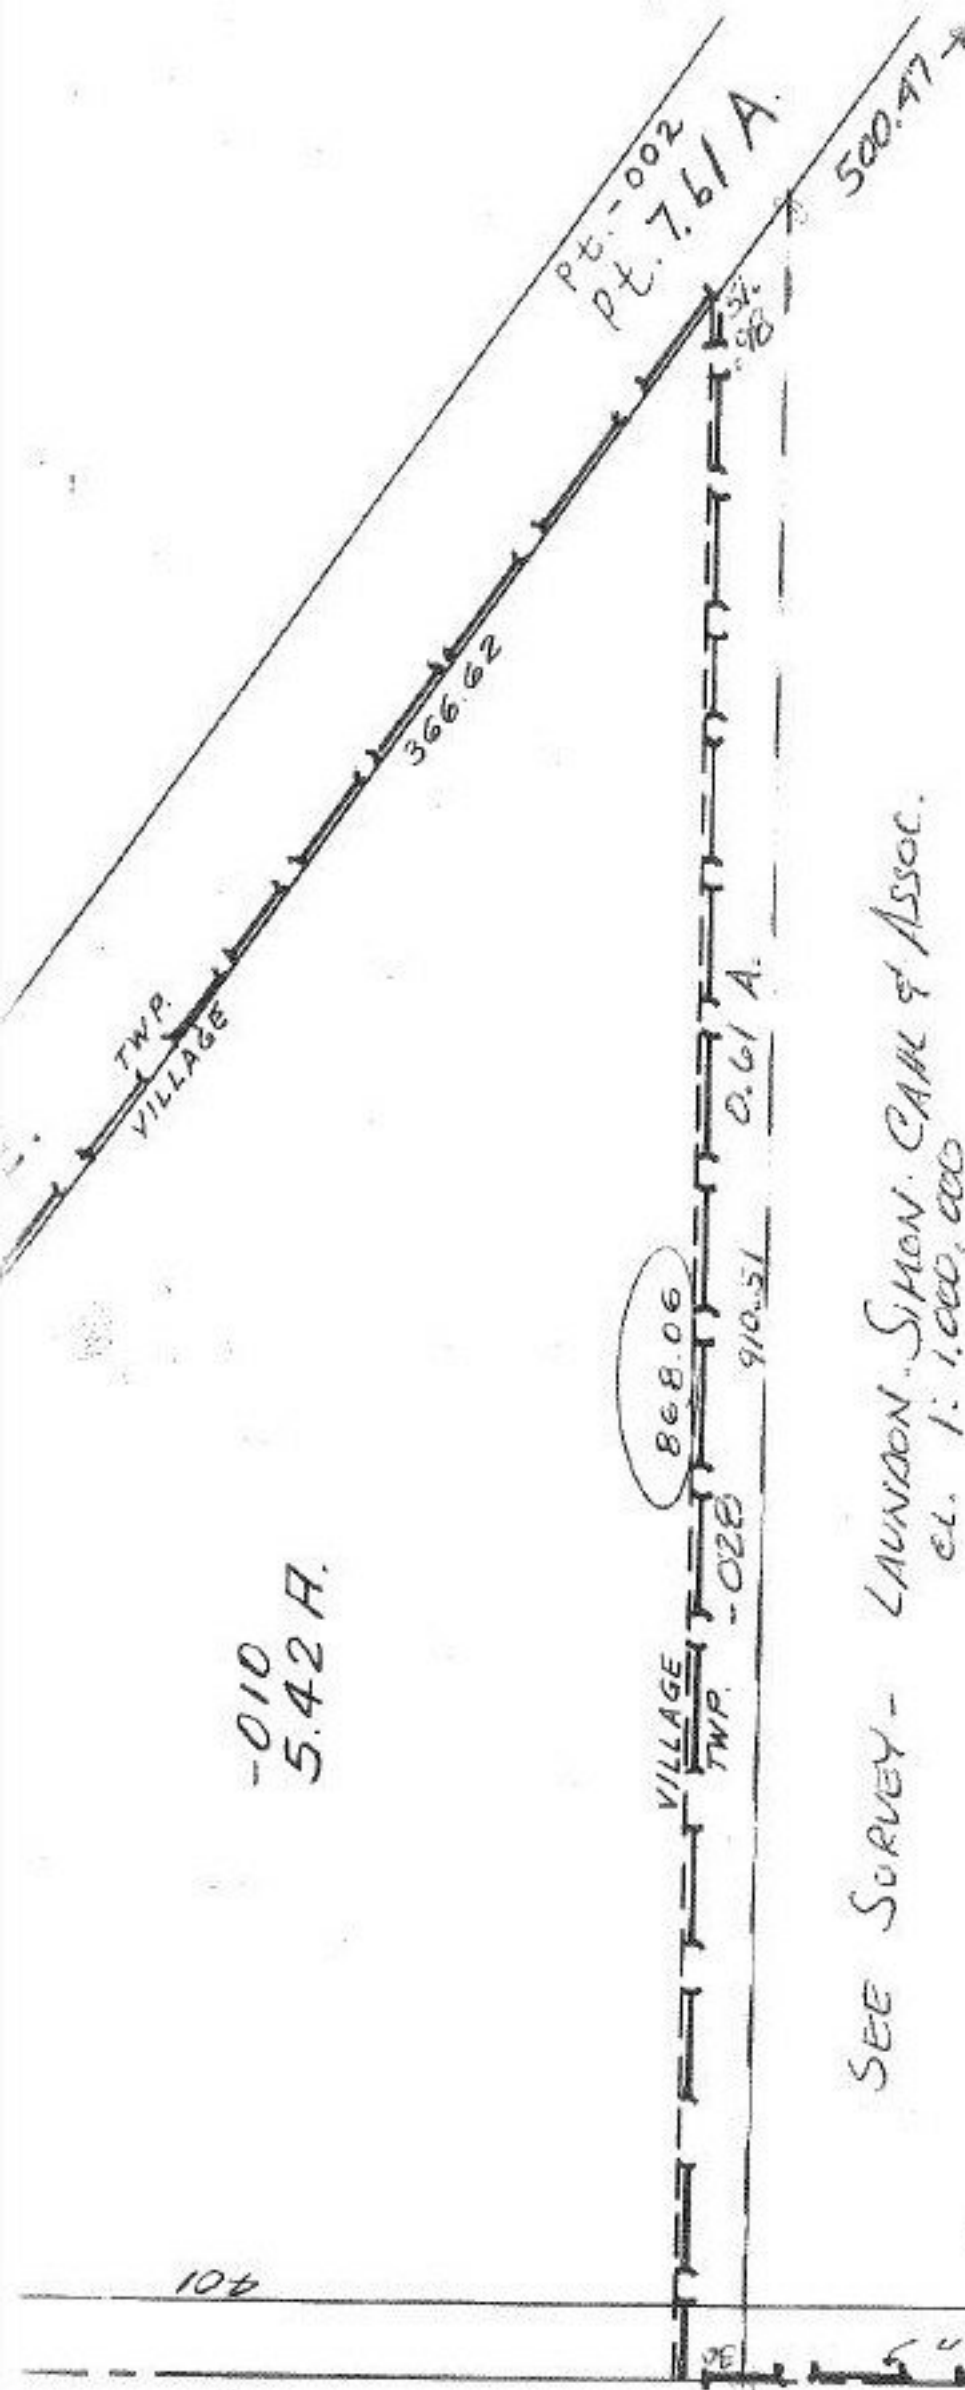

SEE SURVEY - LAUNDON SIMON CARL & ASSOC.
et. 1:1,000,000

-029
7.43A.
~~011~~
~~8.04A.~~

920.22
290.22

1/3/8.24

#15724

APPROVED
 [REDACTED]
 LORAIN CO.
 MAP DEPT.
 DATE 8.6.84
 PAGE 18.00.023-A
 BY T. McMain
 VOID AFTER
 T.H. 4/23/85

-018
10.60A

OBERLIN

Corp Line Village of Wellington