


5-21-68

INDIAN HOLLOW

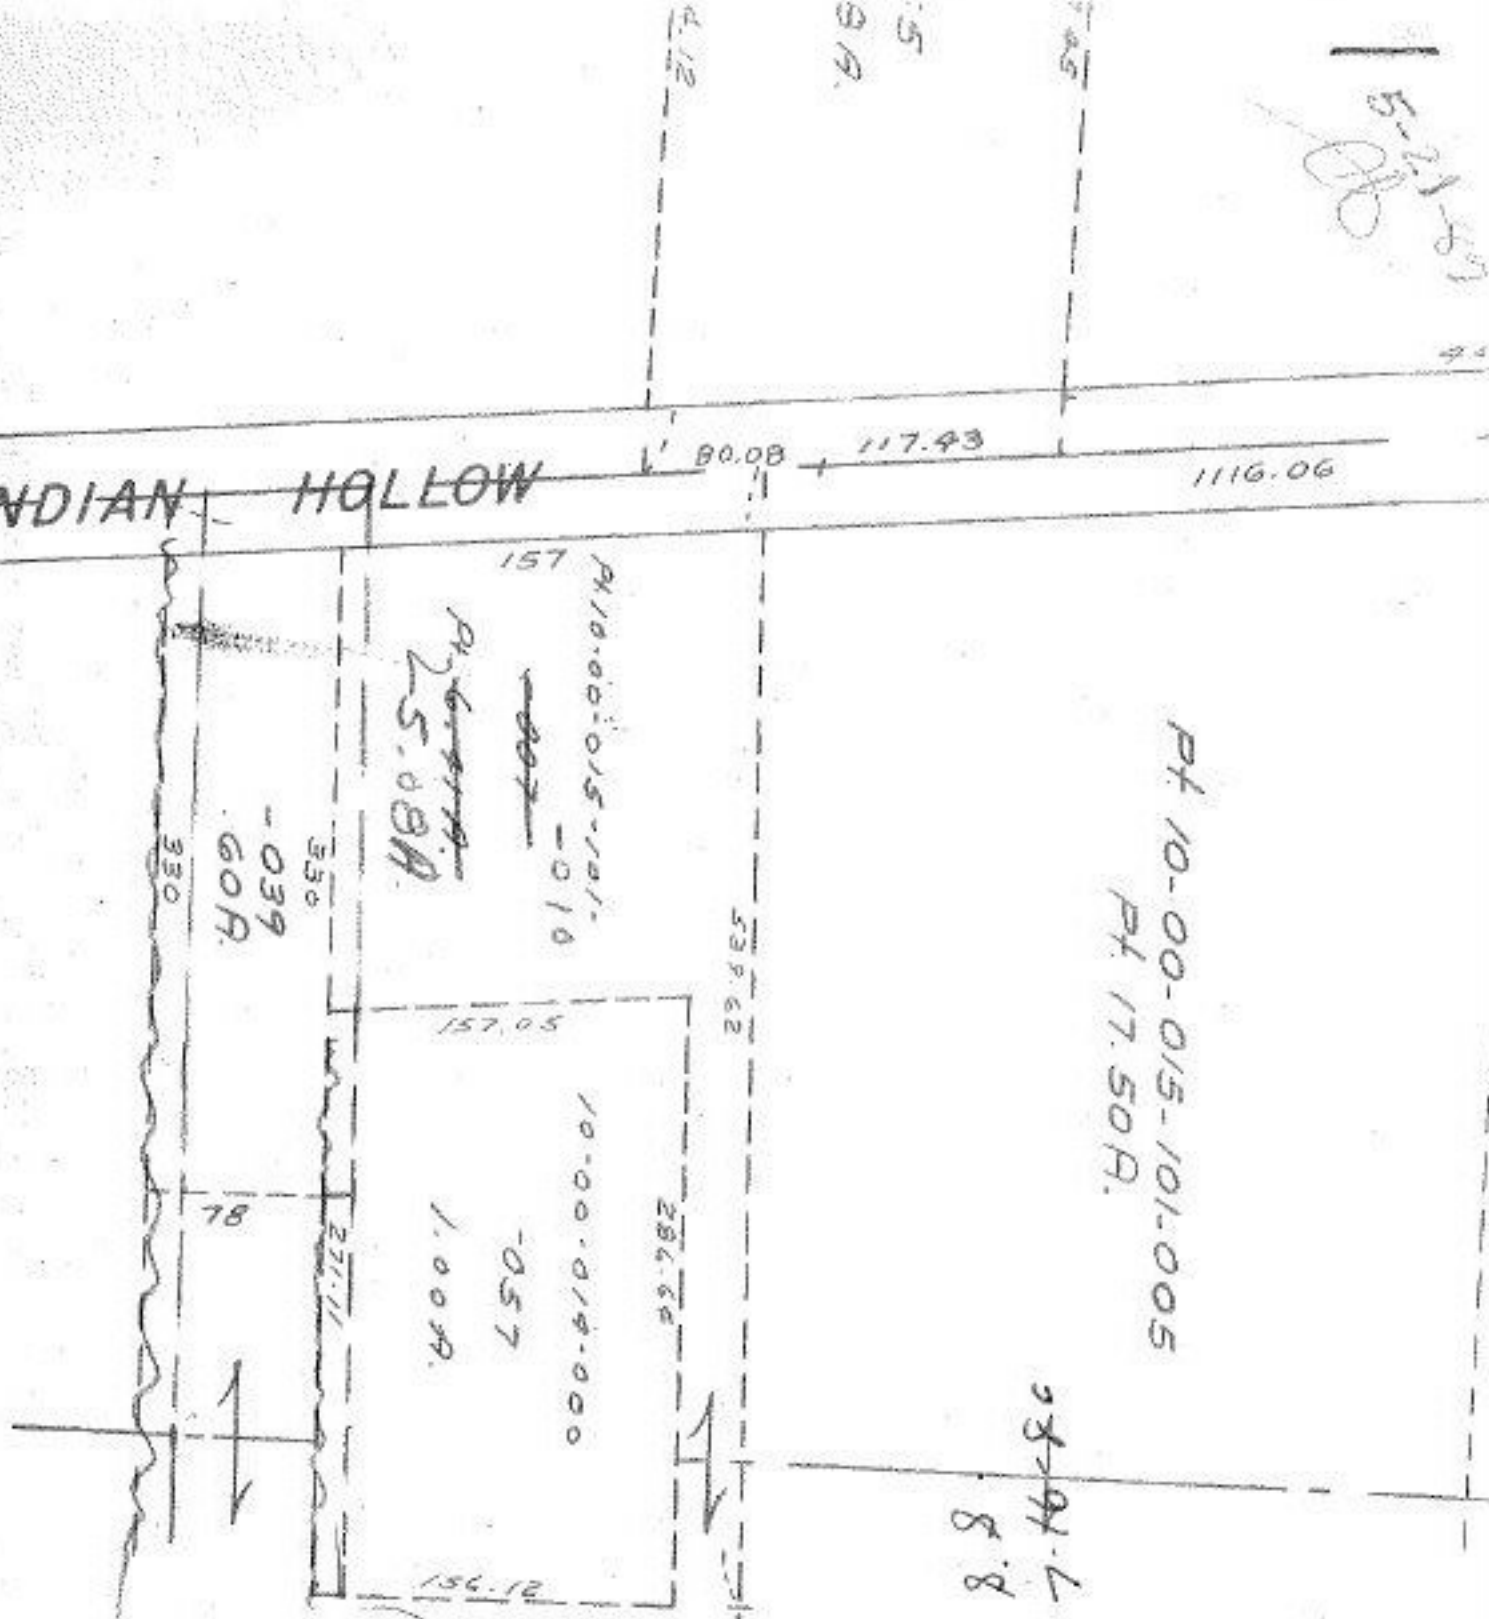

Pt 10-00-01/5-101-005
Pt 17.50A.

58-91-L
S. 8

#1573
APPROVED
LORAIN CO.
MAP DEPT.
DATE 2-22-68
10-00-14-D
BY <i>[Signature]</i>

[Signature]

DONE 5-4-68 FRANK COLBERT.

[Handwritten mark]