

APPROVED

LORAIN CO.

MAP DEPT.

DATE 2-27-68


10-00-015-A

BY *J. Thompson*

PL-005
PT 17.50 A.

S. C.

DONE 5-9-68
FRANK COLBERT.

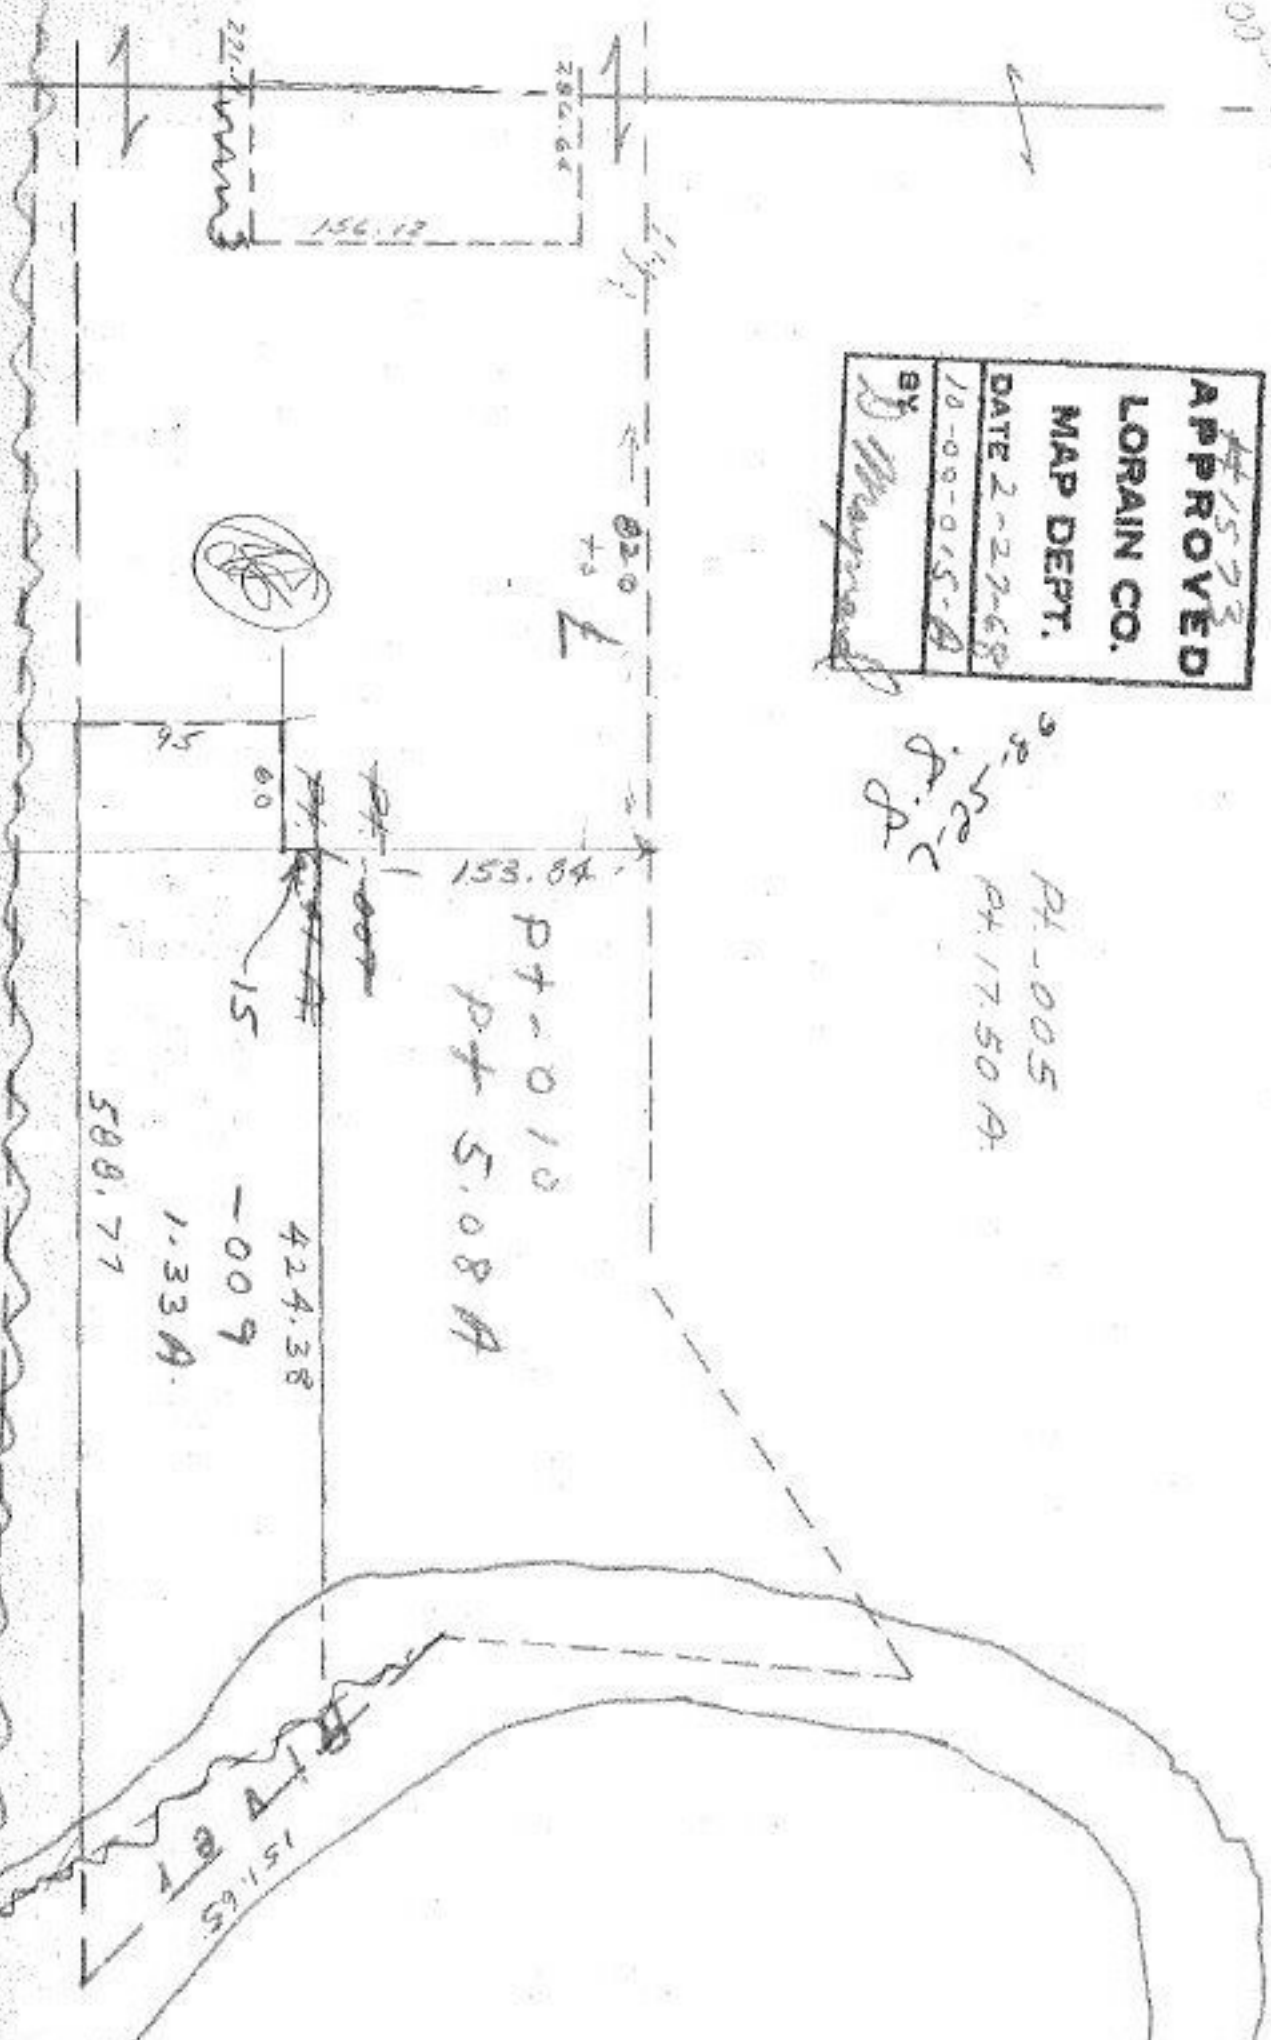

SEE 10-00-015-E

CARLISLE TWP.

SCALE: 1" = 100'

X-21-5-101-001
10-00-015-A