


SEE 1-00-001-B

SANDUSKY



(LAKE)

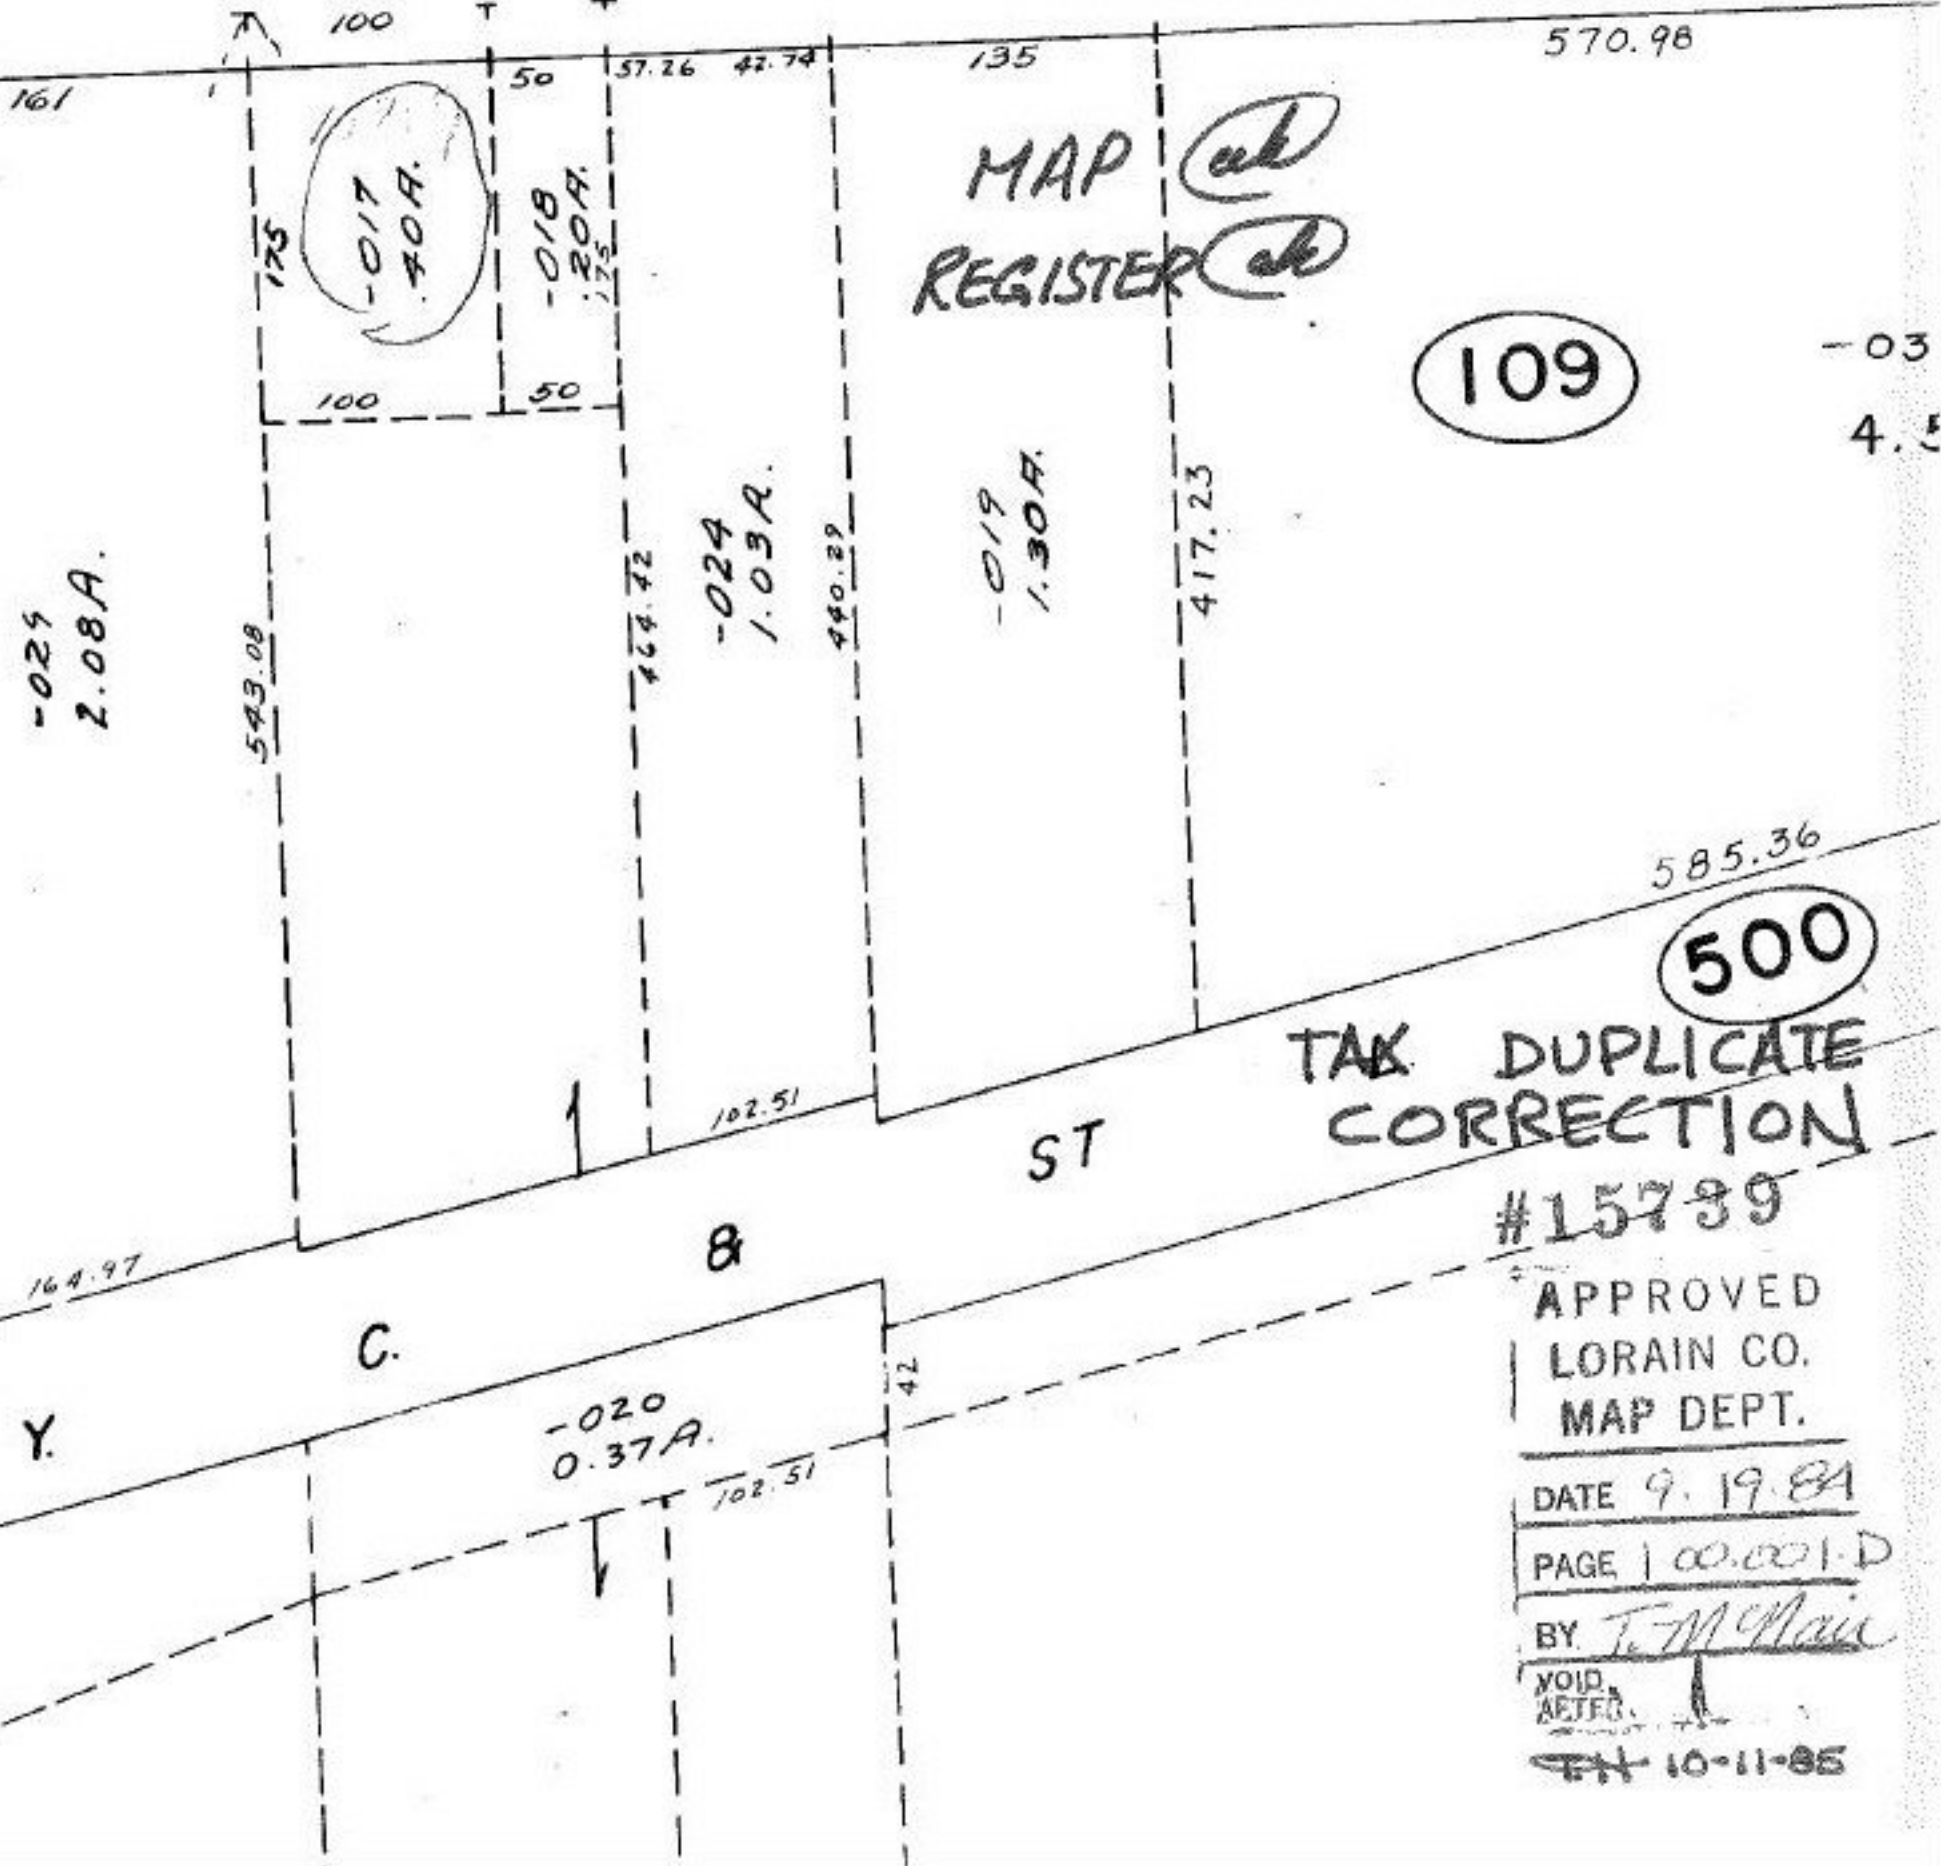

109

500

TAX DUPLICATE CORRECTION

#15739

APPROVED  
LORAIN CO.  
MAP DEPT.

DATE 9.19.84

PAGE 100.001-D

BY T. M. Main

VOID  
AFTER

10-11-85