


SEE 6-123

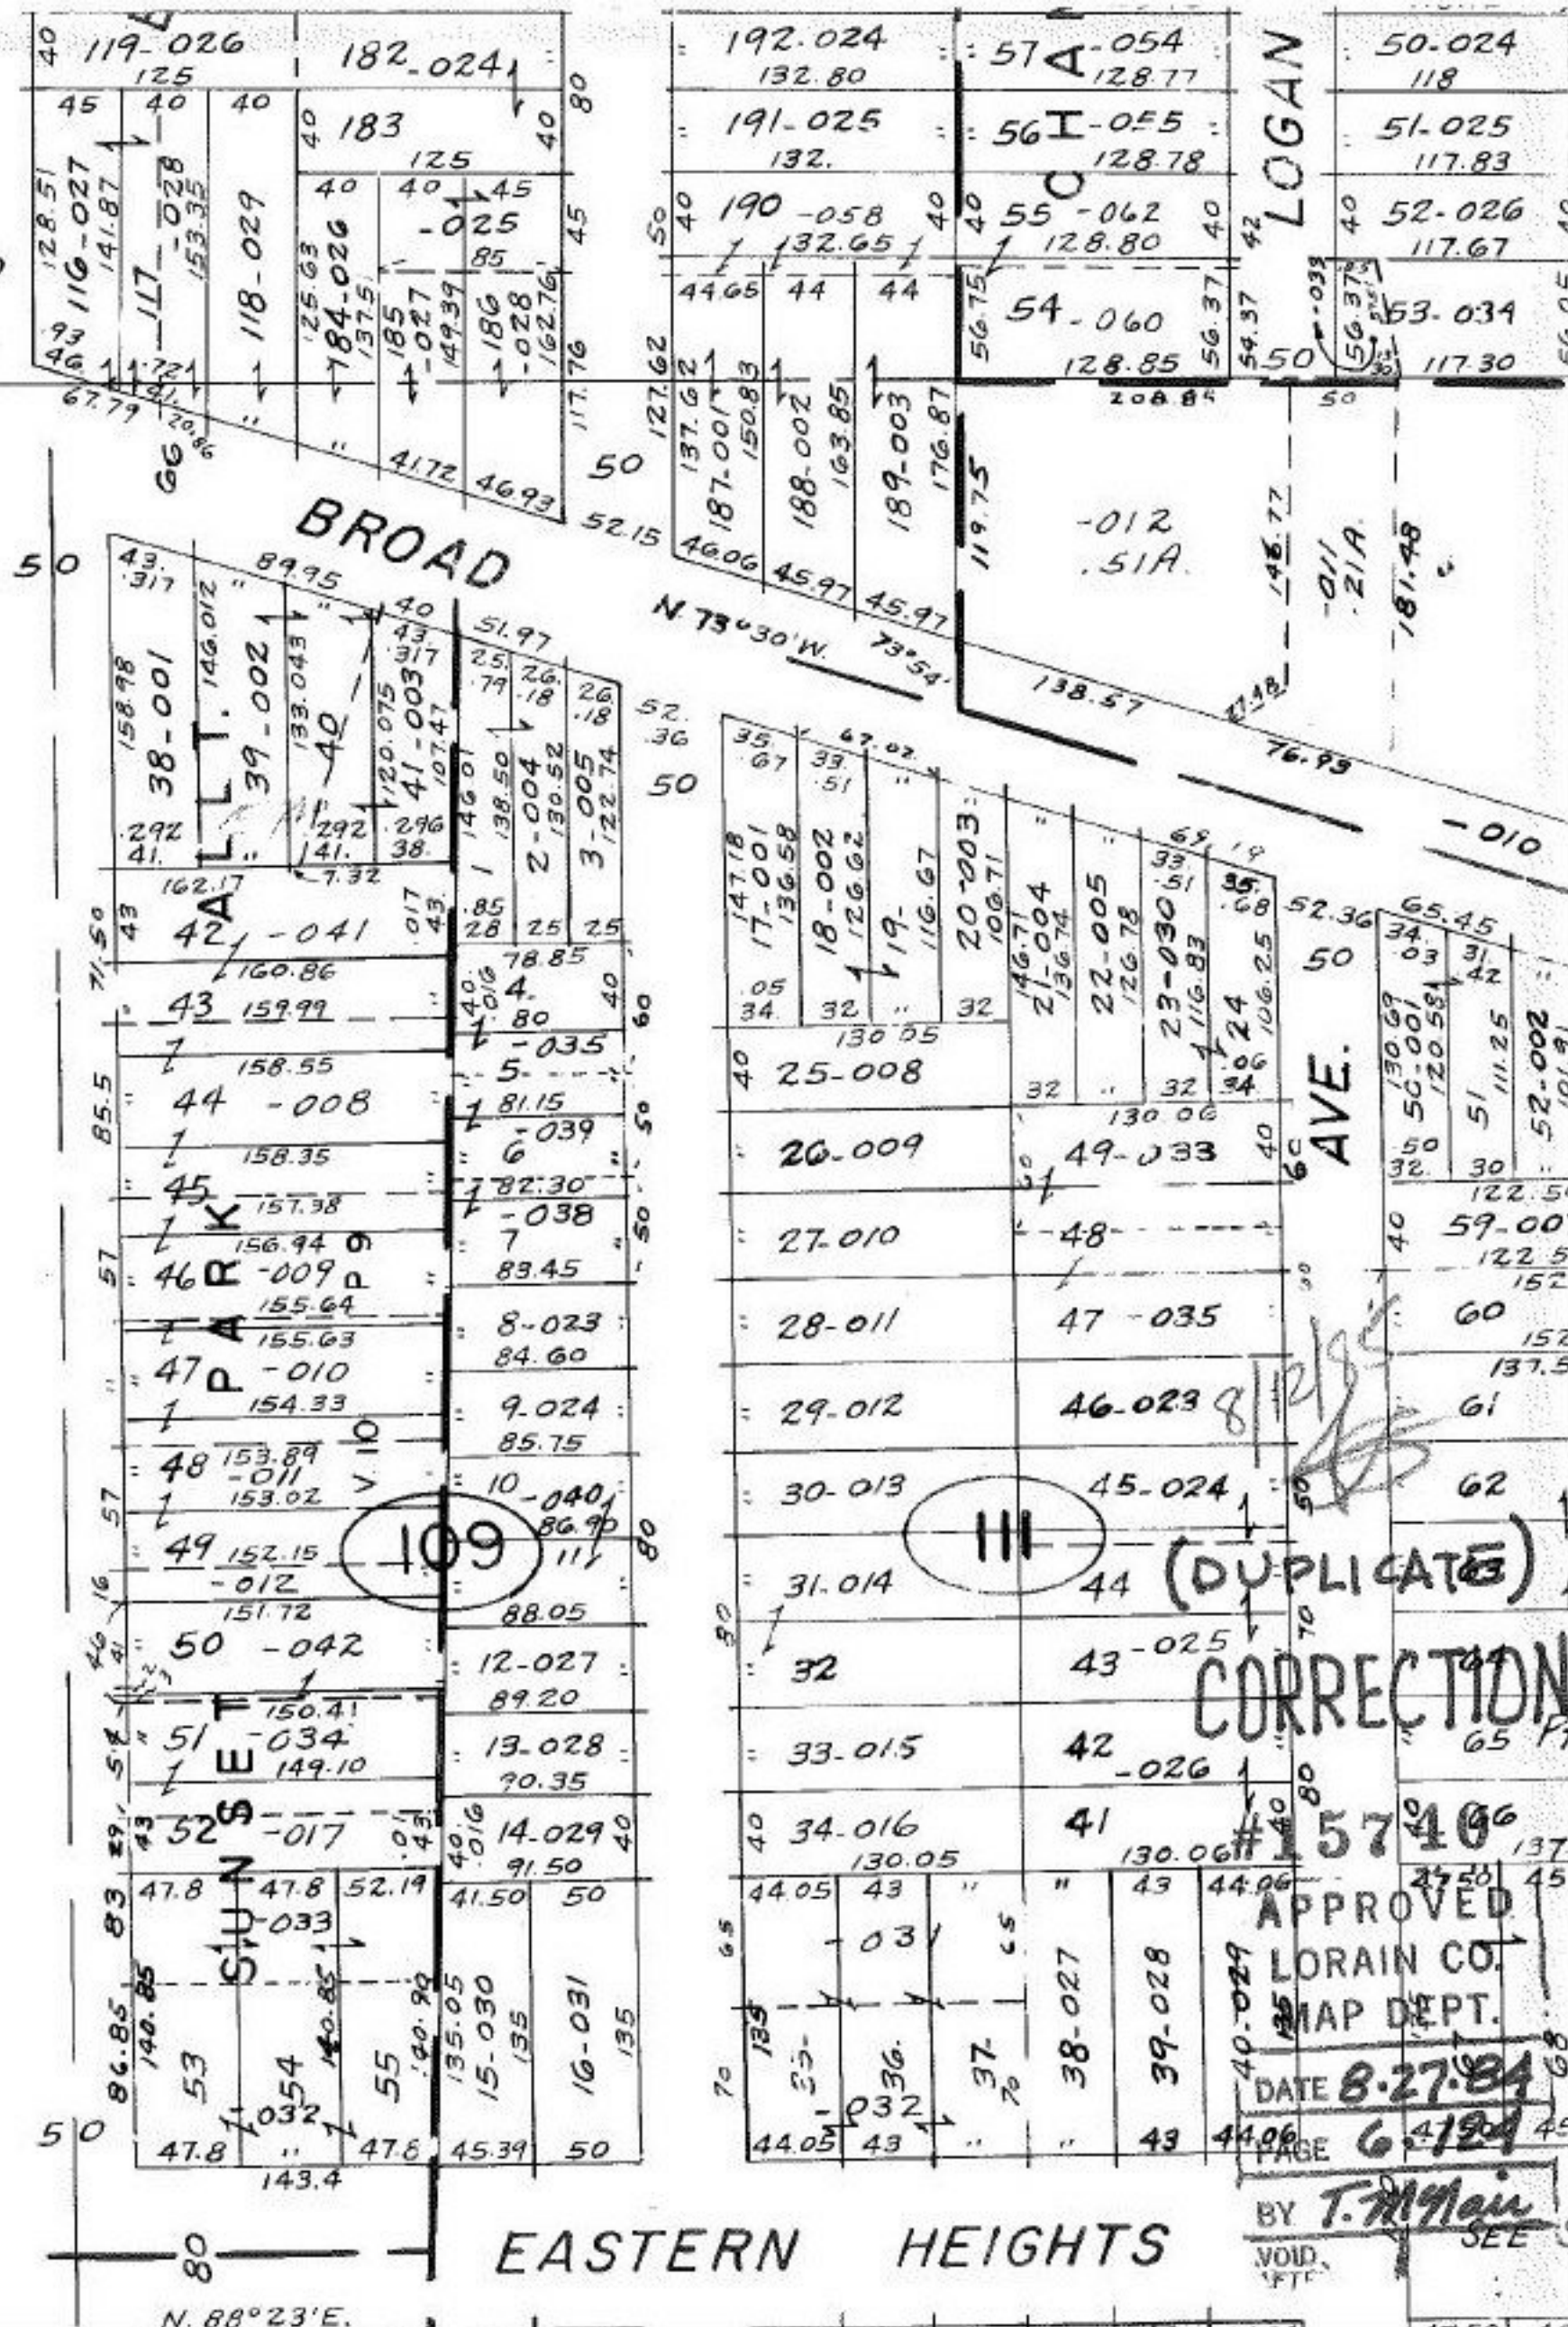

109

111

(DUPLICATE)
CORRECTION

APPROVED
LORAIN CO.
MAP DEPT.

DATE 8-27-84

PAGE 6-124

BY T. H. Main

VOID
IF TFC

EASTERN HEIGHTS

N. 88°23'E.