


SEE PARCEL MAP
M. G. HURA

Pt. 08-00-100-000-018
Pt. 19.67 A.

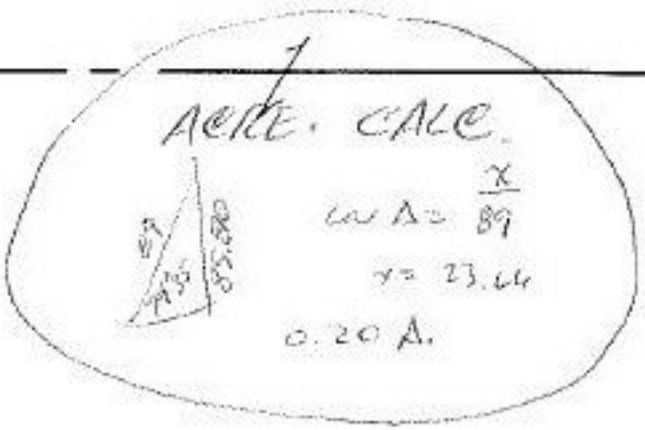

#15745
APPROVED
LORAIN CO.
MAP DEPT.

DATE 8-14-84
PAGE 8-00-093-A
BY T. McNeil

VOID
IF

D.G. 8-20-84

W 1/2 LOT 27