


110 + 87.32
786.37
526.31
260.06

SEE 4-00-017-G

CON. to Belmont Dr. 11
Sta 110 + 87.32

102

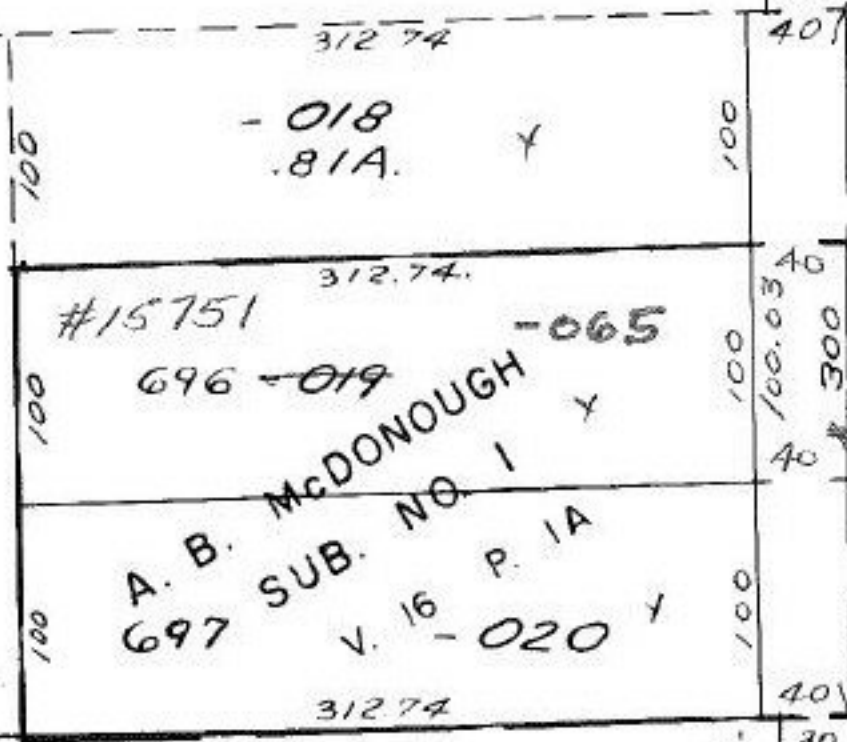

~~-064~~ 440C
0.09A.

-067
~~024~~ Y
9.75A.
3.61A.

AIWD
#15750

#15750
#15751

APPROVED	
LORAIN CO.	
MAP DEPT.	
DATE 8-26-84	
PAGE 4-00-017 F	
BY <i>F. A. [Signature]</i>	
VOID AFTER	15751

FEB 8 1985

AVON LAKE

F. A. 2/8/85