


LORAIN COUNTY MAP DEPT.
P. P. No. _____

130 + 04.23
126 + 03.10

4 + 01.13

Pt. -
Pt. 4

LORAIN COUNTY MAP DEPT.
P. P. No. _____

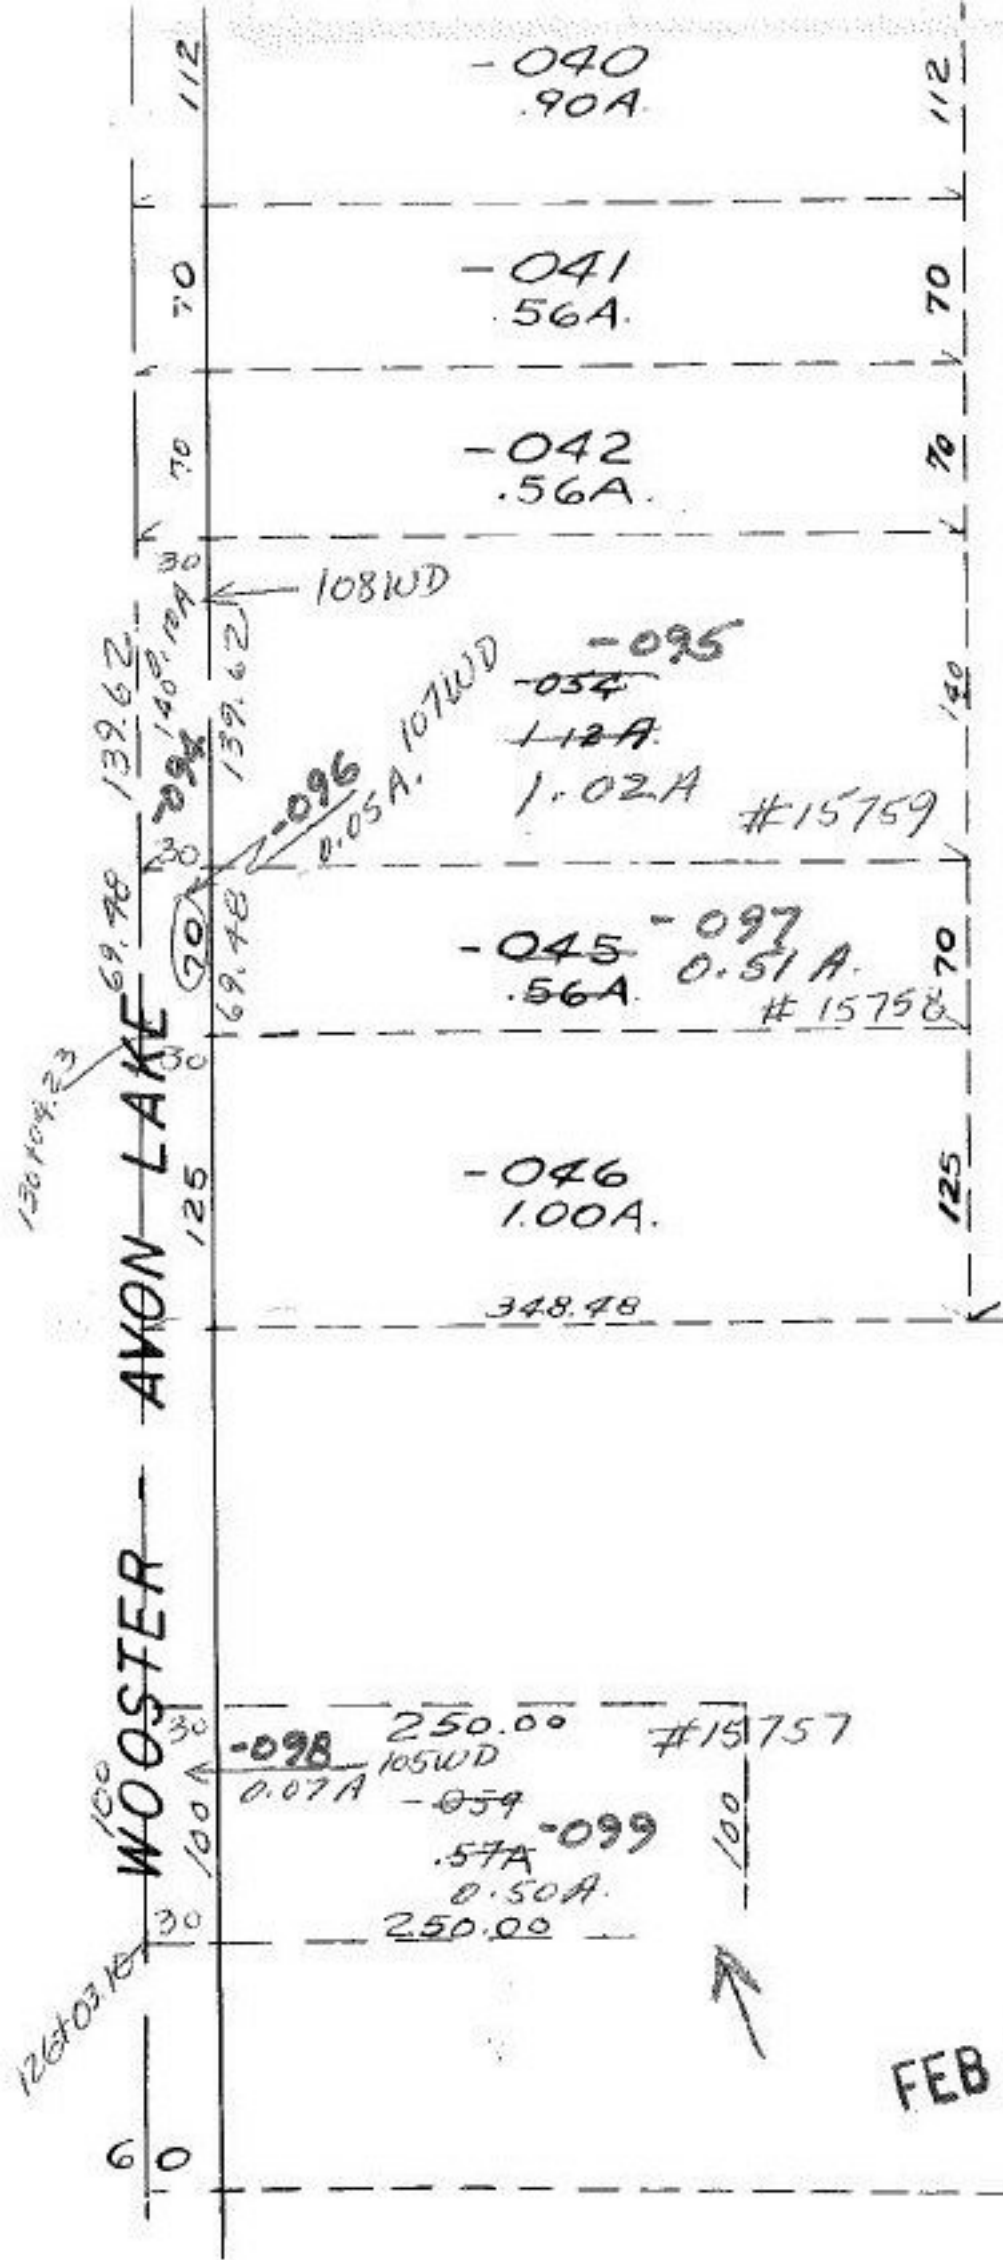

#15757

#15758

#15759

Pt. - 060
Pt. 24.43A.

APPROVED	
LORAIN CO.	
MAP DEPT.	
DATE 8-20-84	
PAGE 100-017C	
BY [Signature]	
VOID AFTER	1576A

FEB 8 1985

[Signature]

SEE 4-