

LORAIN COUNTY MAP DEPT.


P. P. No. \_\_\_\_\_

130 + 04.23  
126 + 03.10  
-----  
4 + 01.13

Pt. -  
Pt. 4

LORAIN COUNTY MAP DEPT.

P. P. No. \_\_\_\_\_

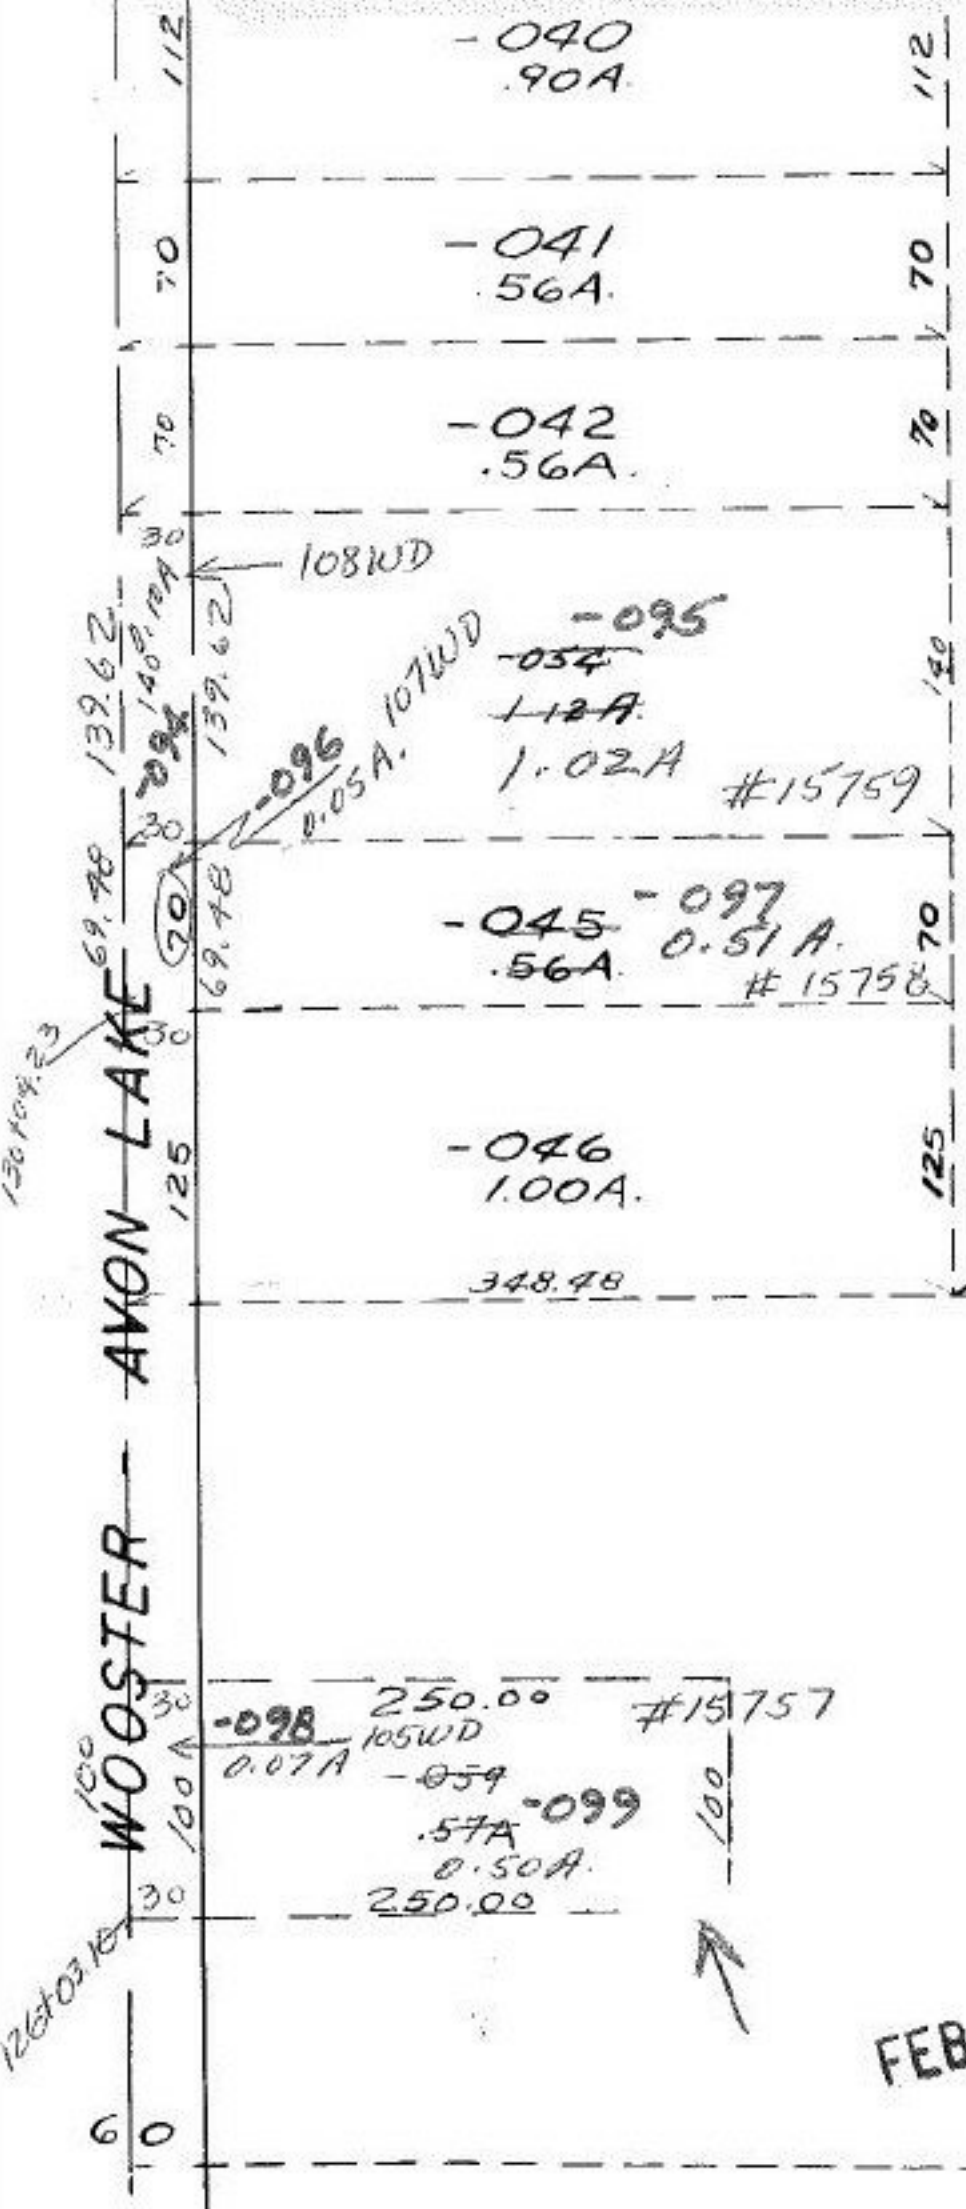

#15757

#15758

#15759

Pt. - 060  
Pt. 24.43A.

APPROVED	
LORAIN CO.	
MAP DEPT.	
DATE 8-20-84	
PAGE 100-017C	
BY [Signature]	
VOID AFTER	15764

FEB 8 1985

[Signature]

SEE 4 -