


LORAIN COUNTY MAP DEPT.  
P. P. No. \_\_\_\_\_

130 + 04.23  
126 + 03.10  
-----  
4 + 01.13

Pt. -  
Pt. 4

LORAIN COUNTY MAP DEPT.  
P. P. No. \_\_\_\_\_

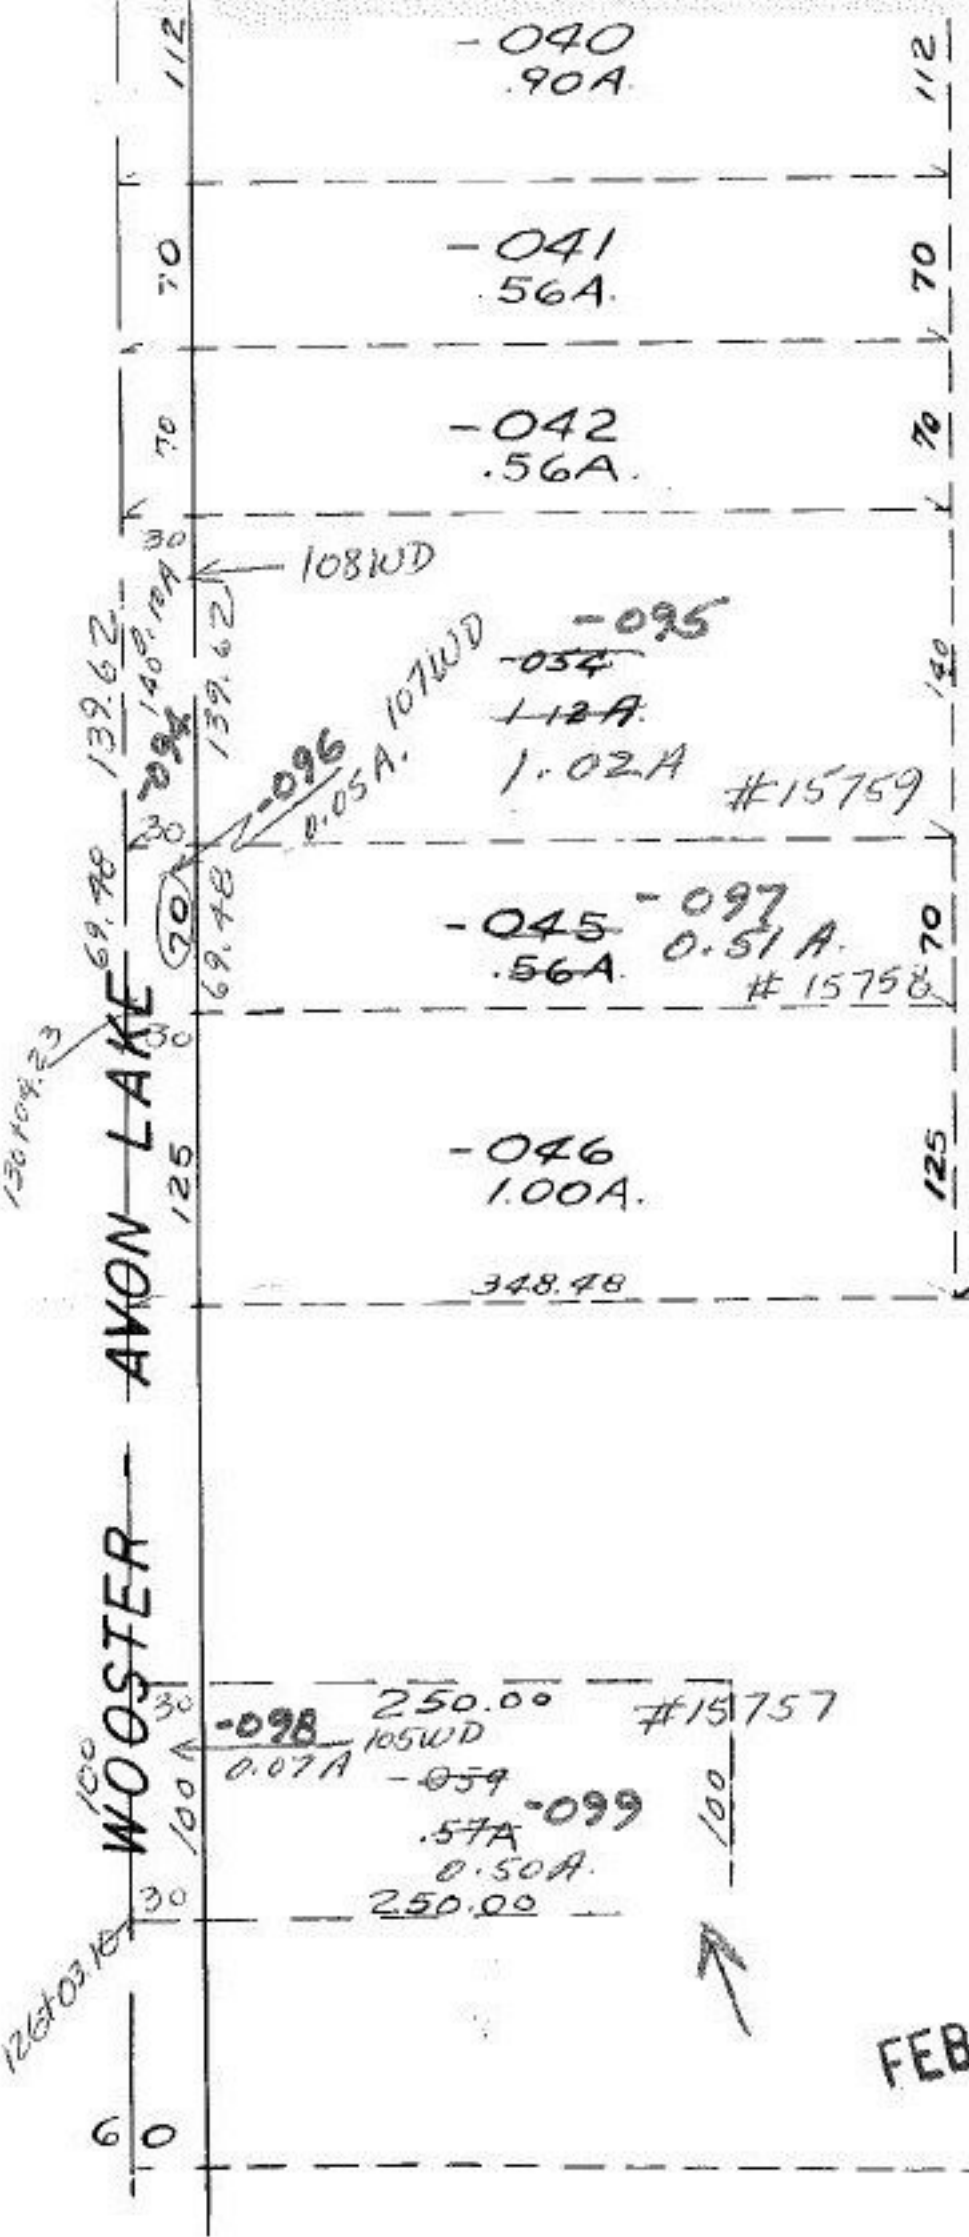

103

#15757  
#15758  
#15759

Pt. - 060  
Pt. 24.43A.

FEB 8 1985

*[Handwritten signature]*

APPROVED	
LORAIN CO.	
MAP DEPT.	
DATE 8-20-84	
PAGE 100-017C	
BY <i>[Signature]</i>	
VOID AFTER	15764

SEE 4 -