


1268 25 TO HWY BOX - N.E. 1/4  
CL. 83

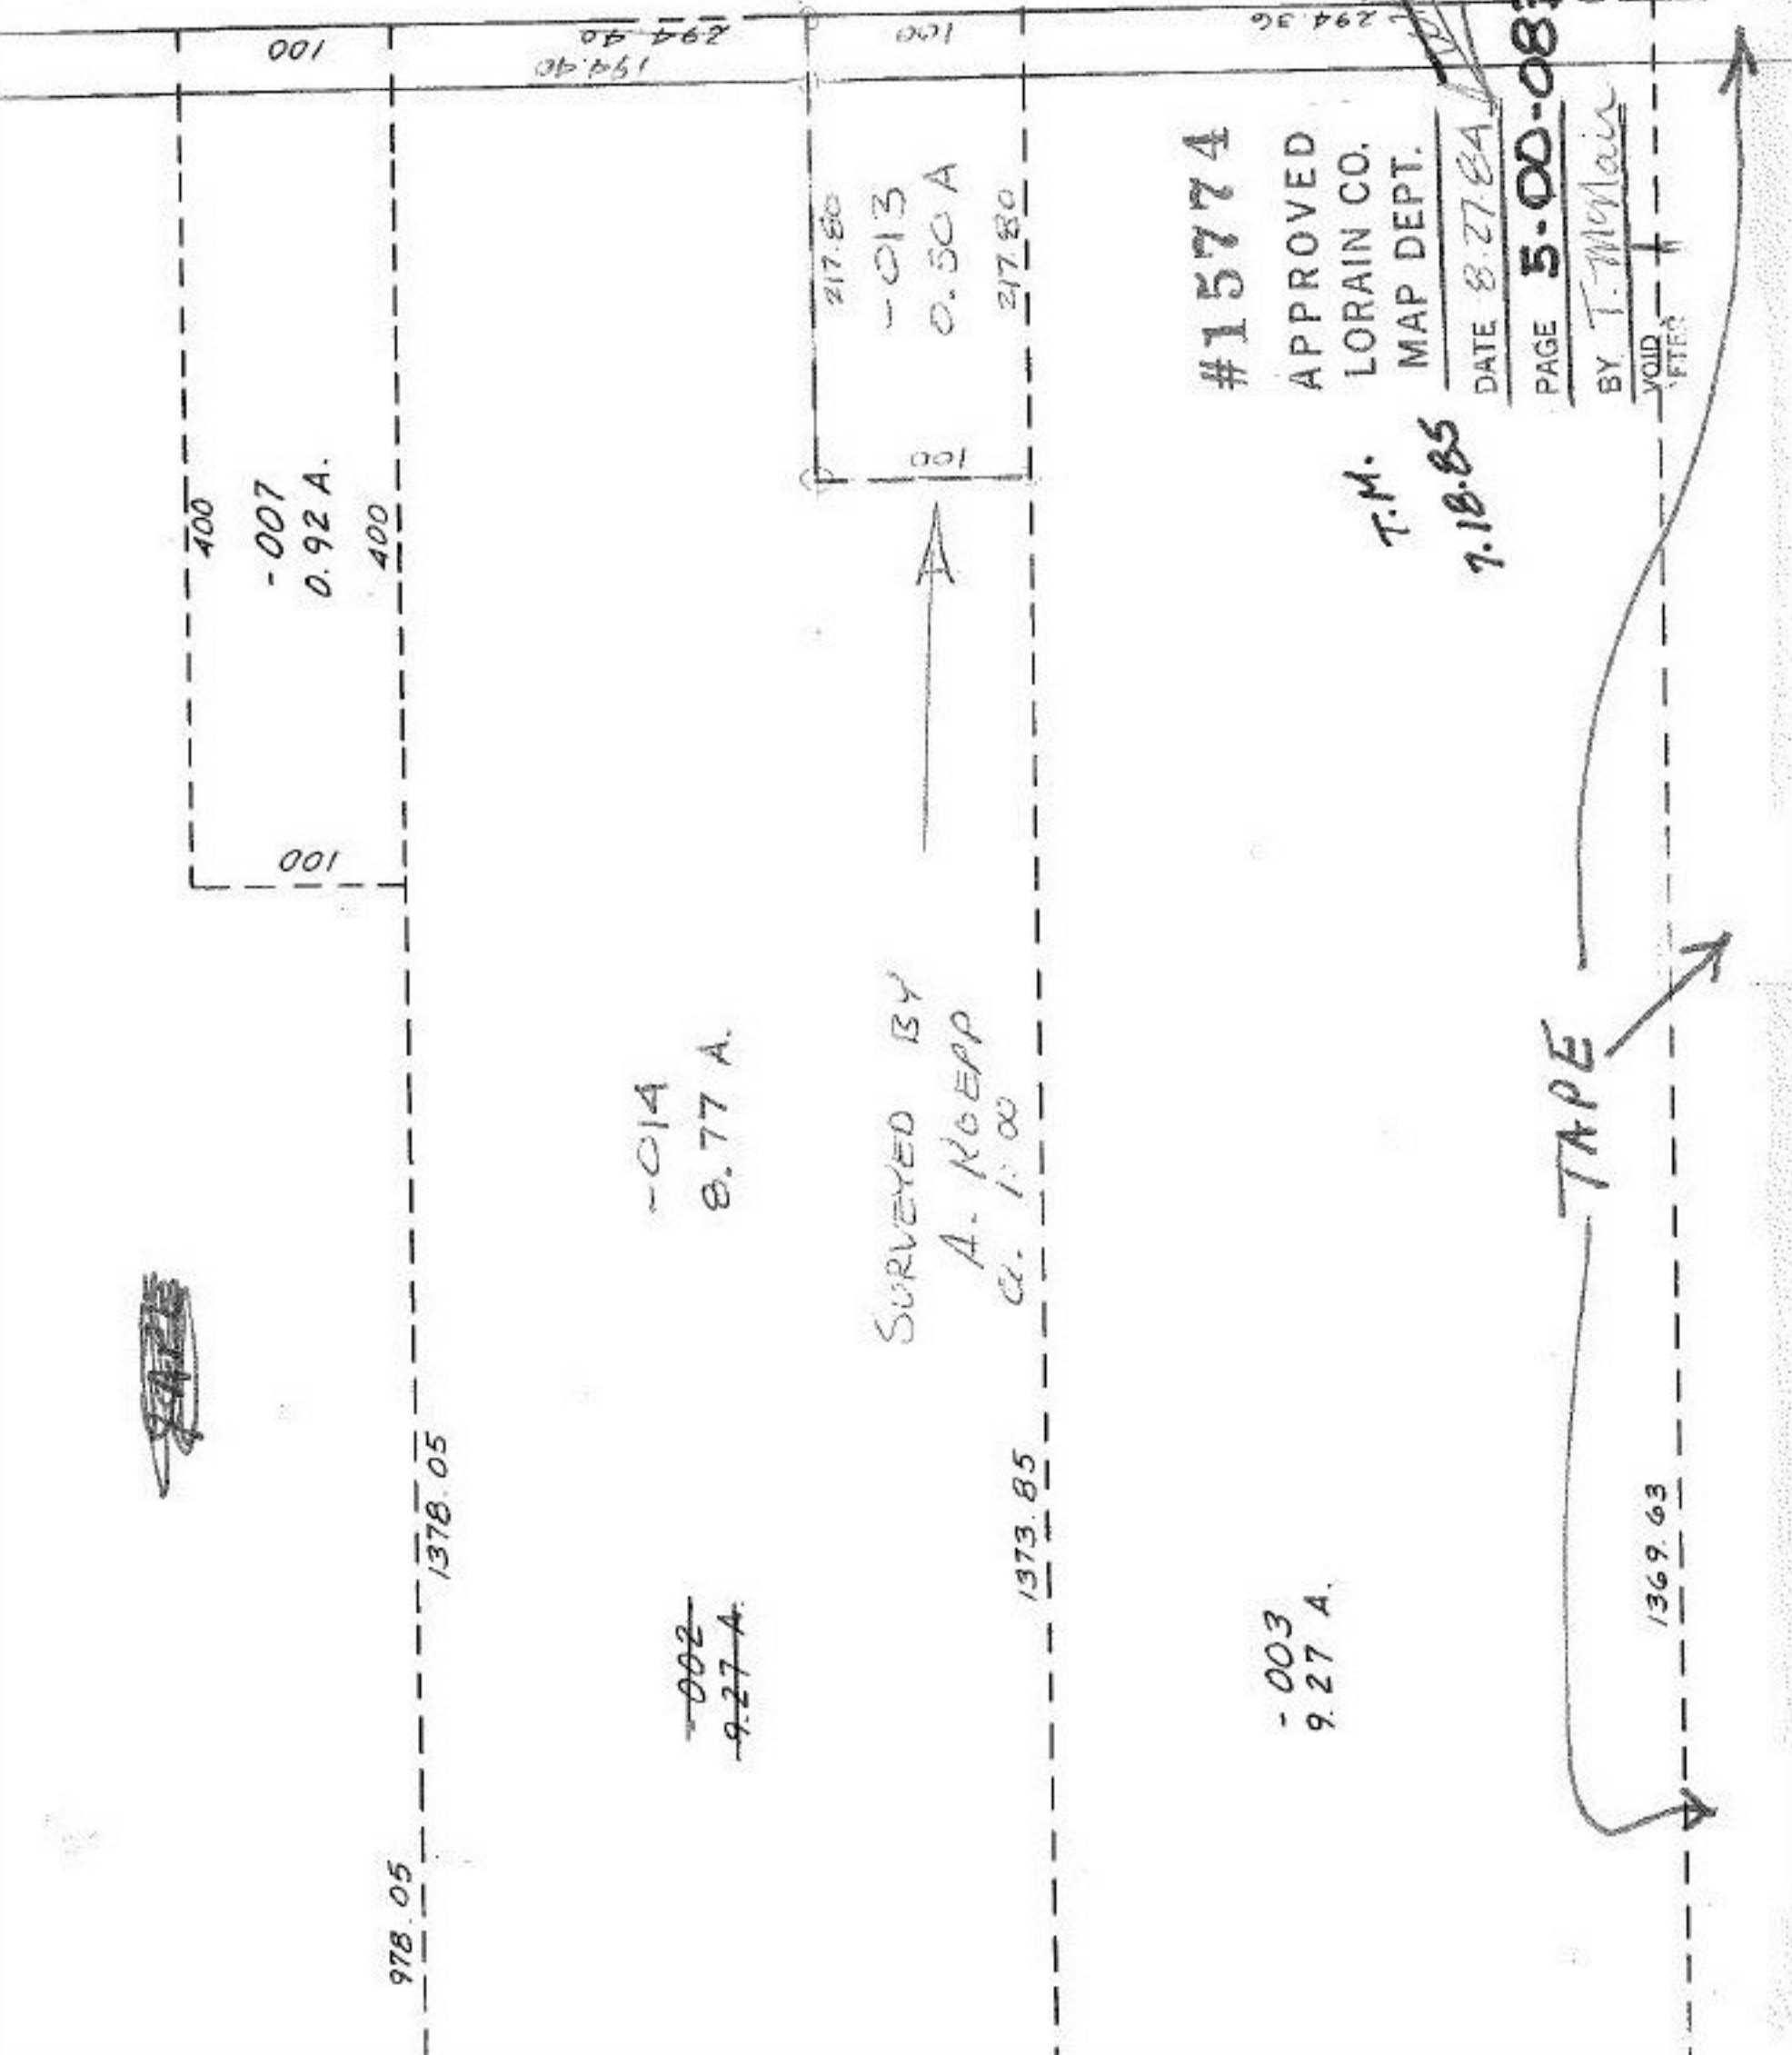

100  
400  
-007  
0.92 A.  
400

-014  
0.77 A.

~~-002~~  
~~9.27 A.~~

SURVEYED BY  
A. ROEPP  
ca. 1.00

217.80  
-013  
0.50 A  
217.80

1373.85

-003  
9.27 A.

#15774

APPROVED  
LORAIN CO.  
MAP DEPT.

T.M.  
7.18.85

DATE 8.27.84

PAGE 5-00-083

BY T. Main

VOID  
AFTER

TAPE

1369.63

978.05

1378.05

100

194.40  
294.40

100

294.36