


SEE 5-00-098-C

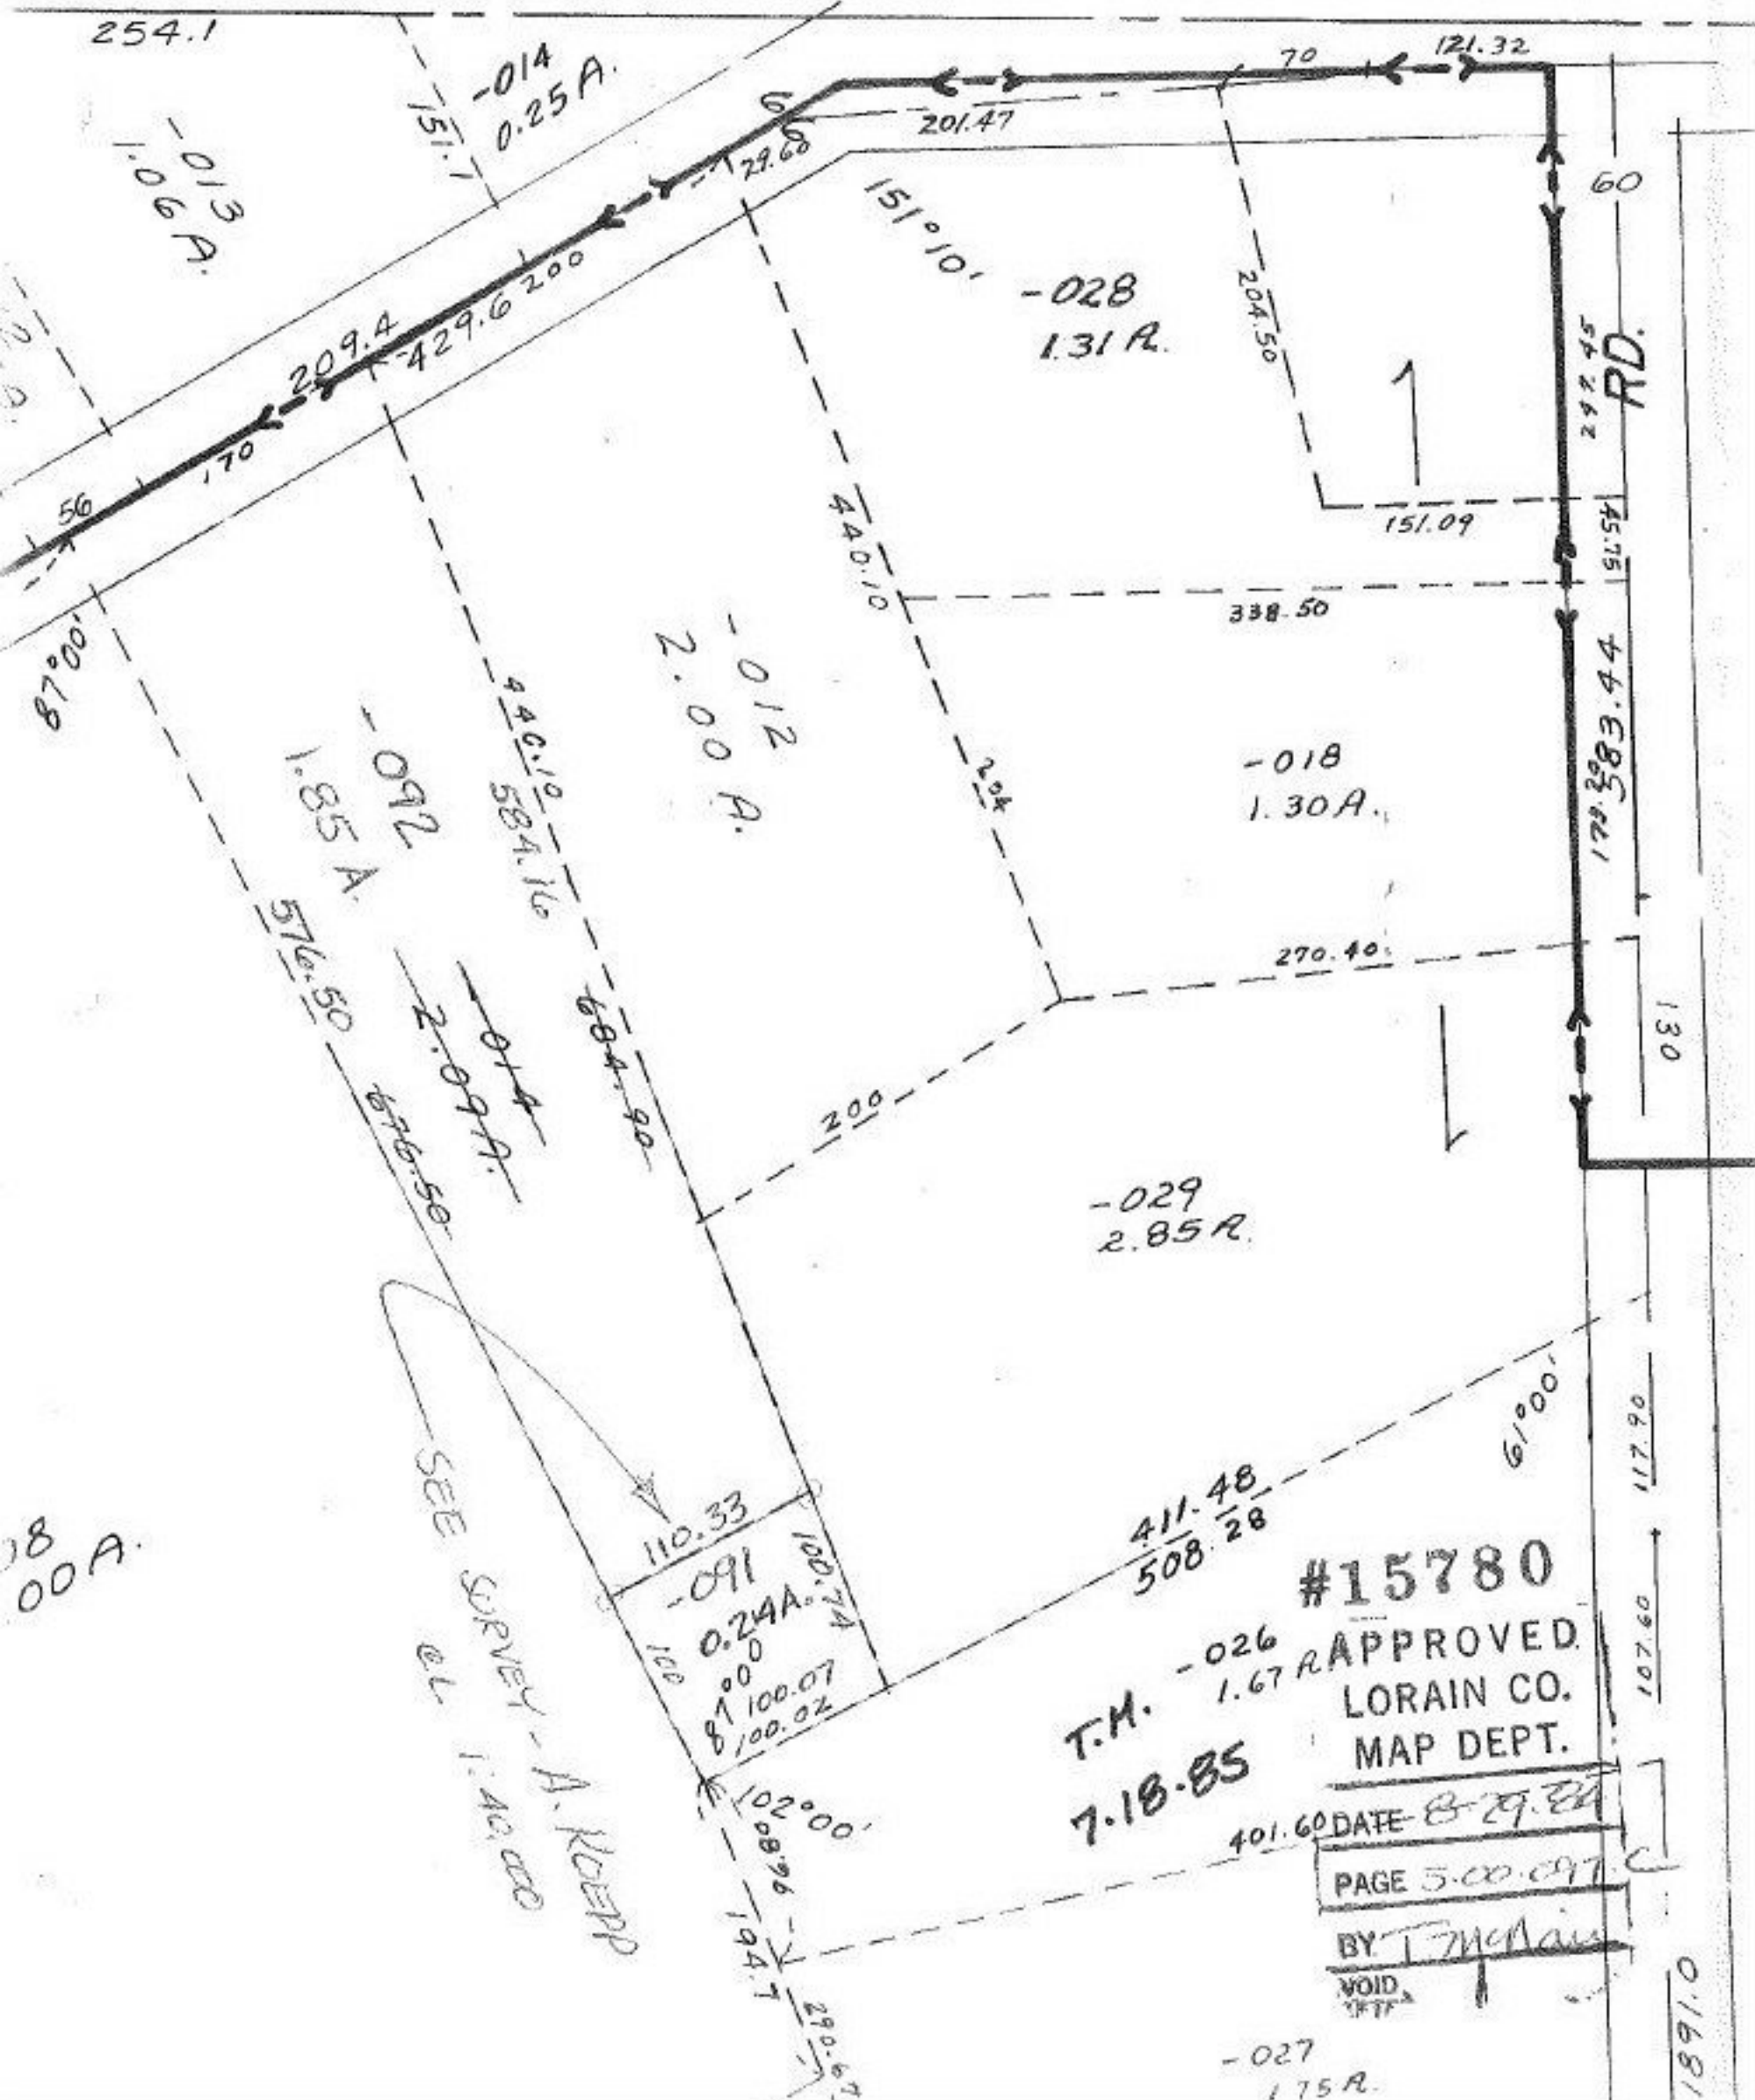

254.1

-013
1.06 A.

-014
0.25 A.

209.4

429.6

201.47

70

121.32

151°10'

-028
1.31 A.

204.50

151.09

60

RD.

338.50

-012
2.00 A.

440.10

-018
1.30 A.

270.40

45.75

179.383.44

130

-029
2.85 A.

-092
1.85 A.

446.10
584.16

-014
2.09 A.

676.50

684.90

200

411.48
508.28

61°00'

09.711

09.701

08
00 A.

SEE SURVEY - A. KREPP
SEE SURVEY - 140,000

110.33

-091
0.24 A.

100.74

87.00
100.07
100.02

T.M. -026
1.67 A.

7.18.85

#15780

APPROVED
LORAIN CO.
MAP DEPT.

401.60 DATE 8-29-84

PAGE 5-00-097-C

BY T. McNeil

VOID
IF TORN

-027
1.75 A.

01681