


SEE 5-00-015-B

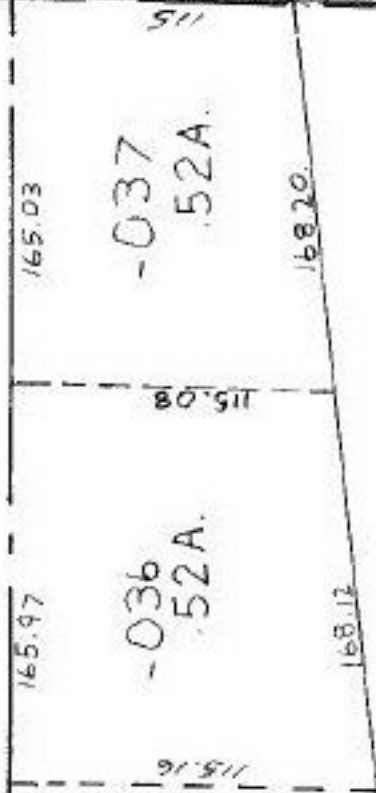

Pt. -035

Pt. ~~034A~~

S. EC A

SEE P.V. 1207/301 w/ EXCEPTION

1135/305

Pt. -015

247.64  
 Completed on  
 Page 5-00-015-B

#15809

APPROVED.  
LORAIN CO.  
MAP DEPT.

DATE 9 14 84

PAGE 5-00-015-B

BY T. McManis

VOID  
IF  
RETR

3-31-86

TURNPIKE