


05-D

006
2.A.1.

B
74

5
6CA.

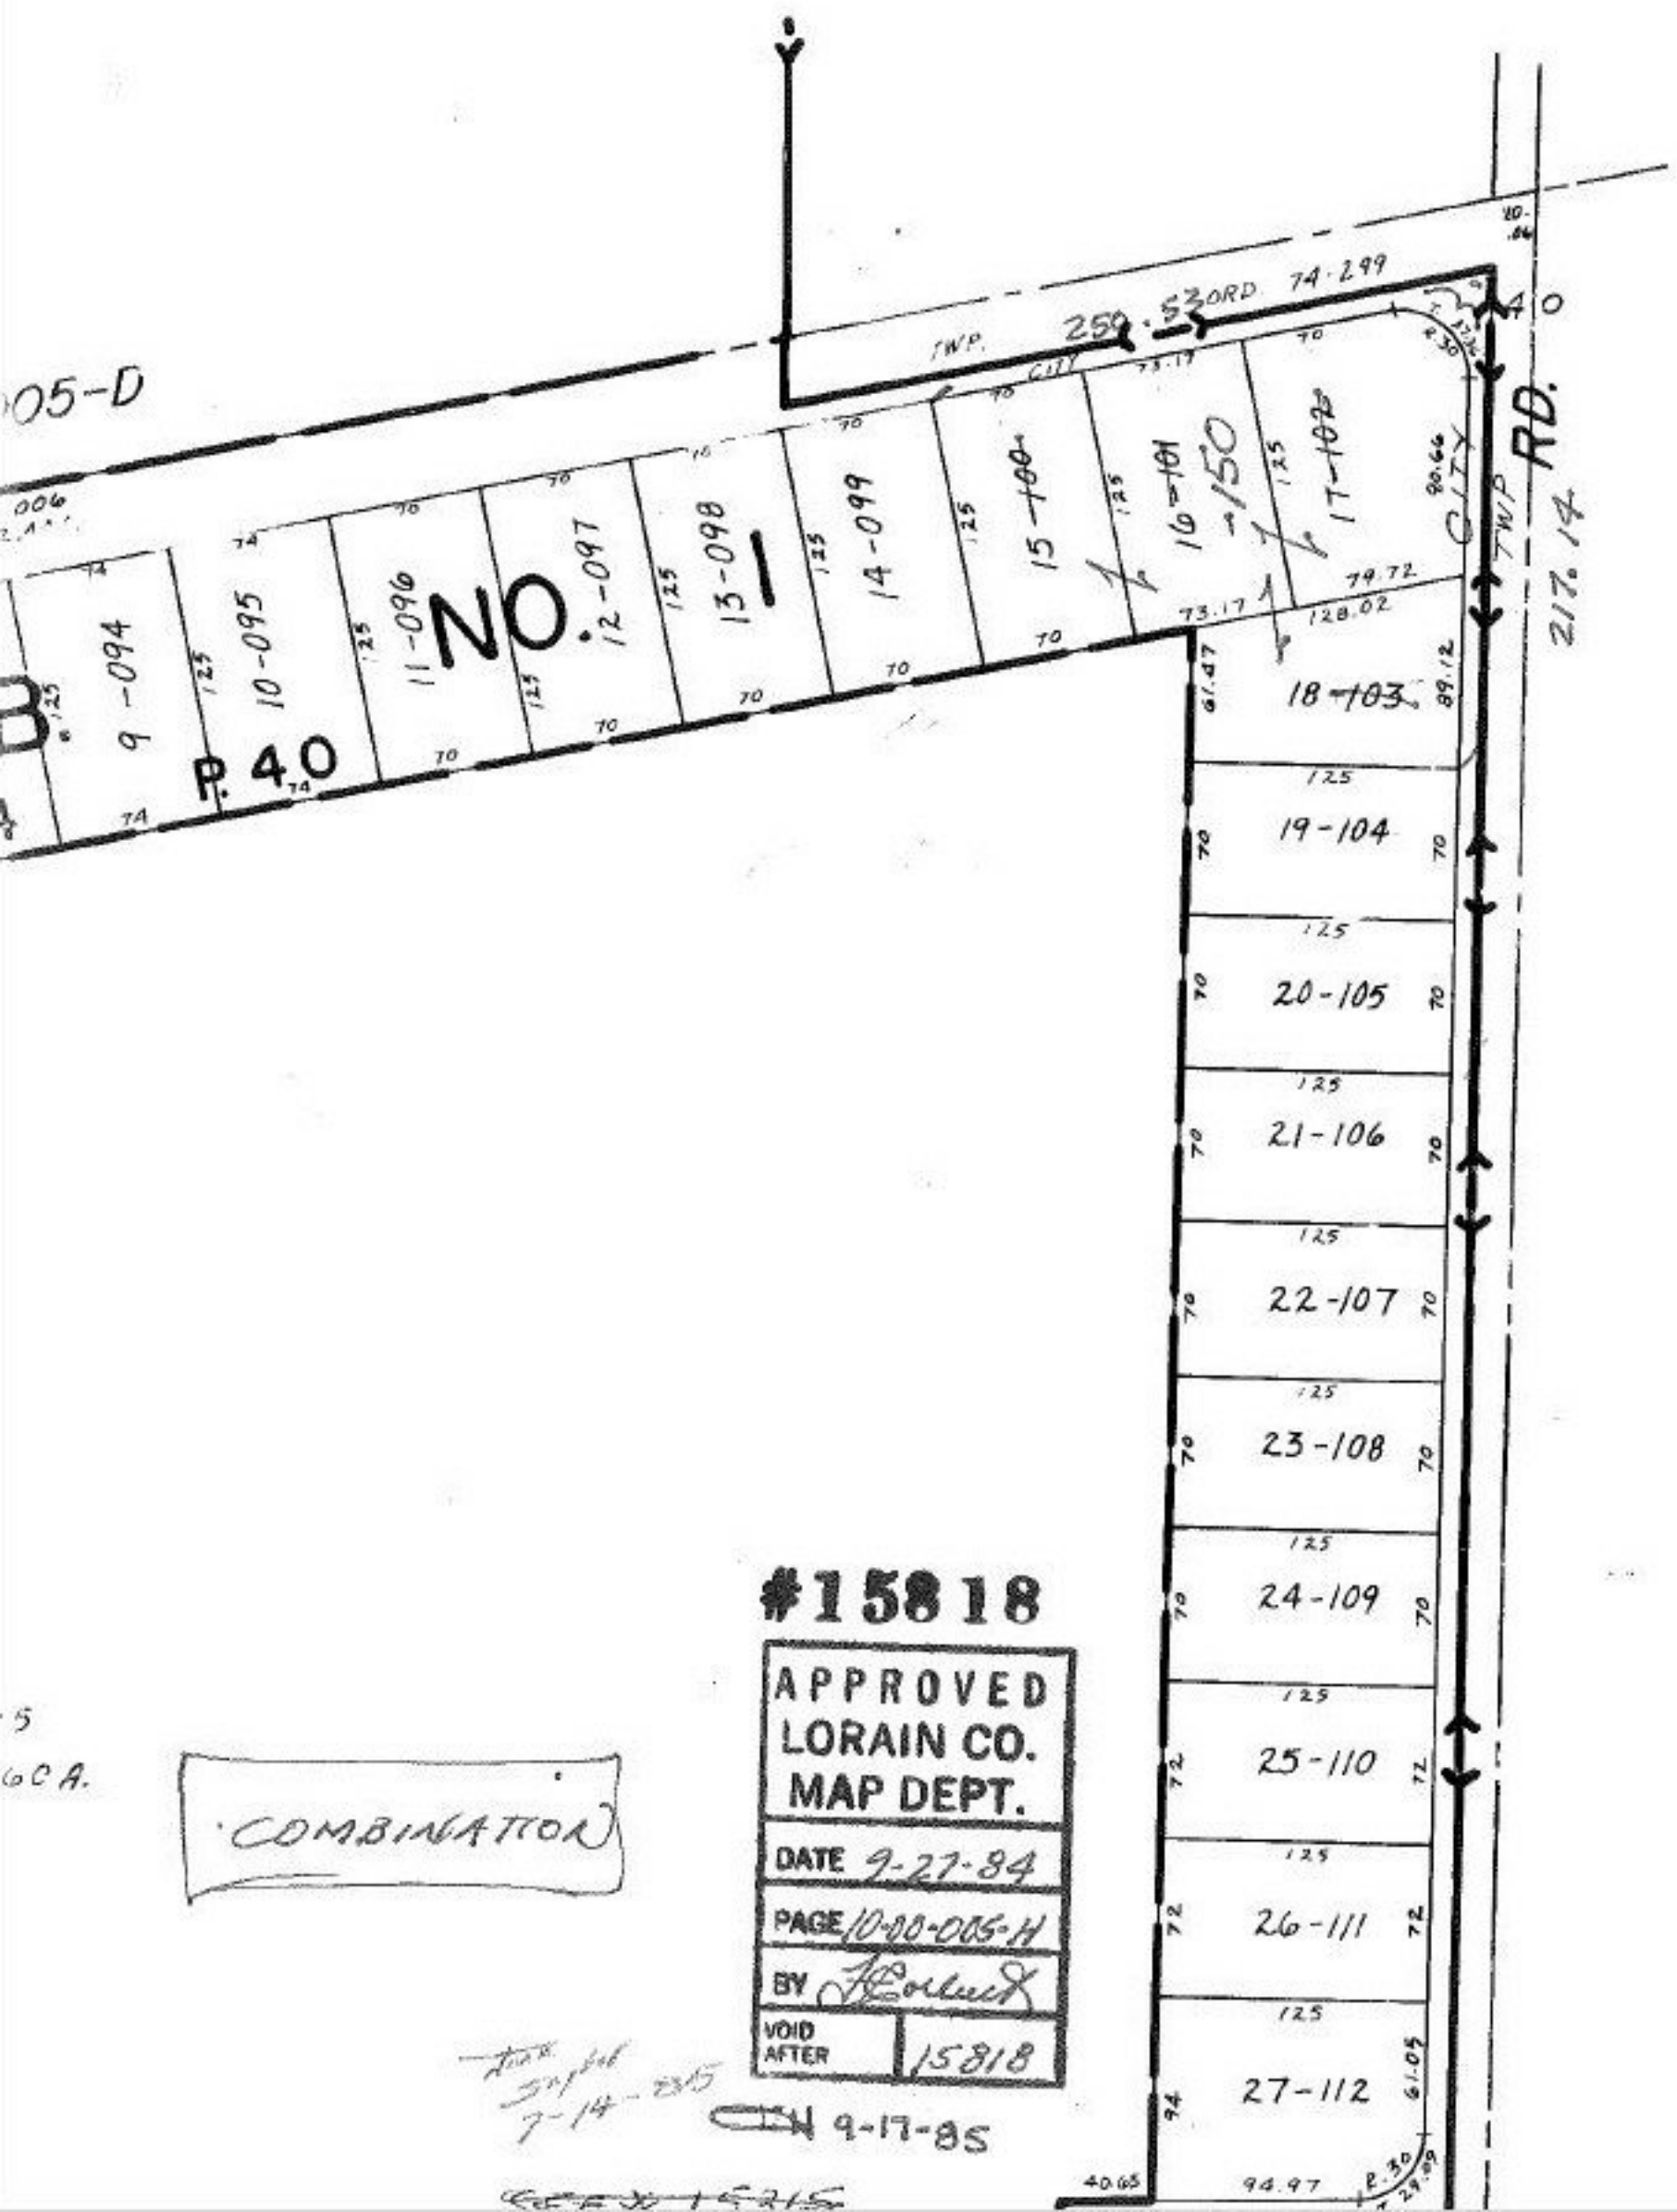

NO
P. 40

#15818

APPROVED
LORAIN CO.
MAP DEPT.
DATE 9-27-84
PAGE 10-00-005-H
BY *H. [Signature]*
VOID AFTER 15818

COMBINATION

SEE 15818
9-17-85

40.65

94.97

2.30

23.09

10.64

74.299

73.17

70

70

72

72

10.64

10.64

