


SEE 2-02-013-A

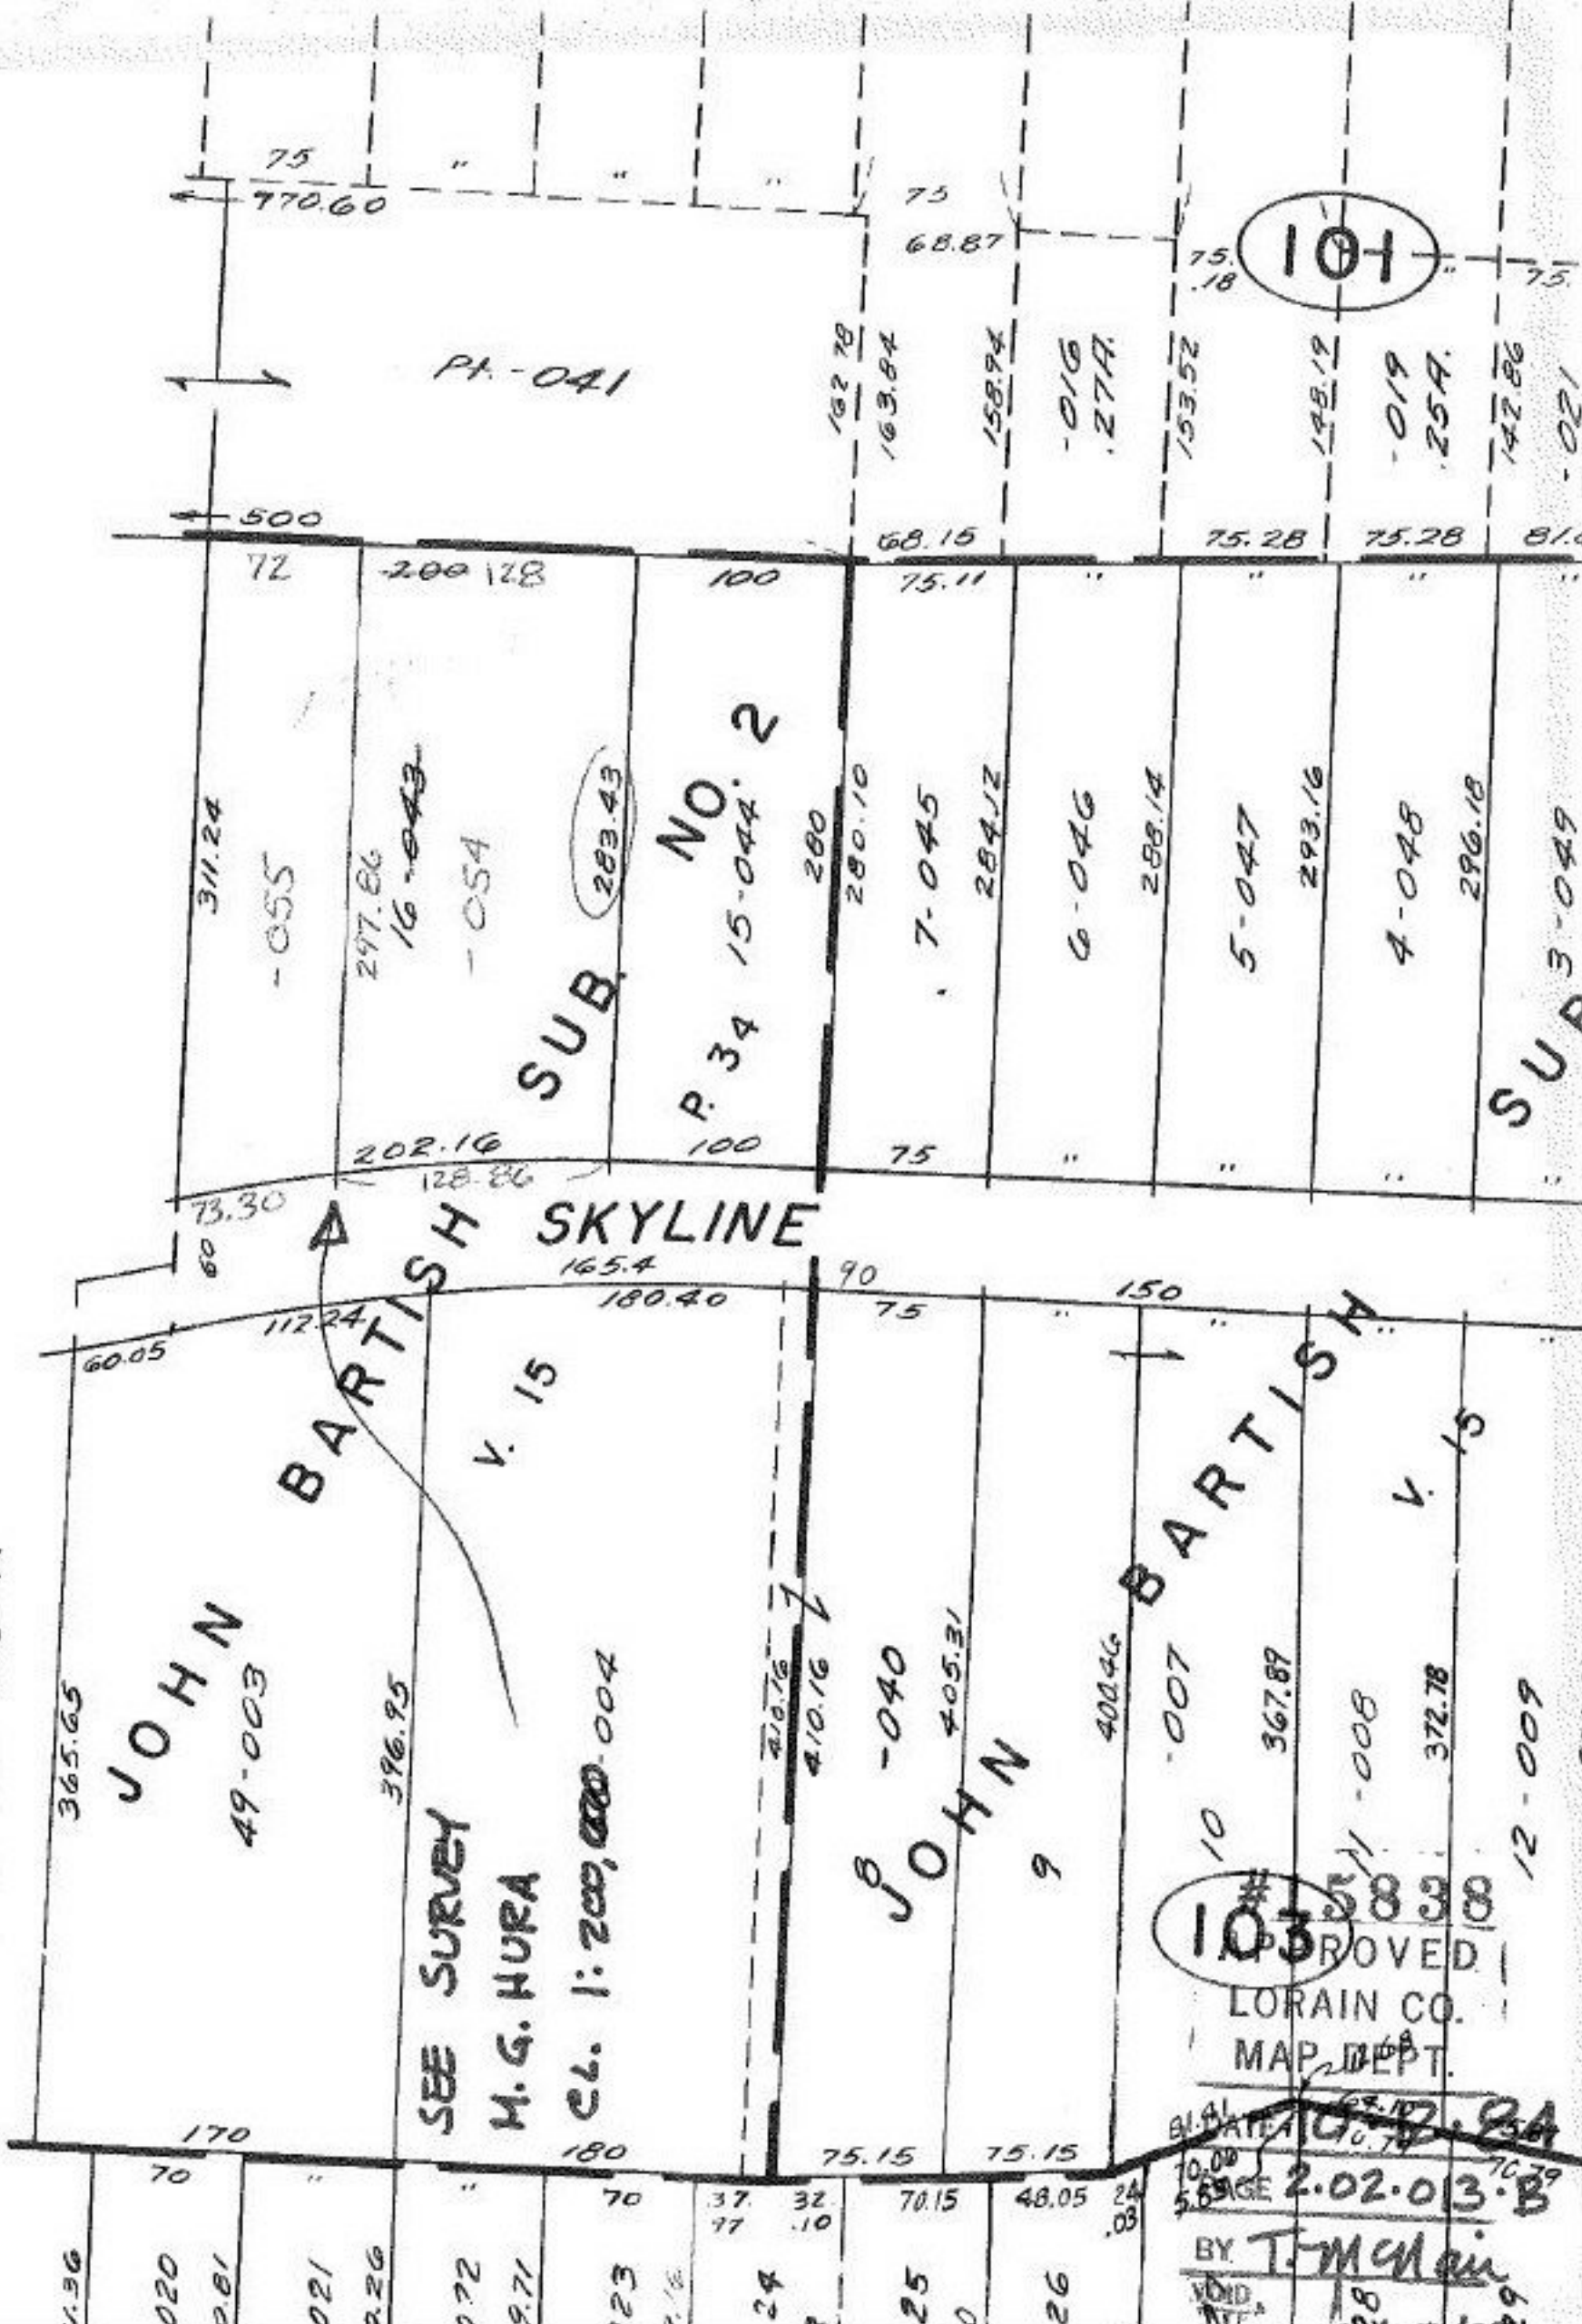

Pl-041

101

SUB. 283.43

P. 34 NO. 2 15-044

BARTISH SKYLINE

JOHN 49-003

SEE SURVEY M.G. HURA C.L. 1:200,000-004

JOHN 9

BARTISH

103 APPROVED LORAIN CO. MAP DEPT.

DATE 10-2-84 BY T. McLean

2-02-013-B