

RD.

18

878

200

191.9 65

(90)

-001
57.21A.

3114

1370.05


450.47

210.36

-006
10.23A.

864.52

413.80

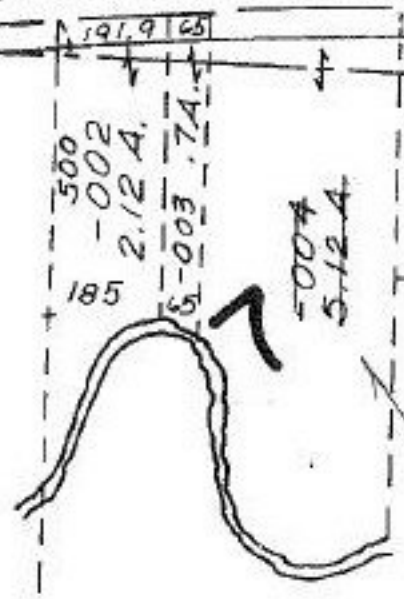

*Do Not Remove
Lines & Dims.
Frank Corbett*

575.52

-006
26.60A.

1504.14

14

-007
142.56A.

~~-001
109.44A. Dup.
110.45A. Map.~~

-007
36.61A.

536

#15852

APPROVED
LORAIN CO.
MAP DEPT.

DATE 10-16-84

PAGE 17-6

BY *Corbett*

VOID AFTER 15852

T.H. 4/23/85