


QUARRY

RD.

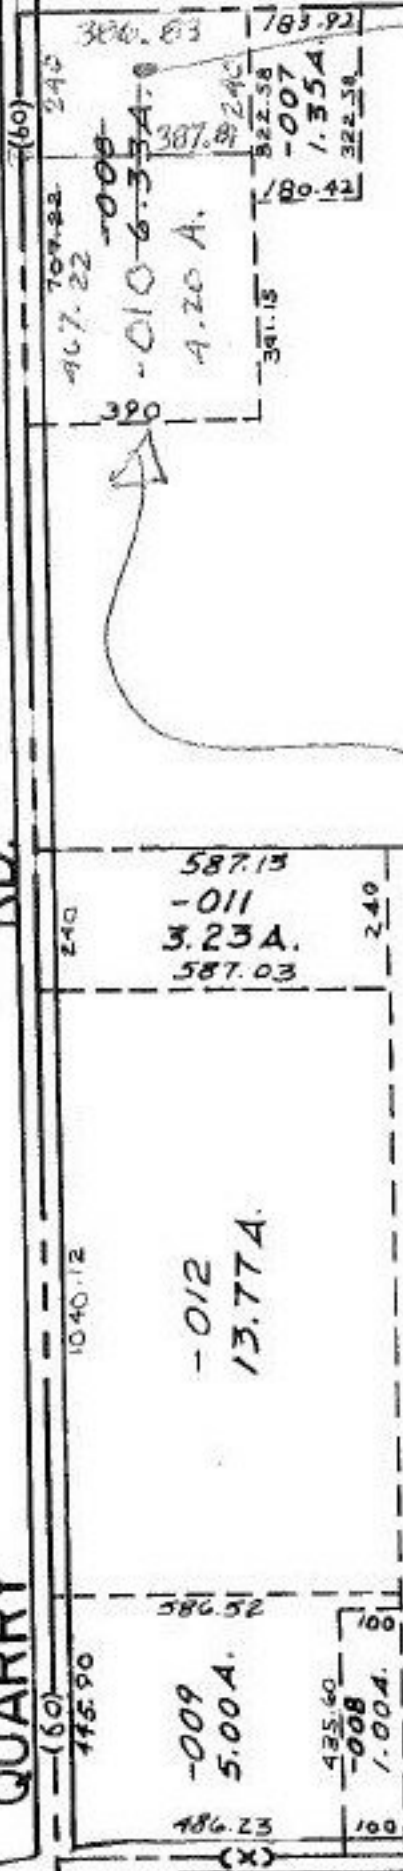

GRIGGS

-005  
64.16 A.

40

SEE PARCEL MAP BY  
KLEINLEDER. SCHMIDT

& ASSOC. at 1:500,000

-002  
60.67 A.

39

-003  
2.00 A.

6.33 A.

-003

#15854

APPROVED  
LORAIN CO.  
MAP DEPT.

DATE 10.19.84

PAGE 21. A

BY T. McNamee

VOID  
IF

T.H. 4/19/85

29232
126 -004
1.29 A.
294.25

128 0