

1589

APPROVED
LORAIN CO.
MAP DEPT.
DATE 3-13-68
10-64 F
BY <i>J. Ballwe</i>

(Signature)




CHARLISLE TWP.

SCALE: 1" = 400'

SECS. 17, E. 1/4

17, E. 1/4

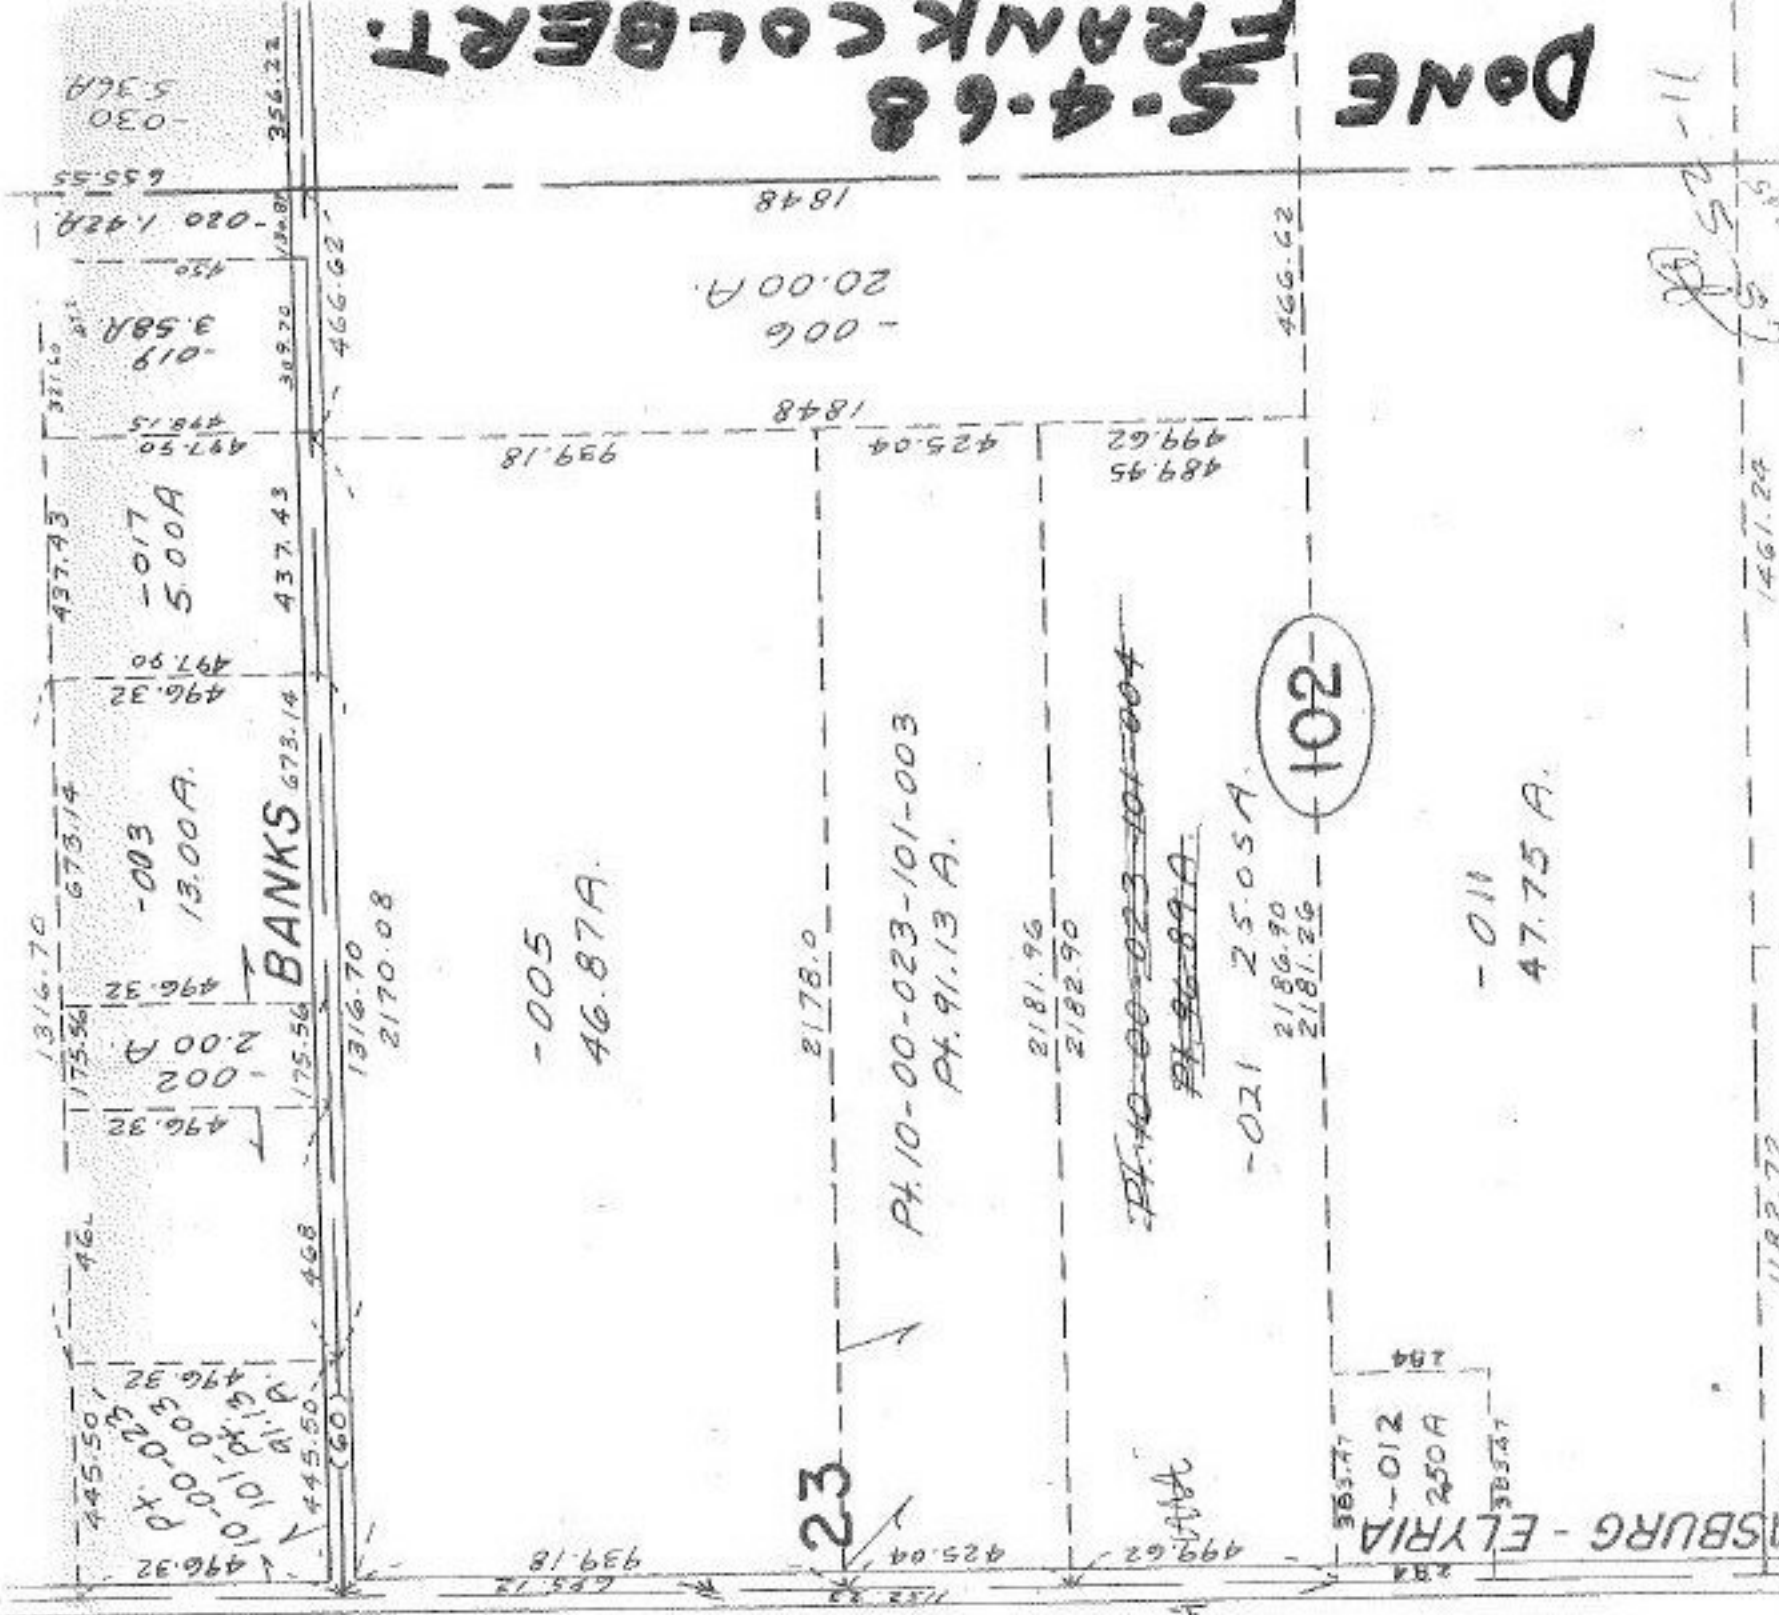

DONE 5-4-68 FRANK COLBERT.

(Signature)