
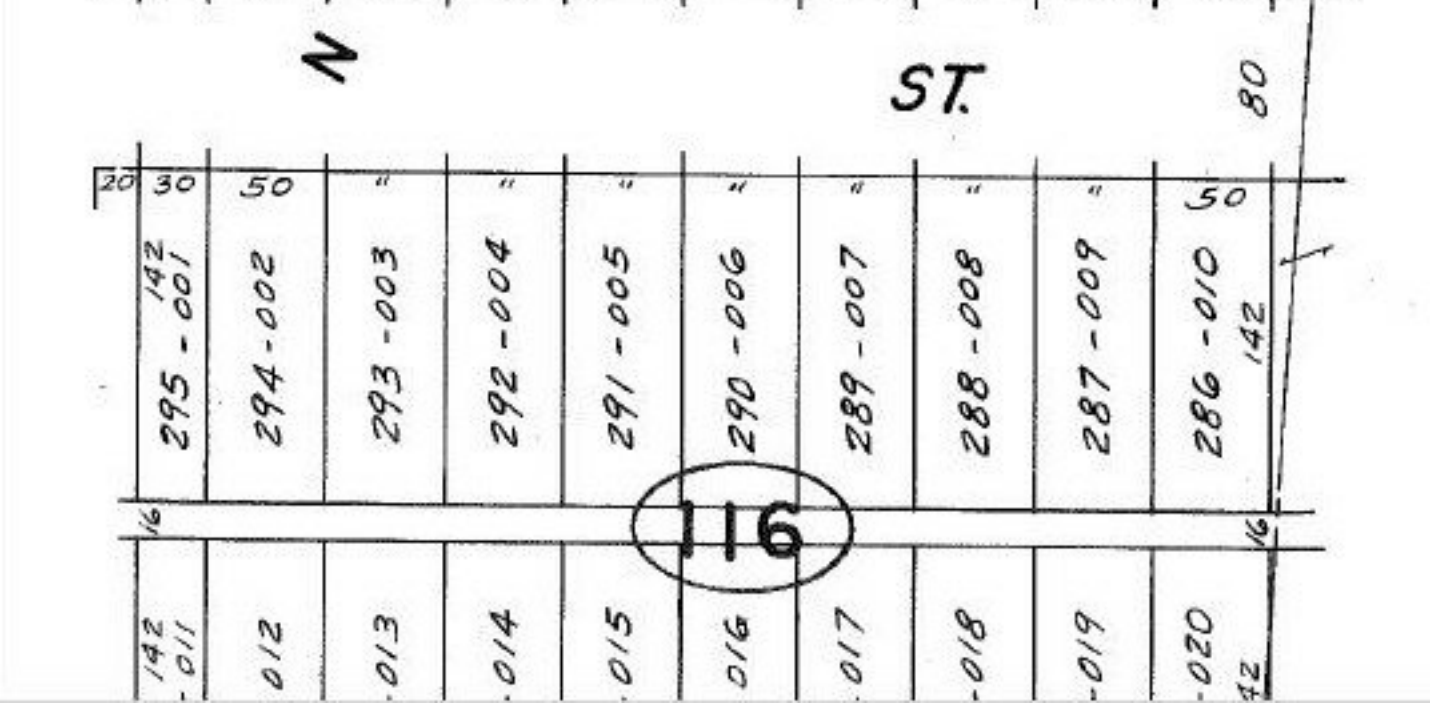
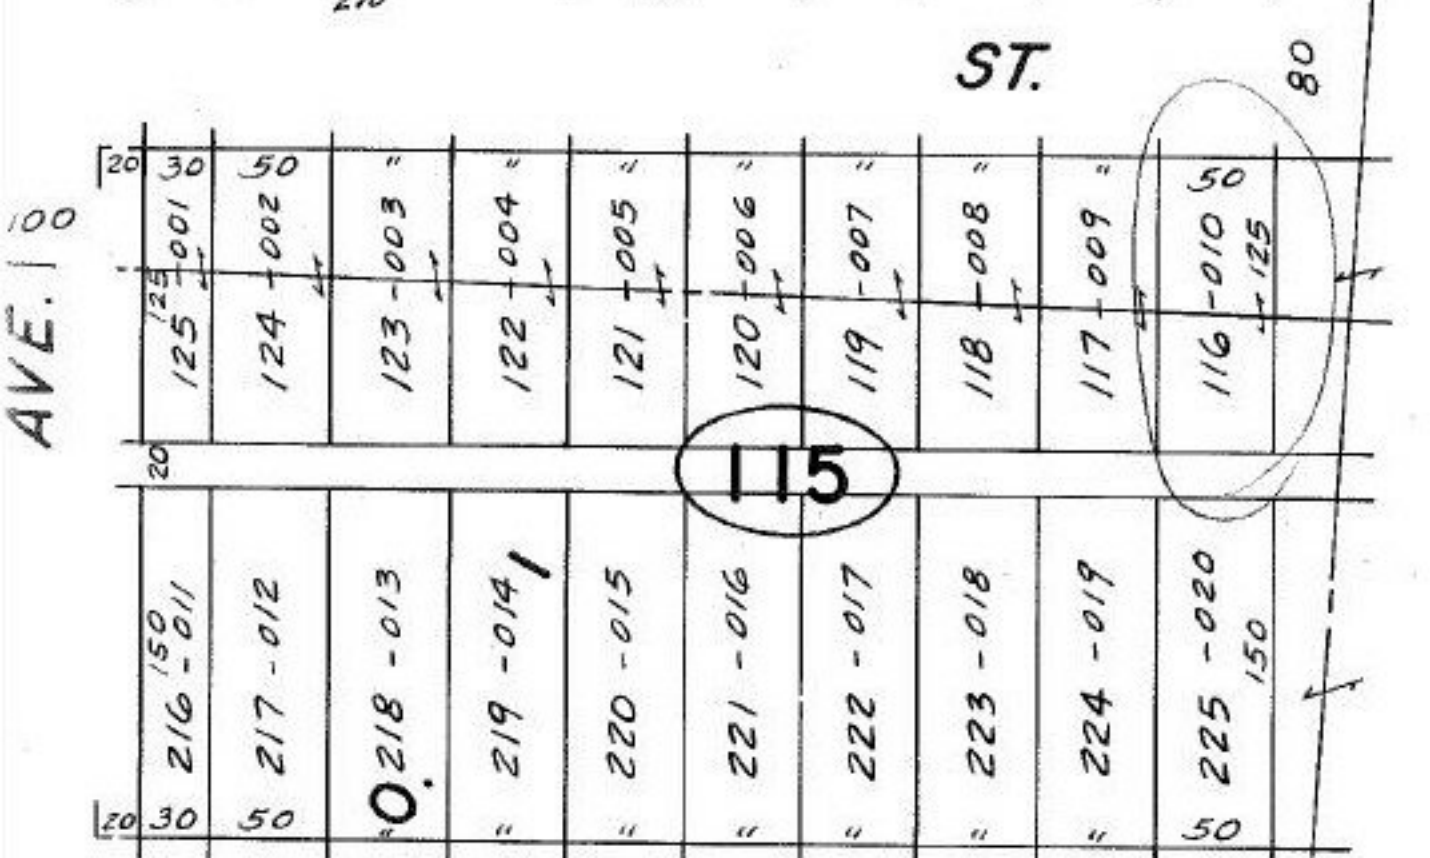


Pt. 03-00-083-101-006  
Pt. 806A.

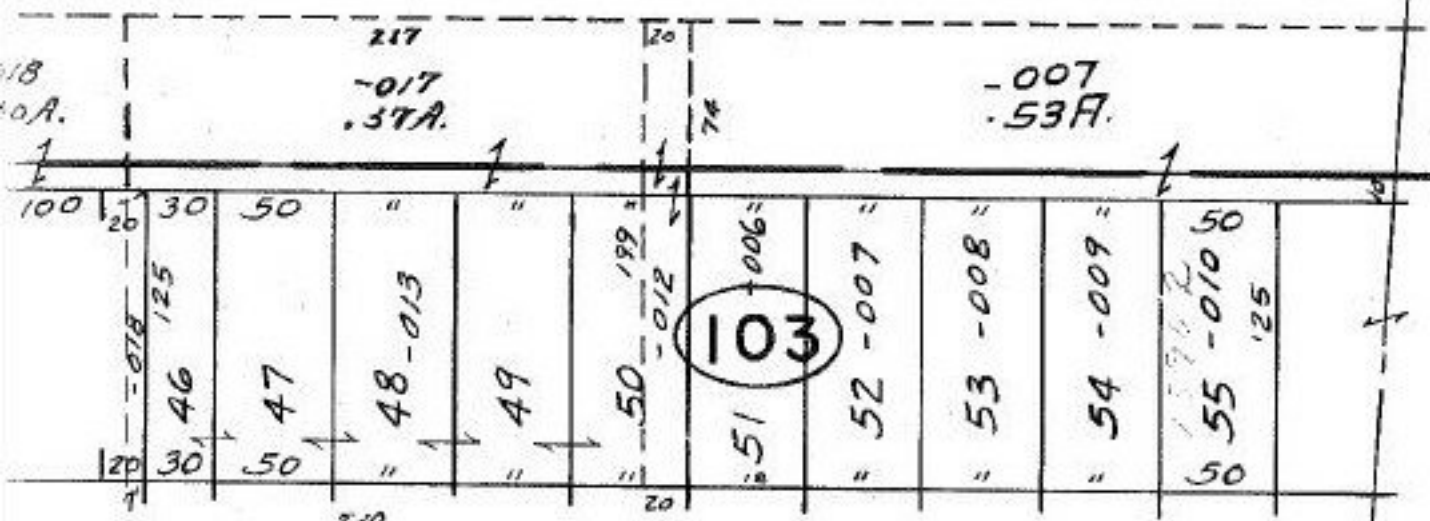

T.M.  
7.31.85

# SUBLOT NUMBER CORRECTION

#15902

APPROVED  
LORAIN CO.  
MAP DEPT.

DATE 11-19-84

PAGE 3-00-095-B

BY T. McNeil

VOID  
REISSUE