


SEE 11-H

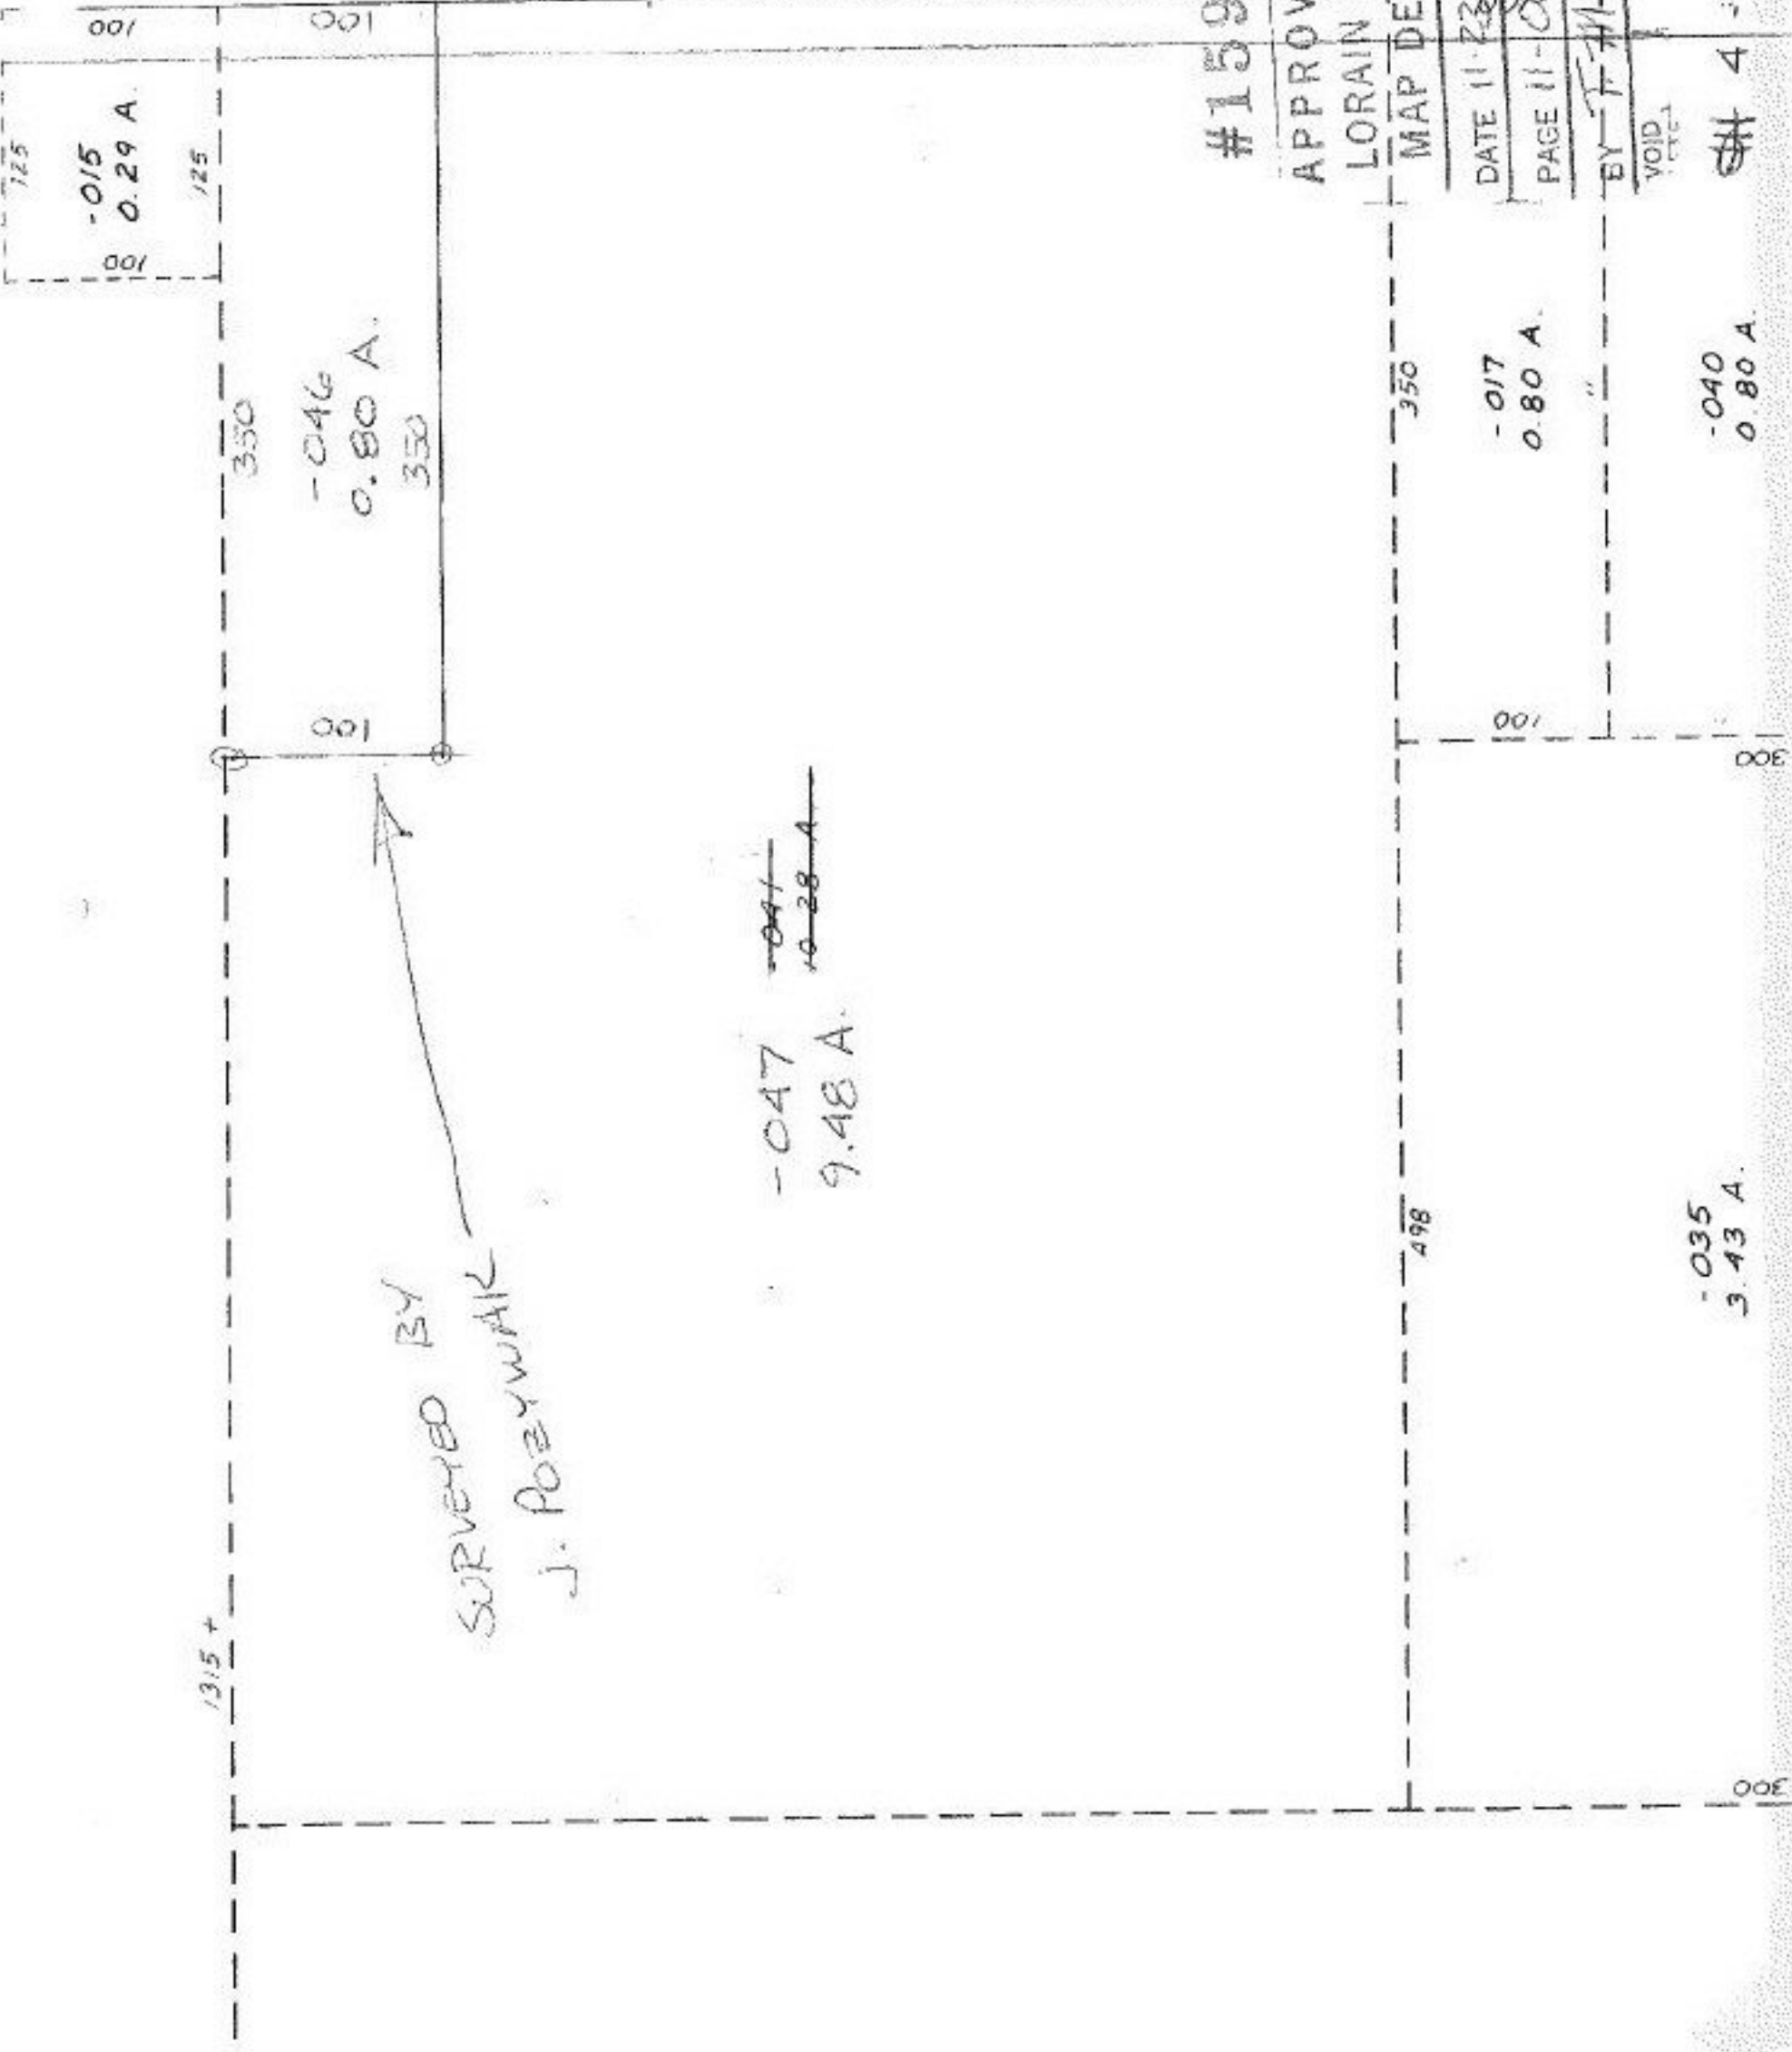

#15905

APPROVED
LORAIN CO.
MAP DEPT.

DATE 11-23-84

PAGE 11-00-024-B

BY F. McMain

VOID

4-11-86

-035
3.43 A.

-040
0.80 A.

-047 9.48 A.
~~-047 9.28 A.~~

SURVEYED BY
J. POZYWALIK

1315 +

498

350

350

100

100

-015
0.29 A.

125

125