

RICHLIEU

AVE. 50

AVE. 50

35 2 ¹⁰⁰	3-060 ¹⁰⁰	35 50	35 4 ¹⁰⁰	5-029 ¹⁰⁰	35
29-061	28		27-002	26-064	
31	32		33-003	34	70
58-57	57-059		56-004	55-059	
61-005	62		63-005	64	70
88-006	87-062	105	86	85-065	
91-007	92		93-062	94	70
118	117-035		116-008	115-036	70
121-058	122-055	70	123-009	124	52.6
148-010	147		146-010	145-063	73.40
151-011	152-063	70	153-011	154	
178-012	177		176-012	175-057	
181-013	182-040		183-013	184	
208-014	207-041		206	205	
211-015	212-042	112	213-061	214-060	113
238-016	237-043		236-016	235	
241-017	242-044	B	243-018	244-066	101
268-018	267-045		266-019	265	
271-019	272-046		273-020	274	
298-020	297-047		296-021	295-056	105
301-021	302-048		303-022	304	
328-022	327-049		326-023	325-049	
331-023	332-050		333-024	334-050	
358-024	357-051	H	356-025	355-051	
361-025	362-052		363-026	364-052	
388-026	387-056	C	386	385-053	
391-027	392	70	393-055	394-054	35
100	100		100	100	

DUPLICATE

CORRECTION
ONLY
 MAP DEPT.
 Records Correct

#15910

APPROVED
 LORAIN CO.
 MAP DEPT.


DATE 12-3-84

PAGE 3-00-040

BY *[Signature]*

VOID AFTER 15910

12-12-84
[Signature]

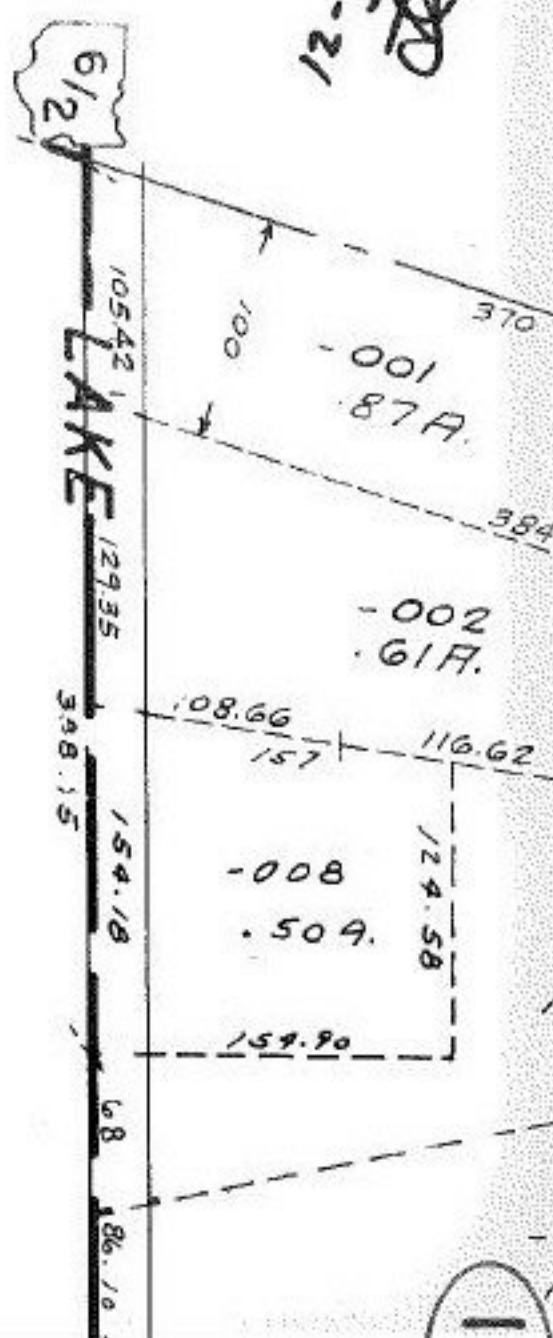

AVE. 50

35 2 ¹⁰⁰	3-026 ¹⁰⁰	35	35 4 ¹⁰⁰	5-027 ¹⁰⁰	35
-001					