


Survey By
Landon - Simon - Cahl & Assoc.

103

- 0.003186 889.85
- 0.004057
1.037138 Ac.

166,666

SEE 7-00-014-C

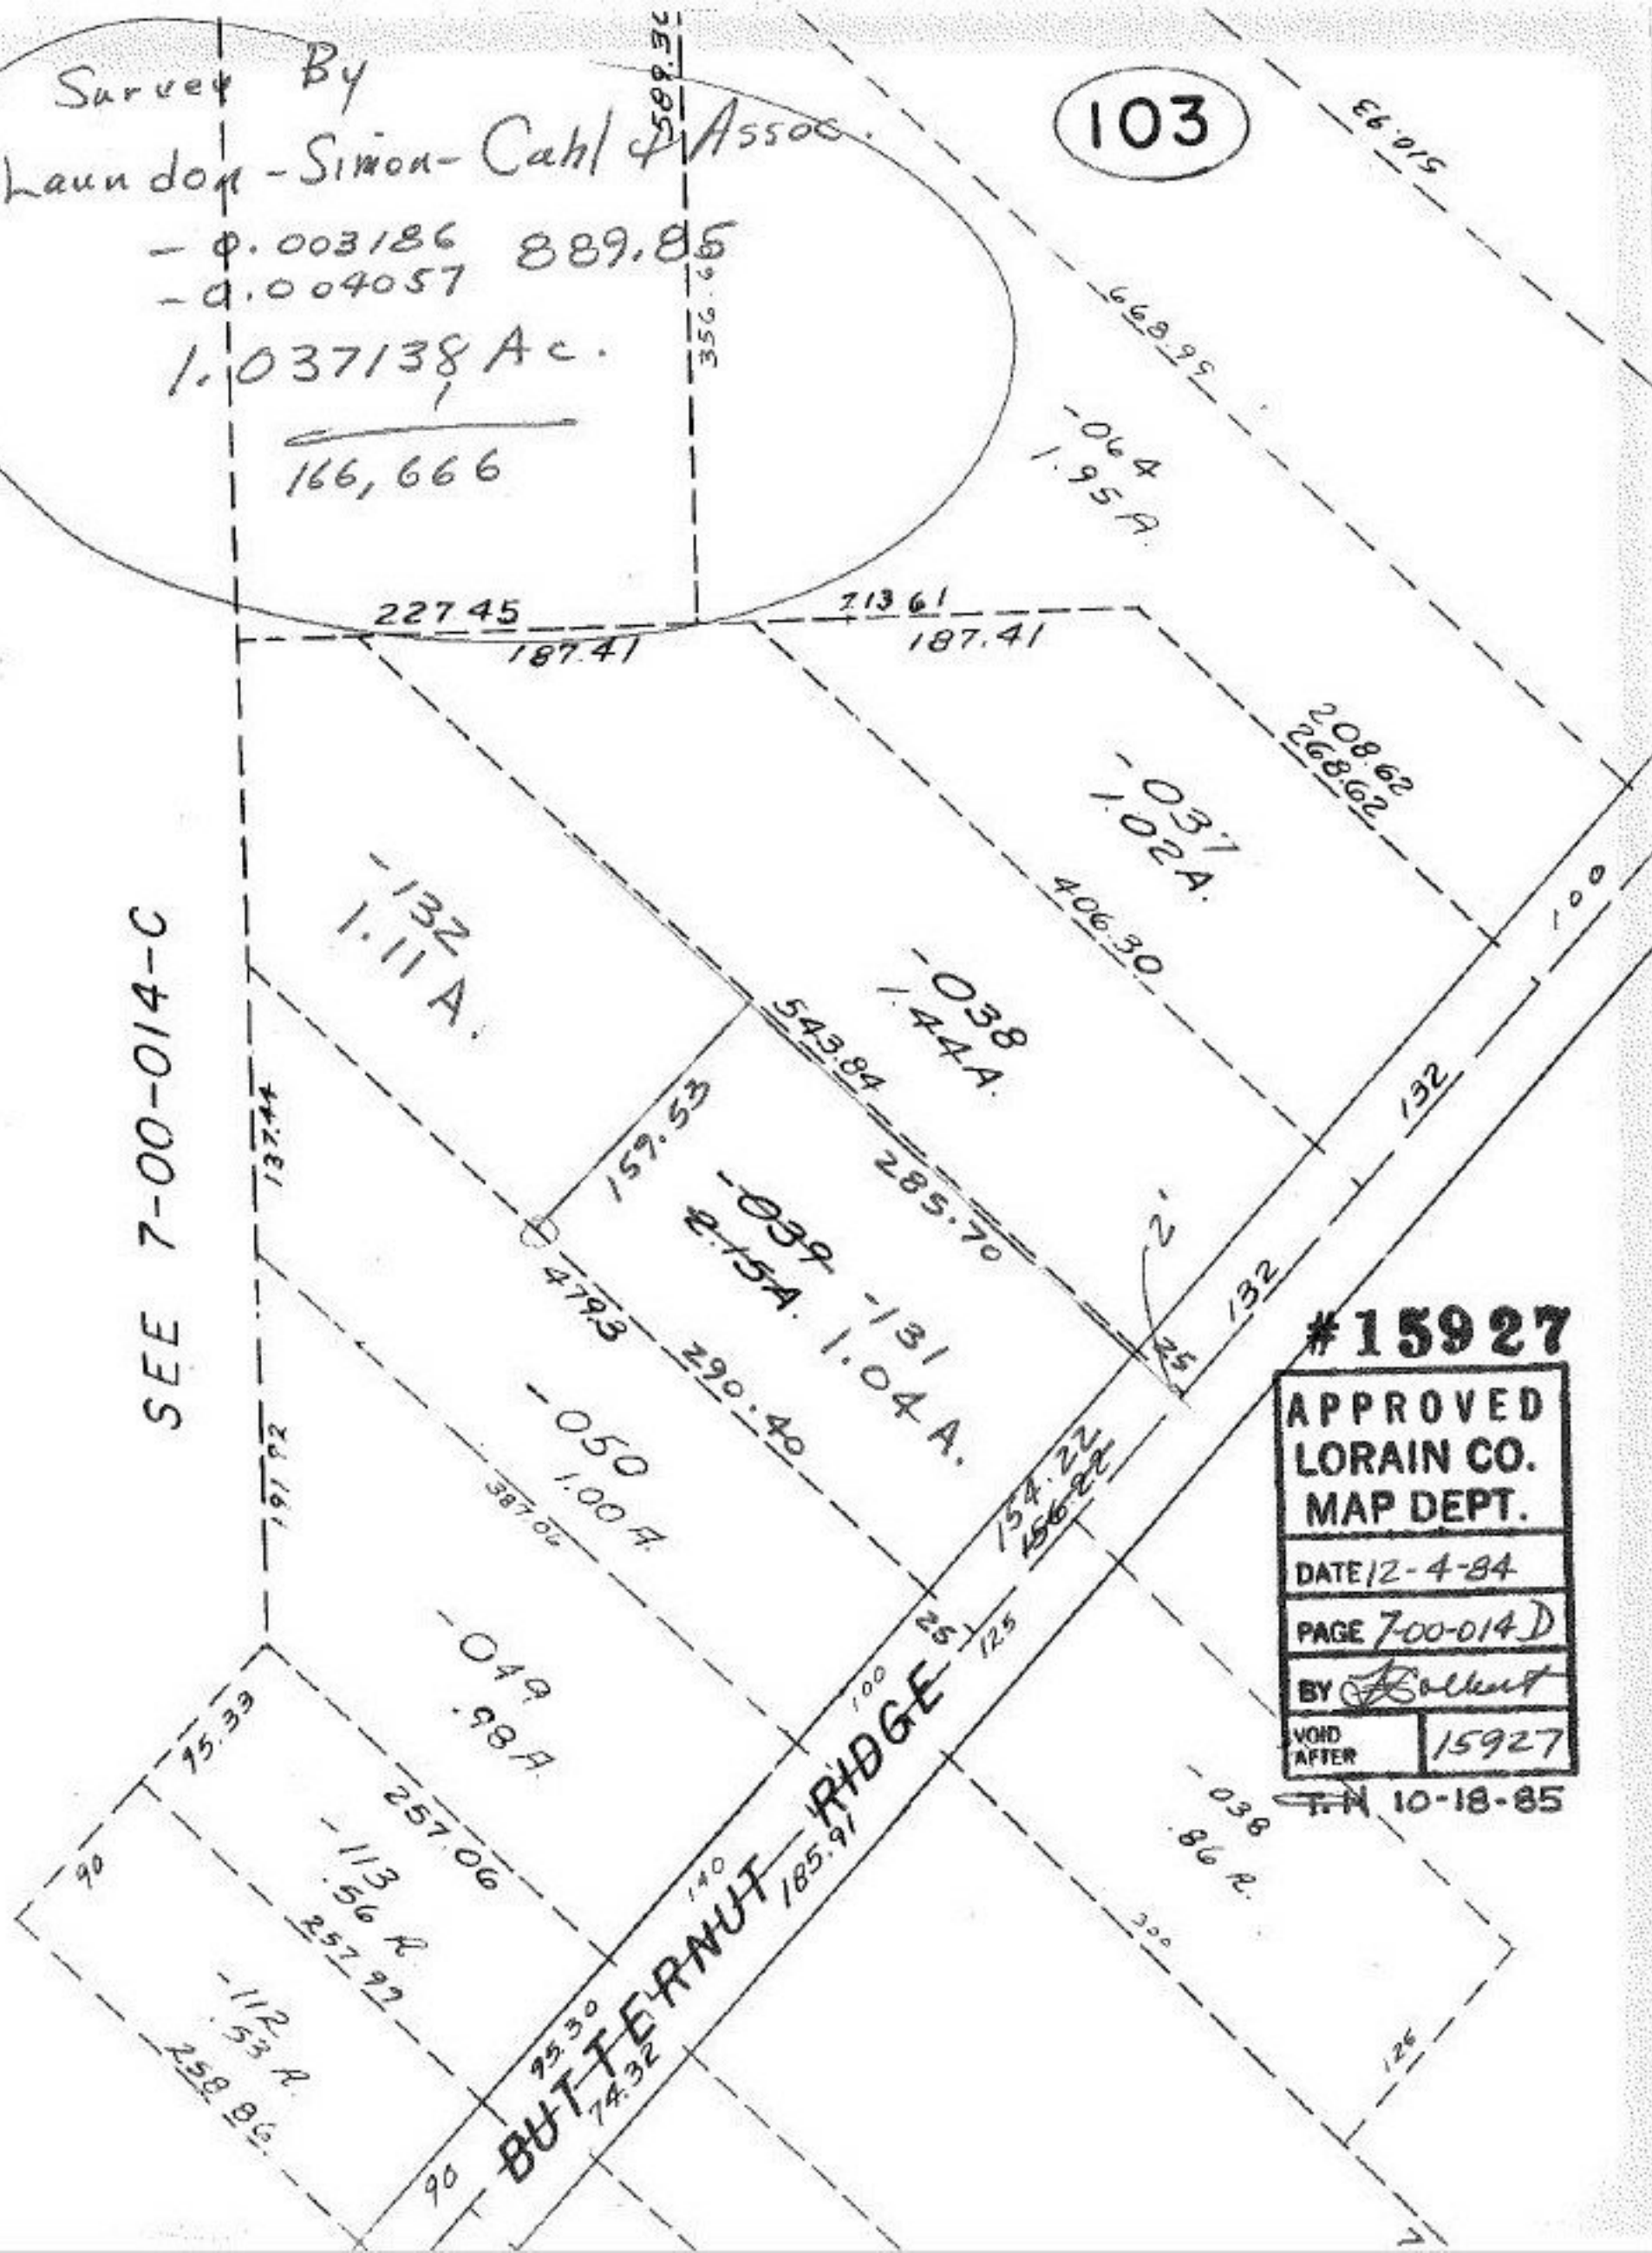

#15927
APPROVED
LORAIN CO.
MAP DEPT.
DATE 12-4-84
PAGE 7-00-014 D
BY *Bolkert*
VOID AFTER 15927
T.N. 10-18-85