



SEE 5-00-018-A

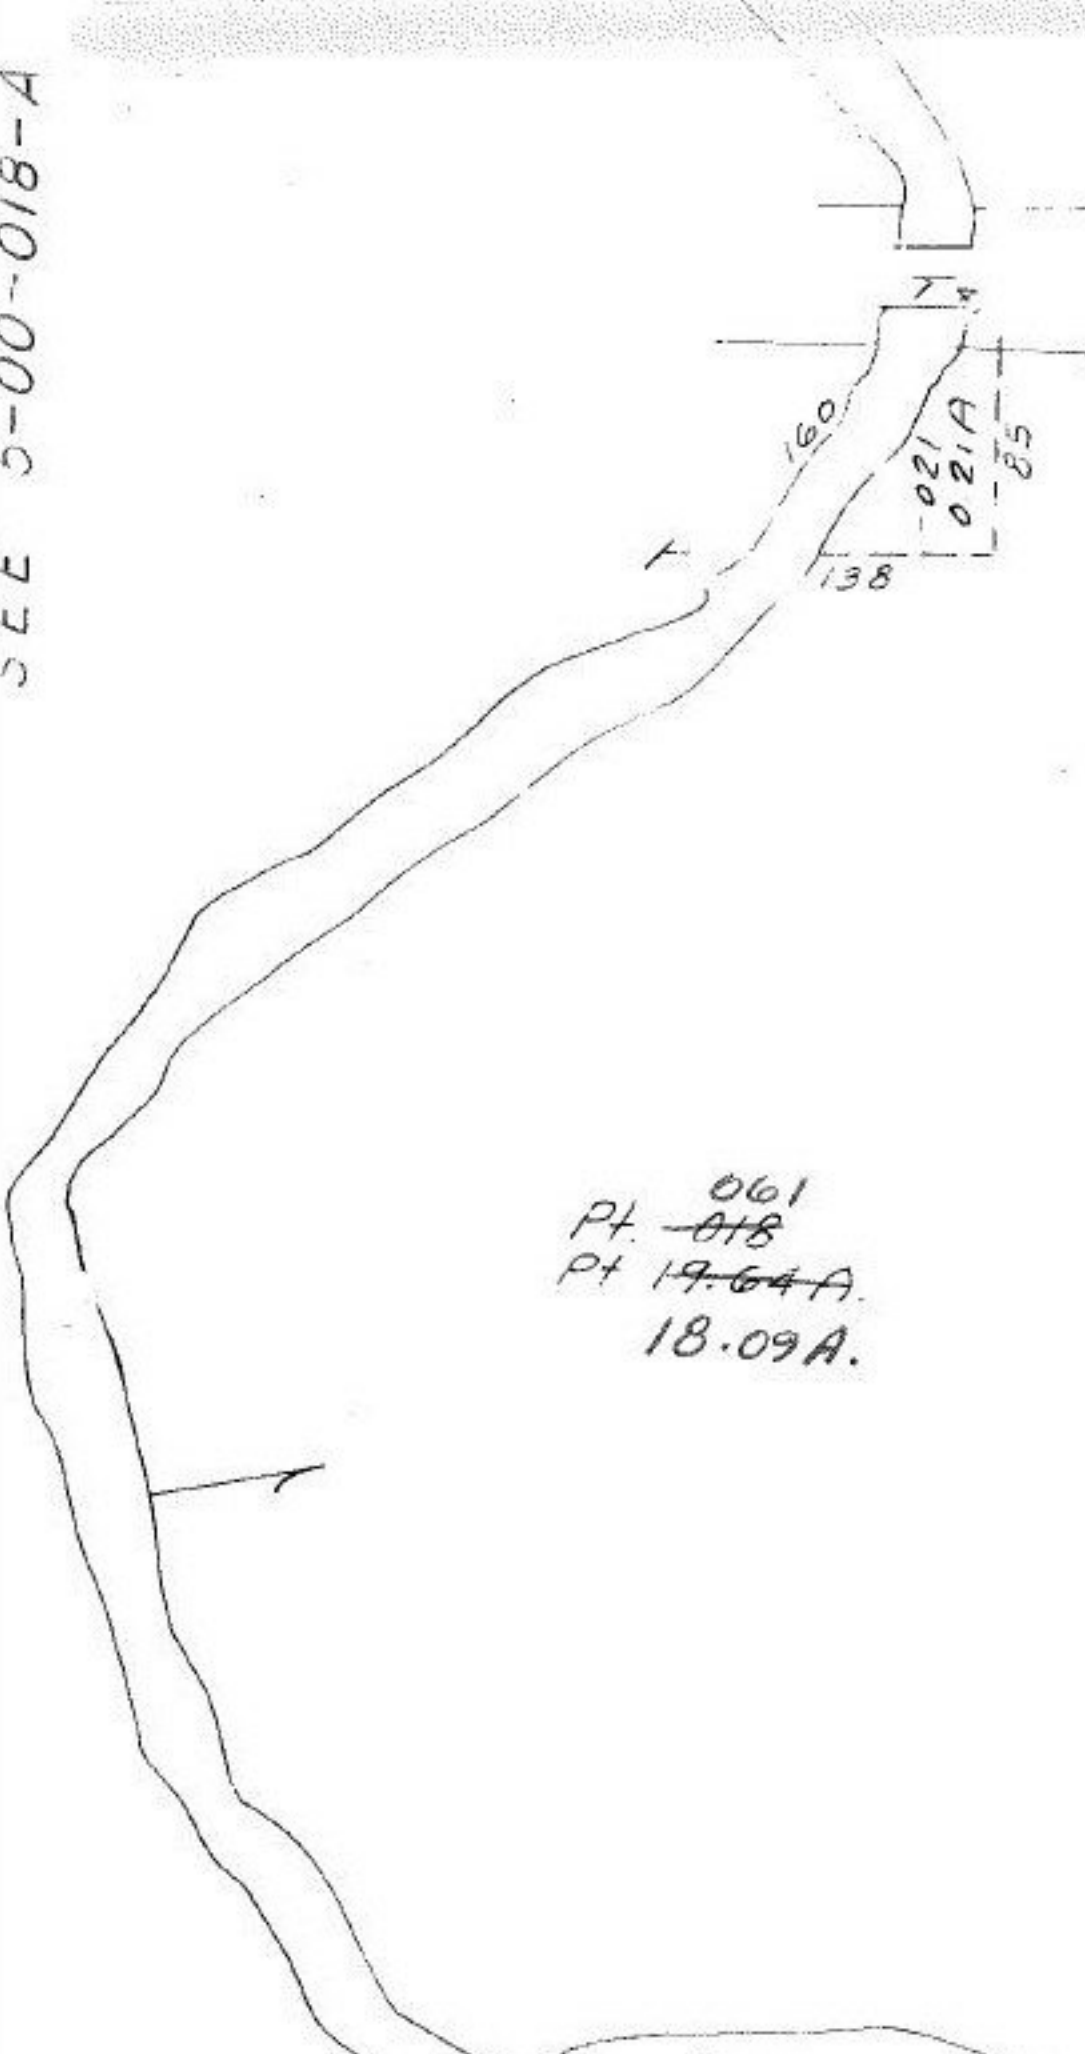

061
 Pt. 018
 Pt 19.64A.
 18.09A.

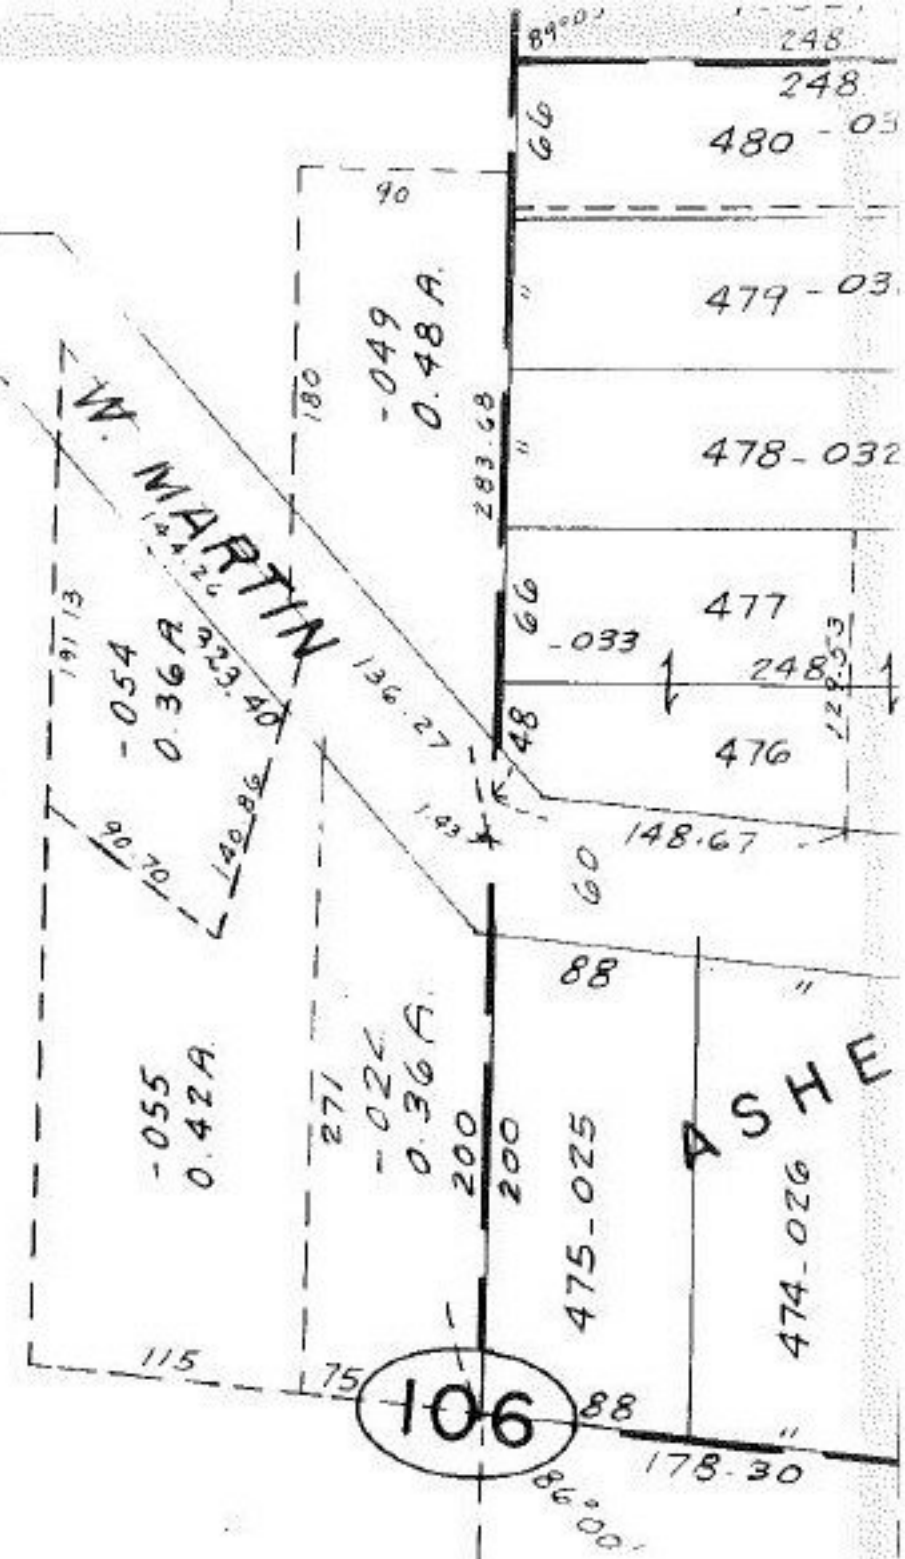

#15942

APPROVED
 LORAIN CO.
 MAP DEPT.
 DATE 12-17-84
 PAGE 5-00-018-B
 BY *[Signature]*
 VOID AFTER 15942

3-3-86

5-00-018-B

433
 9A

Sup
 Pl.