
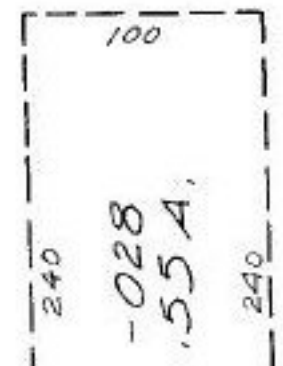


RD.

SEE SURVEY:
LAUNDON. SIMON. CAHL & ASSOC.
C.L. 1:76, 923

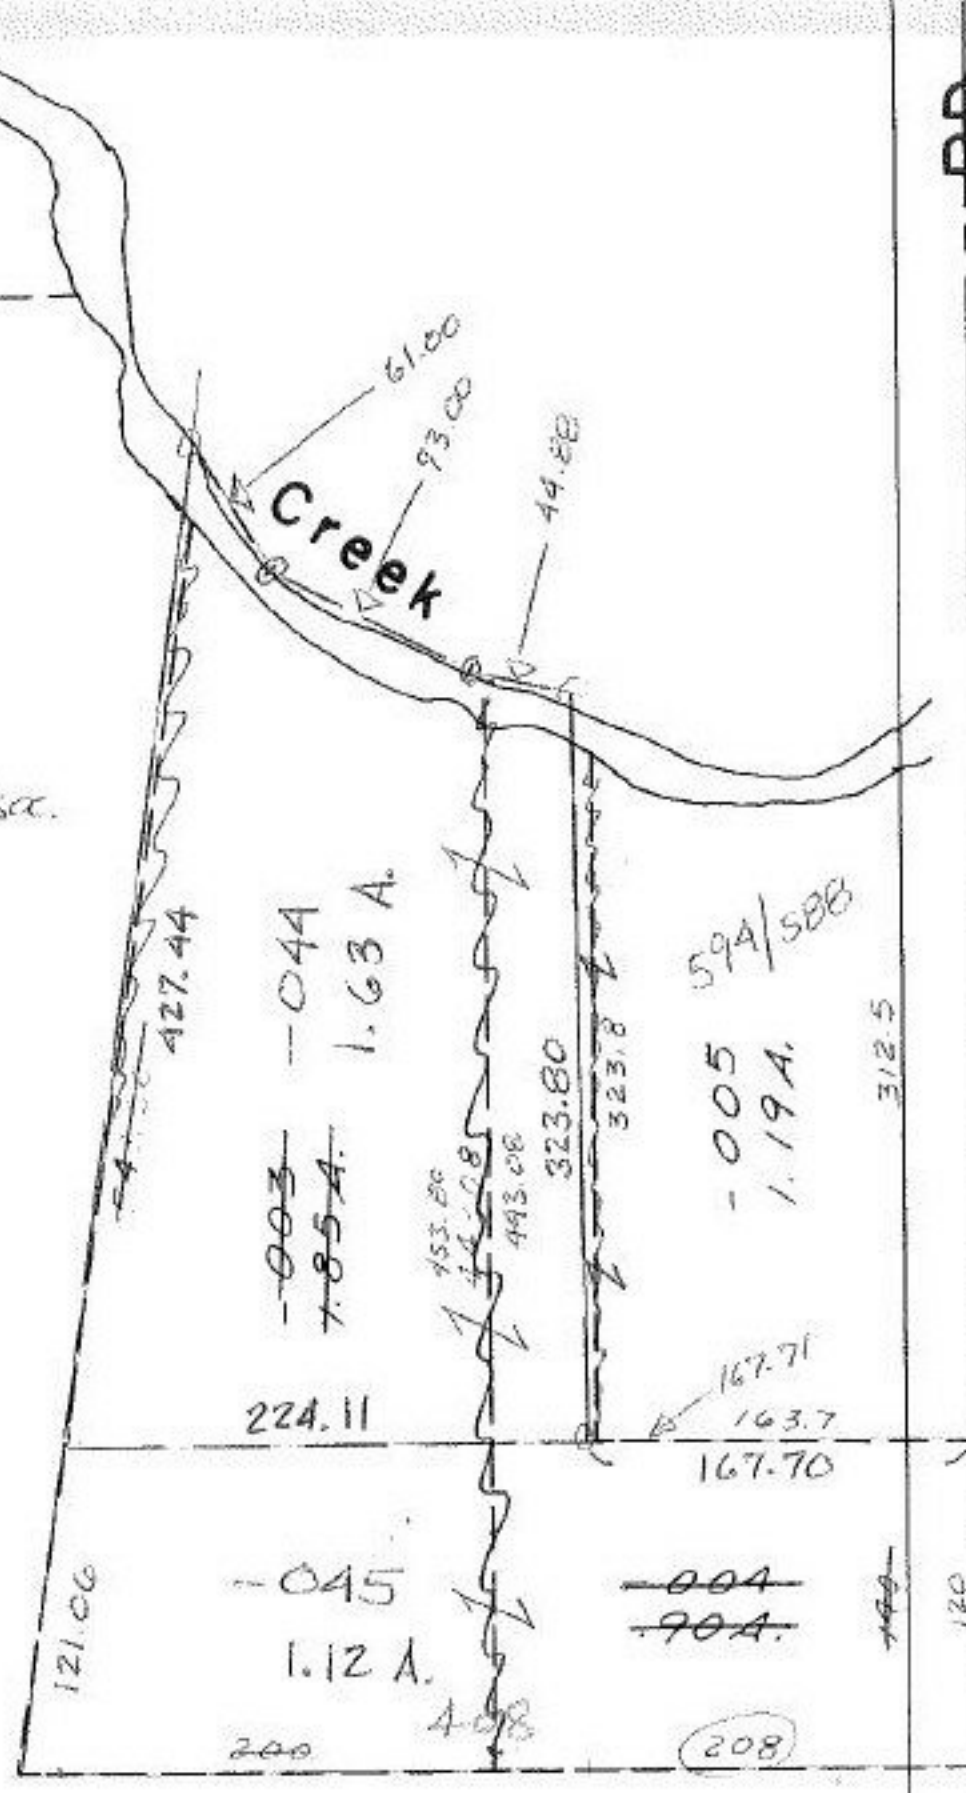

1029.05 S. 88° 30' 30" W.

LATE 100

RD.

SH 7-25-86

#15946
 APPROVED
 LORAIN CO.
 MAR. DEPT.
 DATE 12.18.84
 PAGE 15.00.020.B
 BY T. McNeil
 VOID