


SEE SURVEY
 KLEINODER, SCHMIDT
 & ASSOC.
 CL. 1:125,000

SEE 6-117

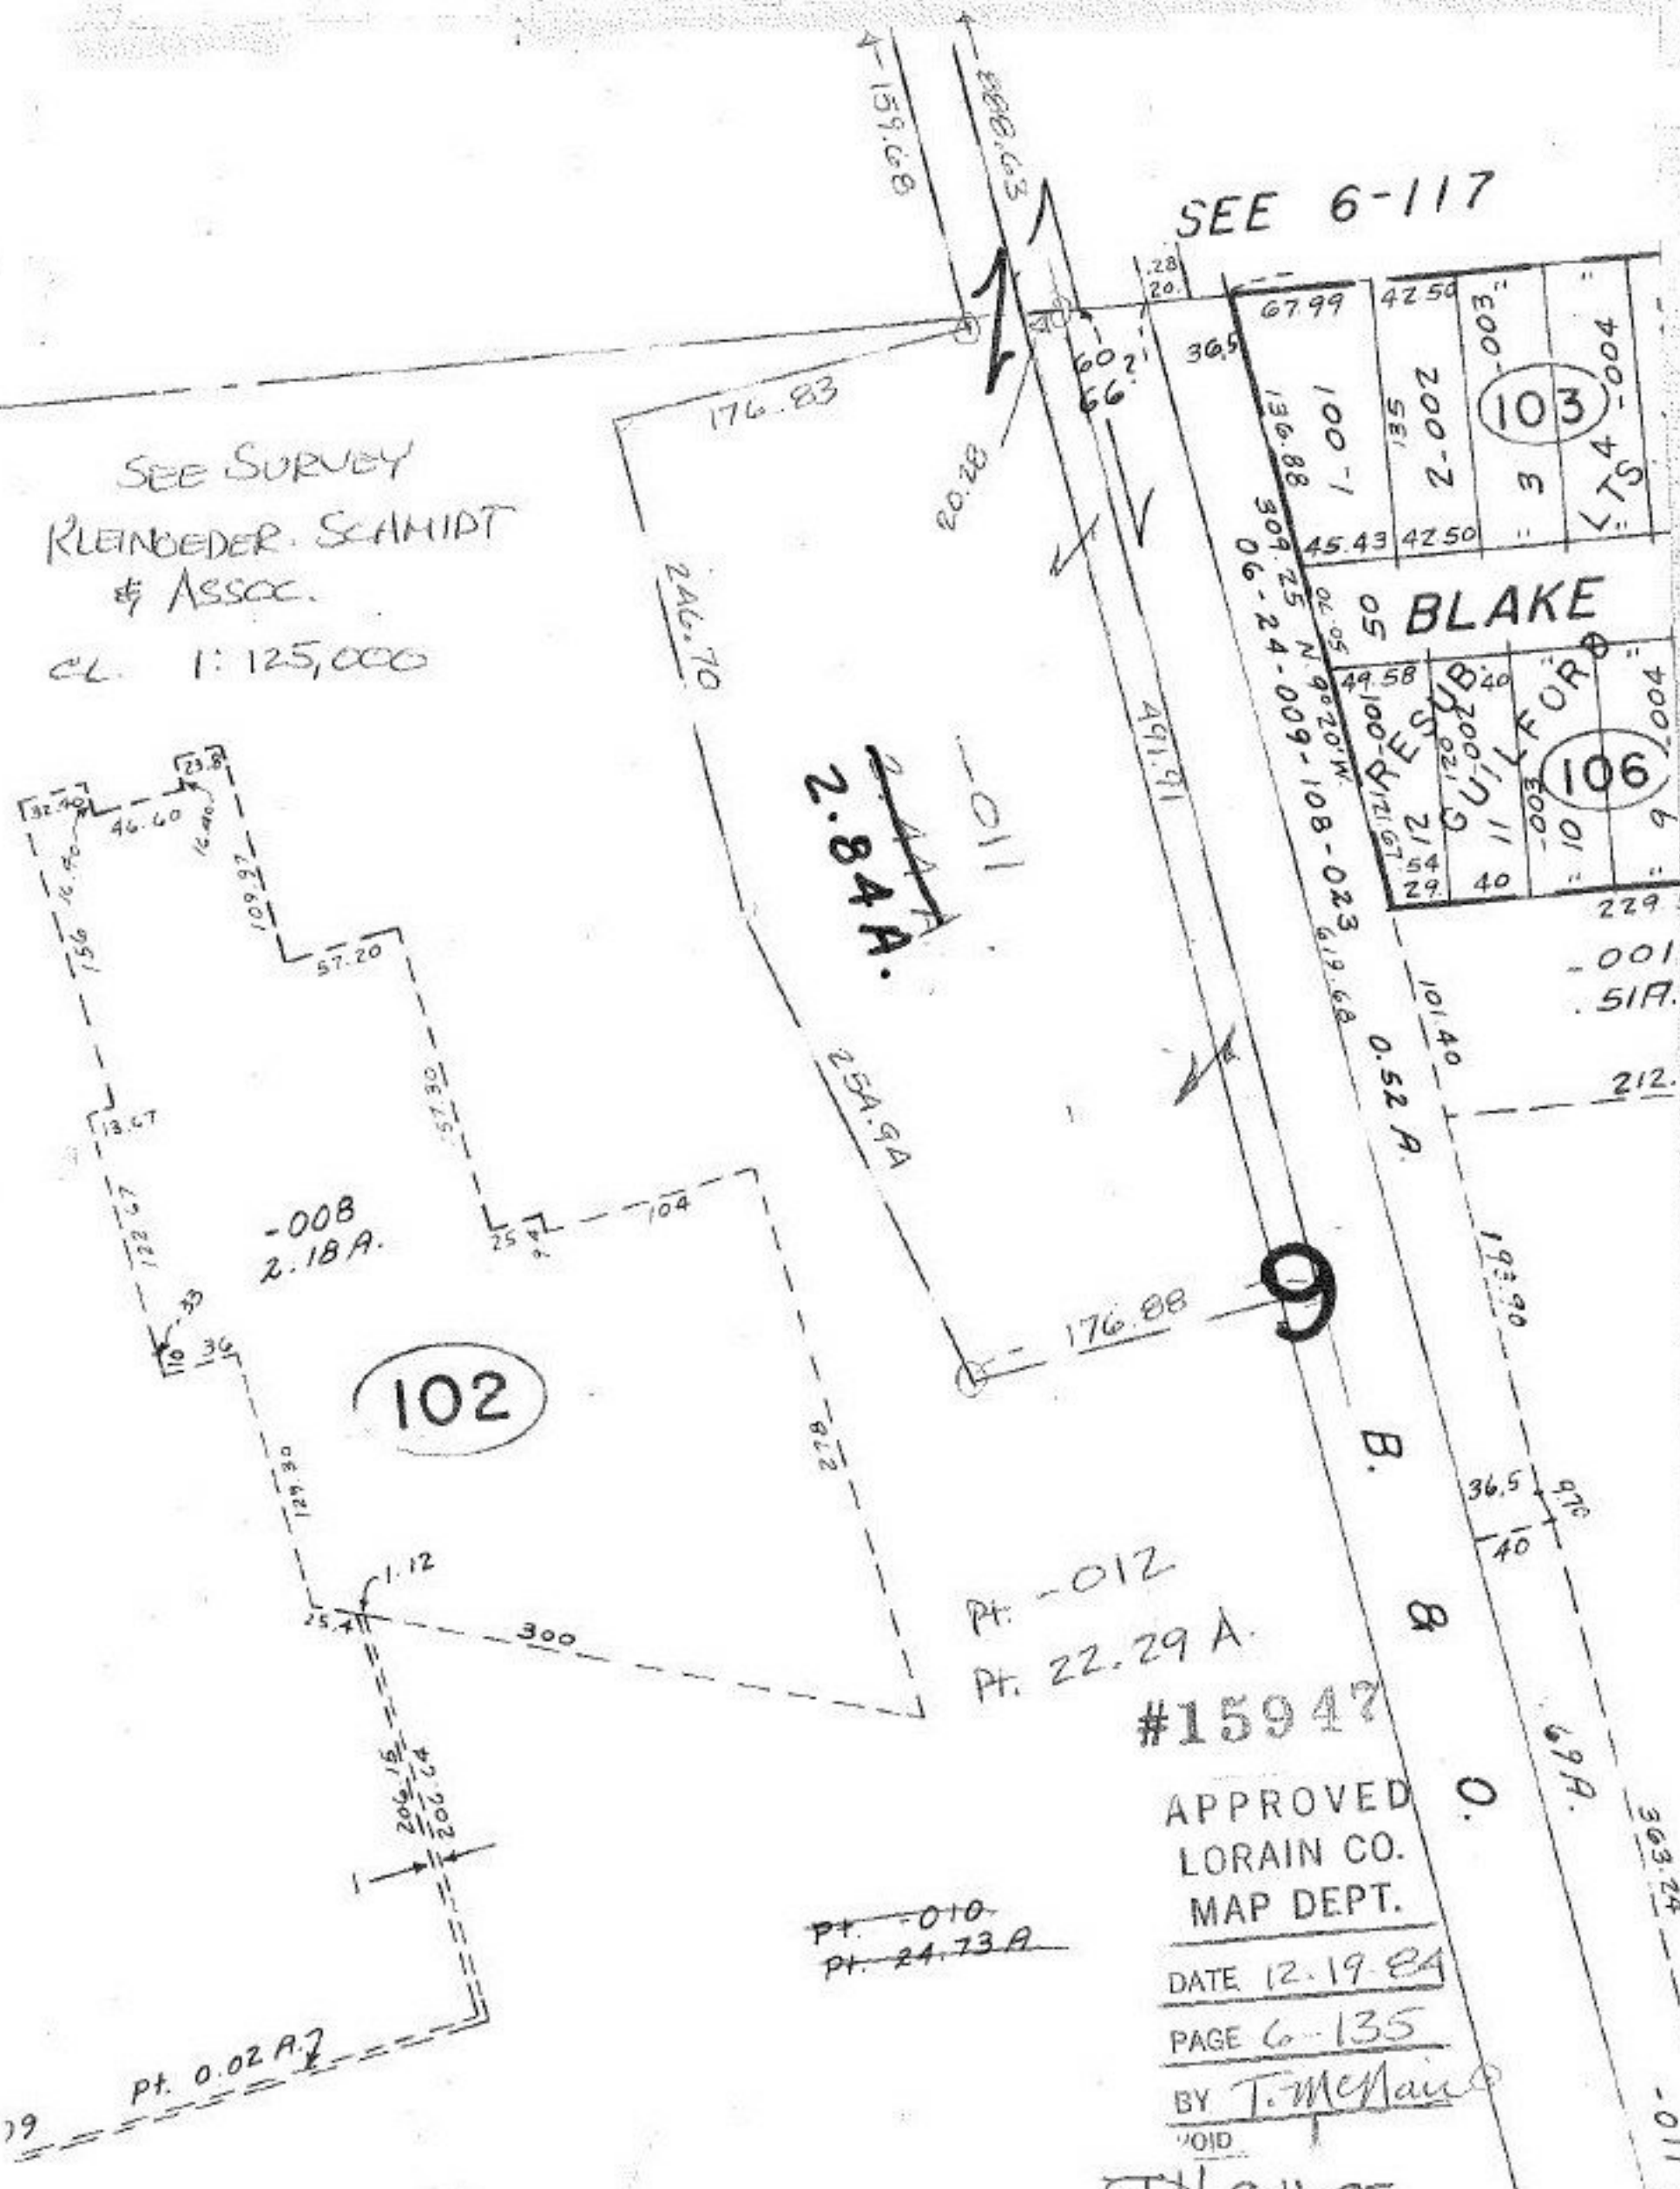

~~2.11A~~
 2.84A.

BLAKE

RESUB DIVISION

102

103

106

Pt. -012
 Pt. 22.29 A.

#15947

APPROVED
 LORAIN CO.
 MAP DEPT.

DATE 12.19.84

PAGE 6-135

BY T. McNamee

~~Pt. -010~~
~~Pt. 24.73 A~~

58-11-85

Pt. 0.02 A.7