


T.G. MORRISON

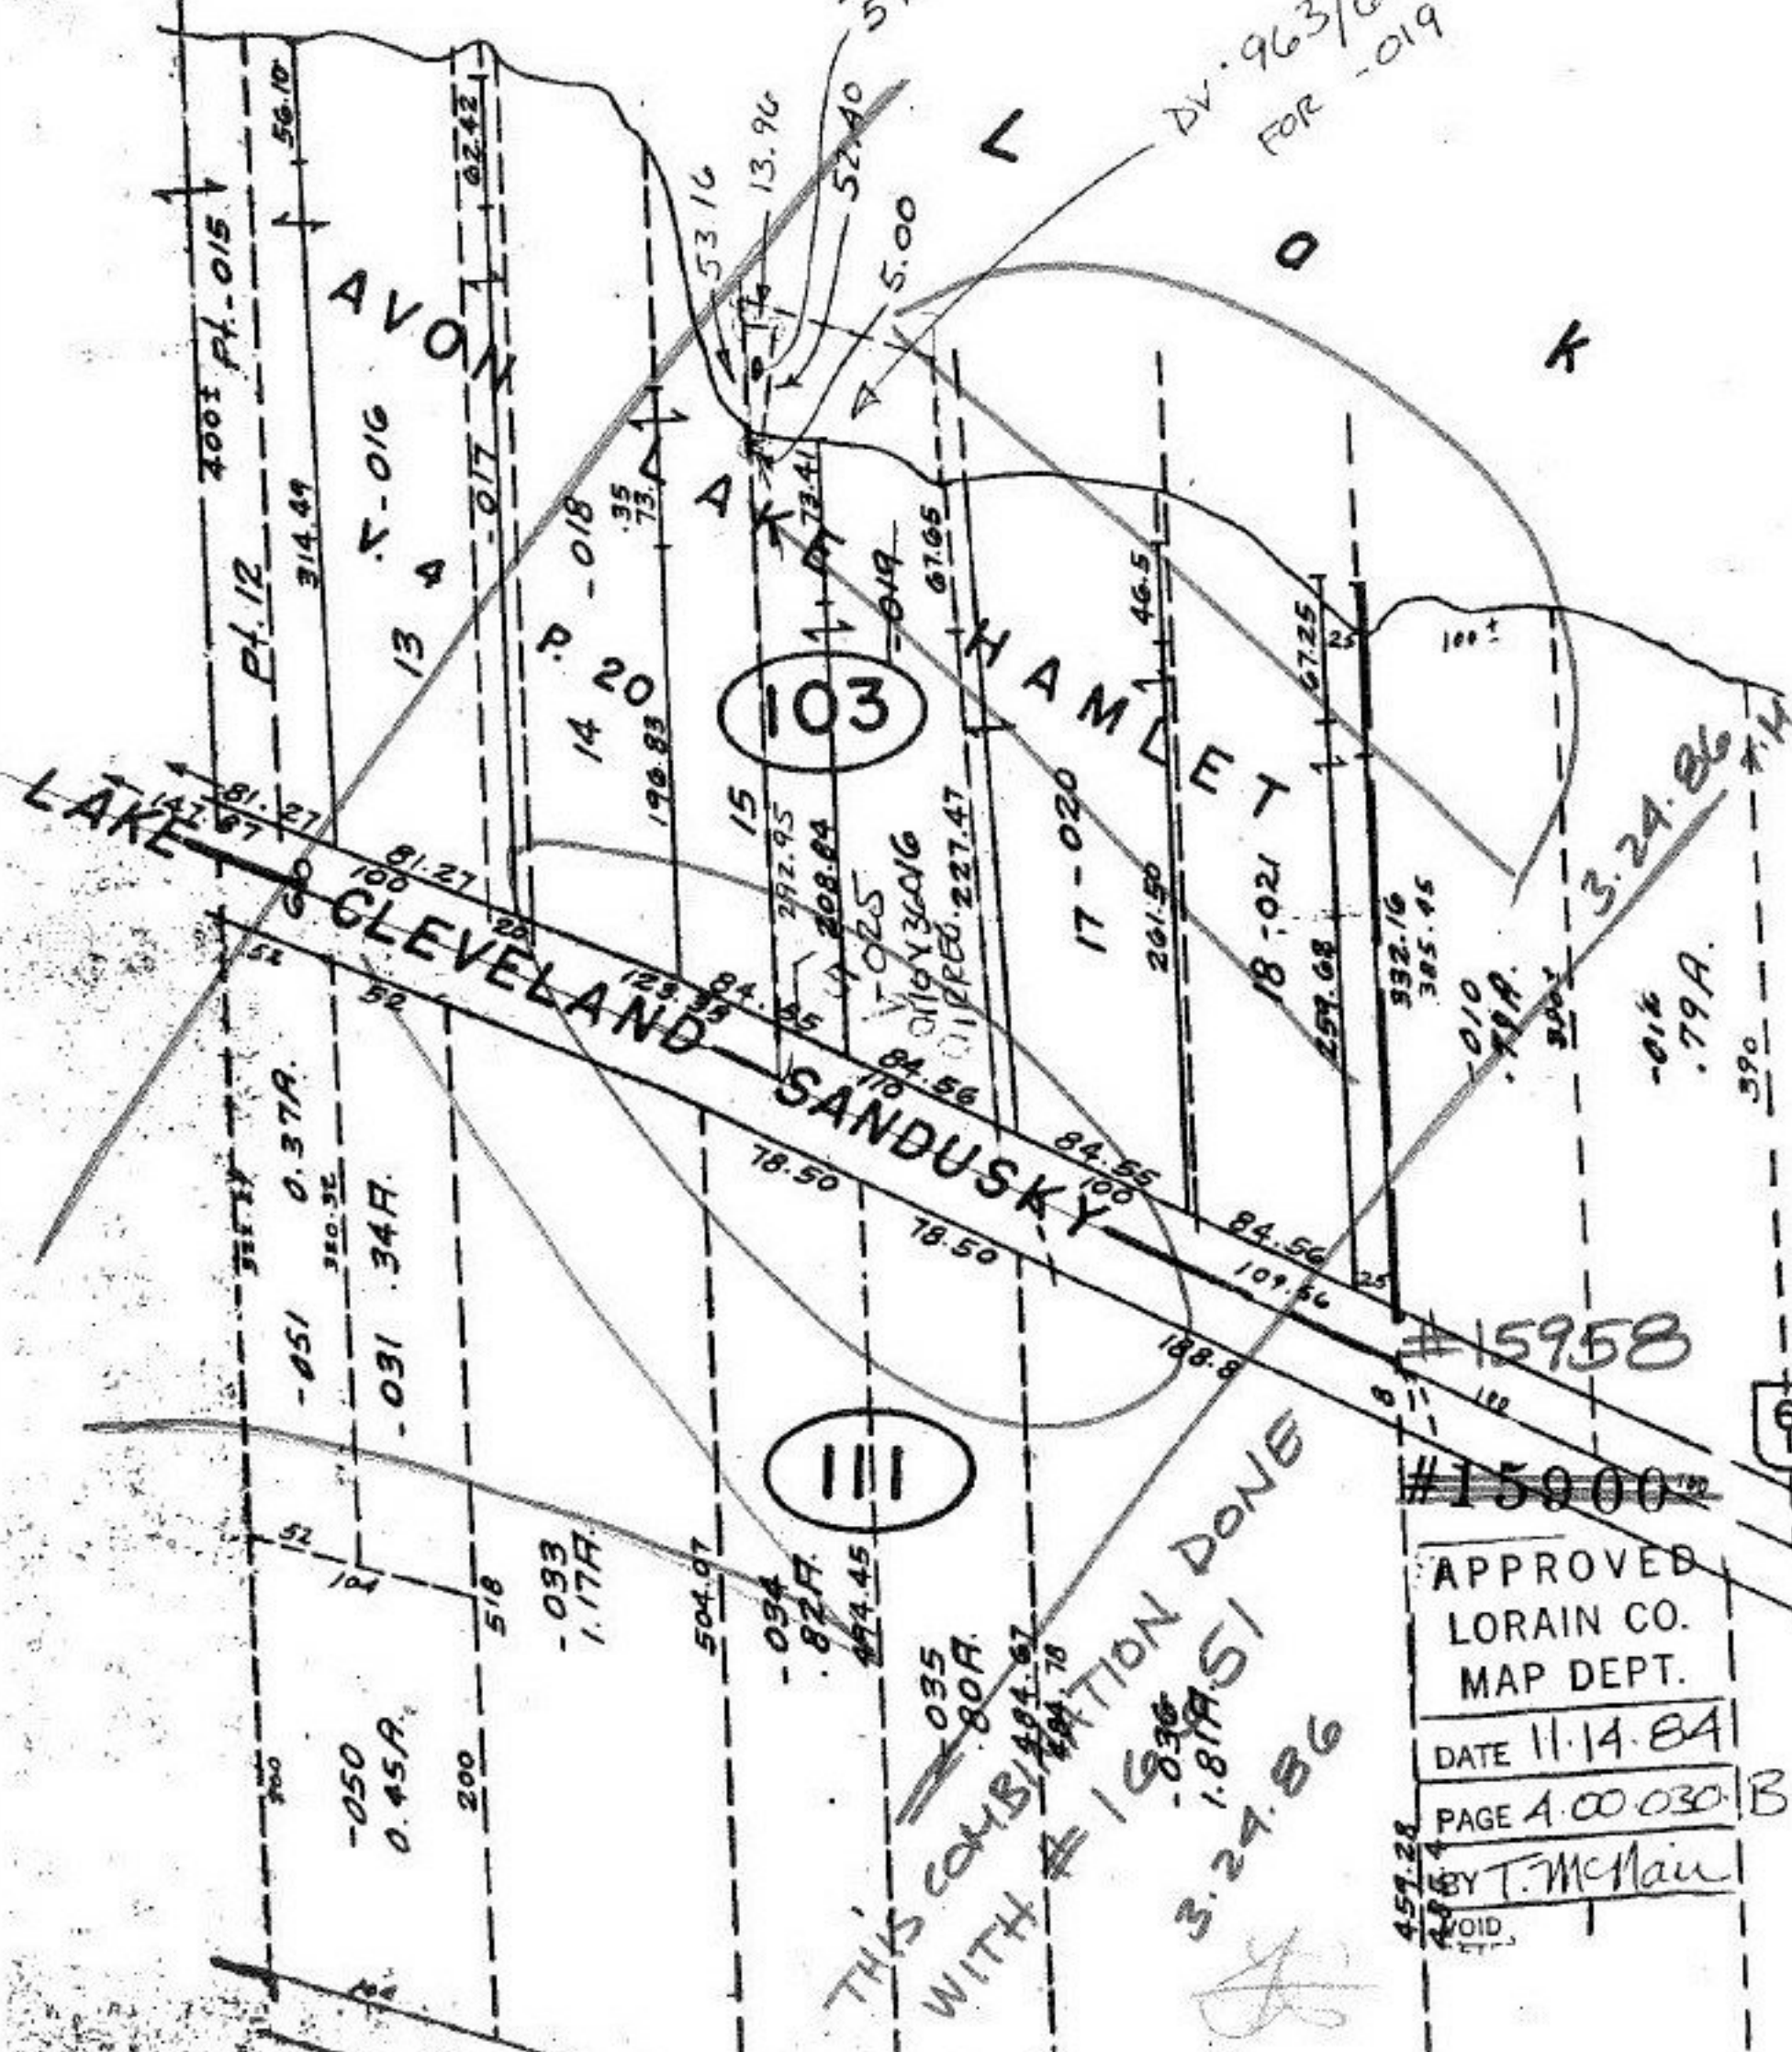

DV. 963/648
FOR -019

03

11

THIS COMBINATION DONE
WITH 15879.51
3.27.86

#15958
~~#15900~~

APPROVED
LORAIN CO.
MAP DEPT.
DATE 11.14.84
PAGE A.00.030 B
BY T. McMain
VOID