


12
140
182.40

SE

5-21-87
06-24-172-000
-008

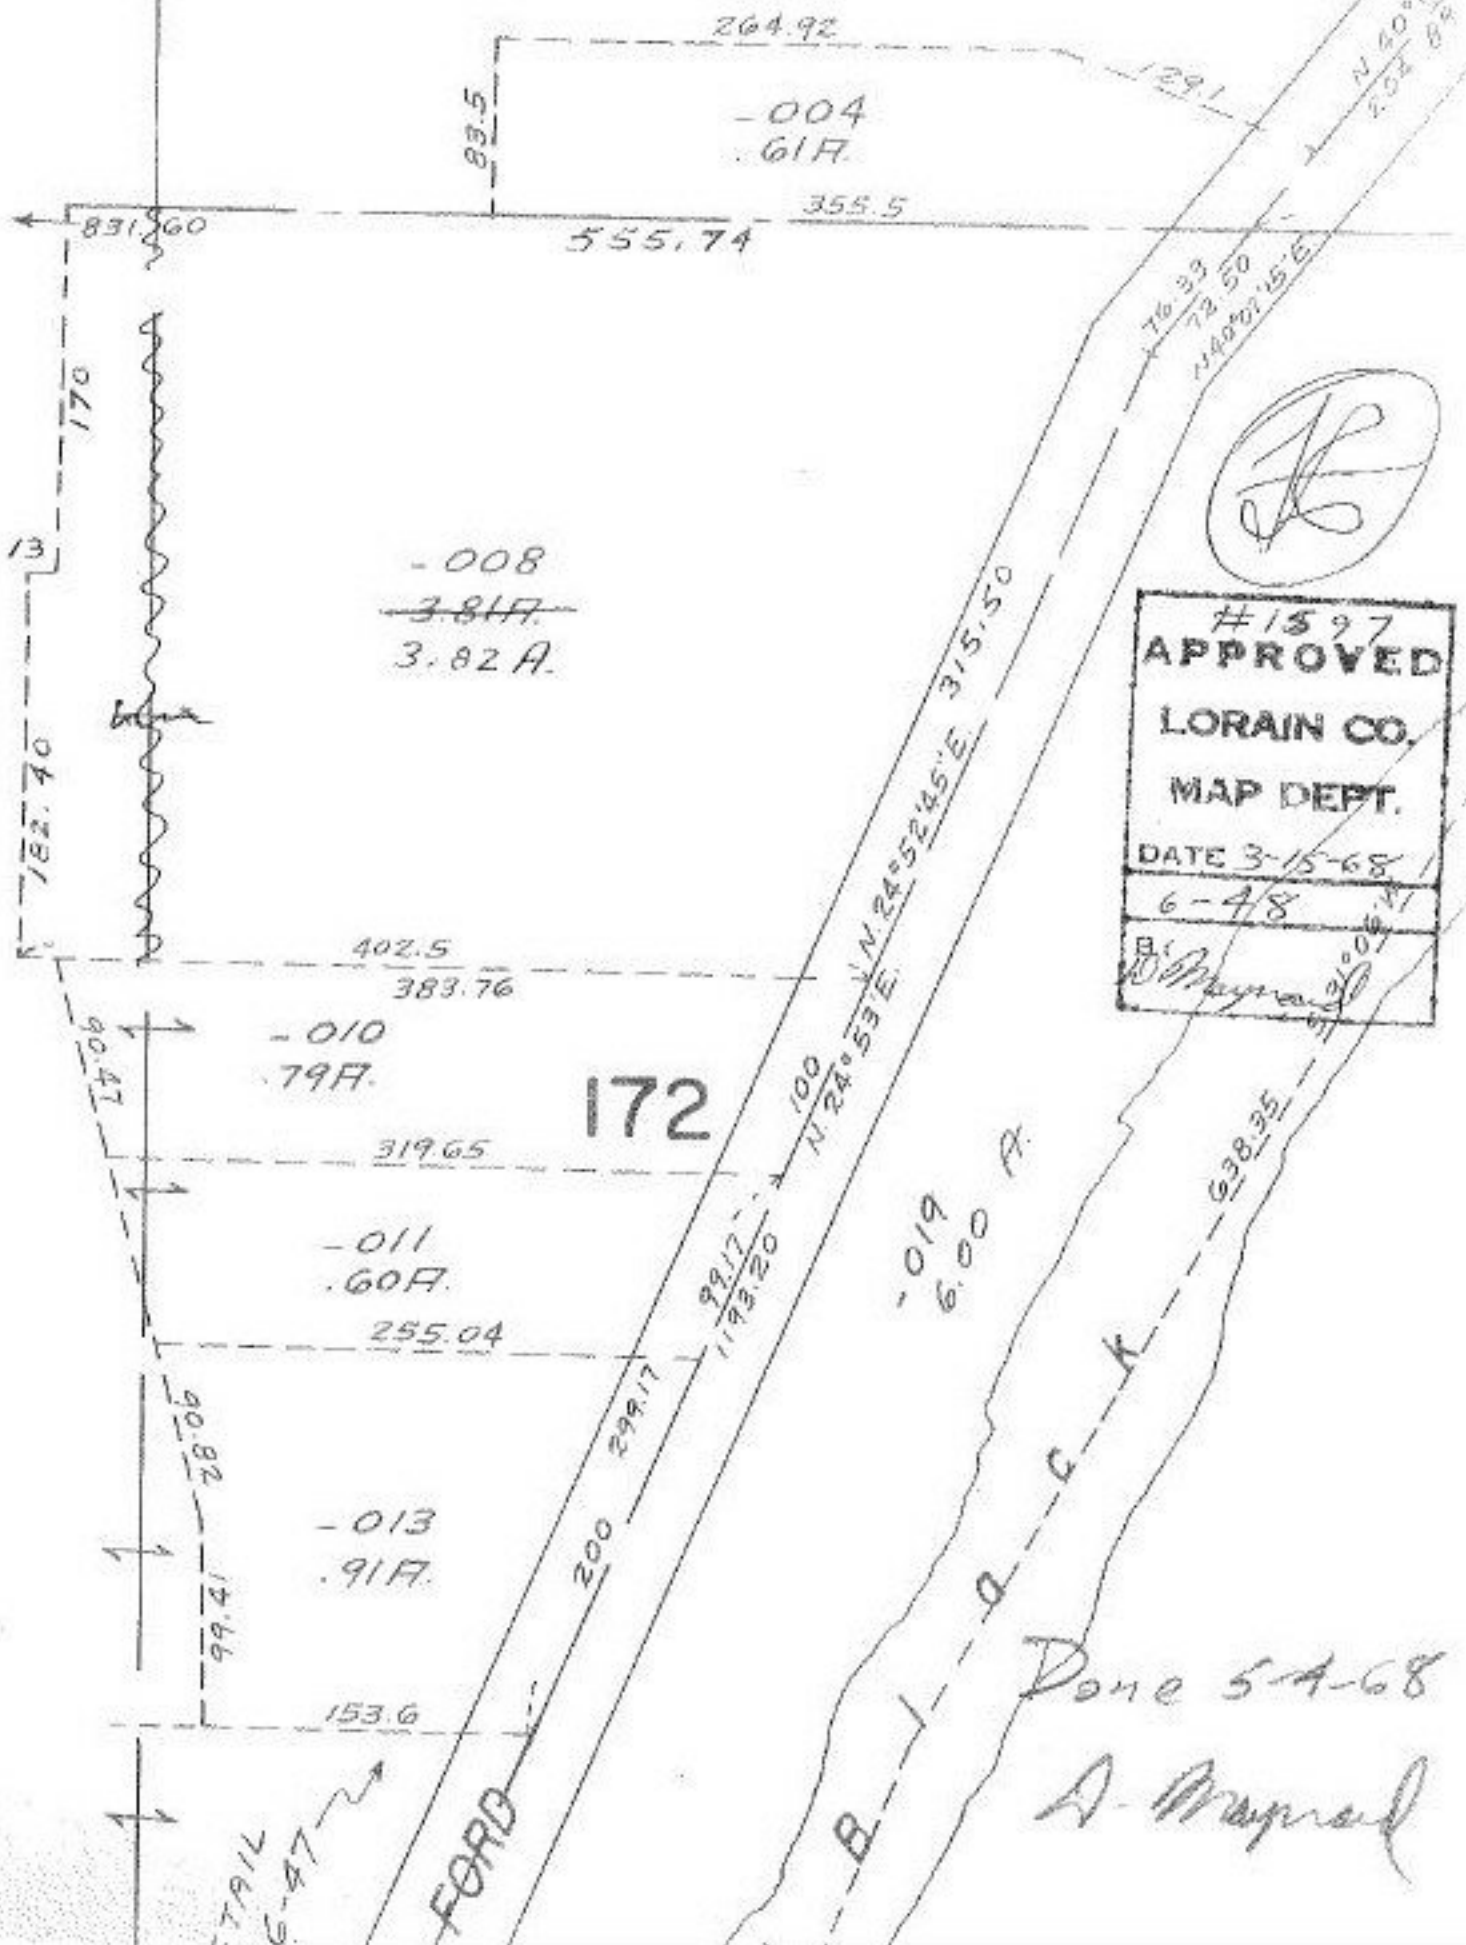

(Handwritten signature)

#1597
APPROVED
 LORAIN CO.
 MAP DEPT.
 DATE 3-15-68
 6-4/8
(Handwritten signature)

Done 5-4-68
A. Mapred