


99WD

-035

20x28.39x20 TRI

83

EE 4-00-017-F

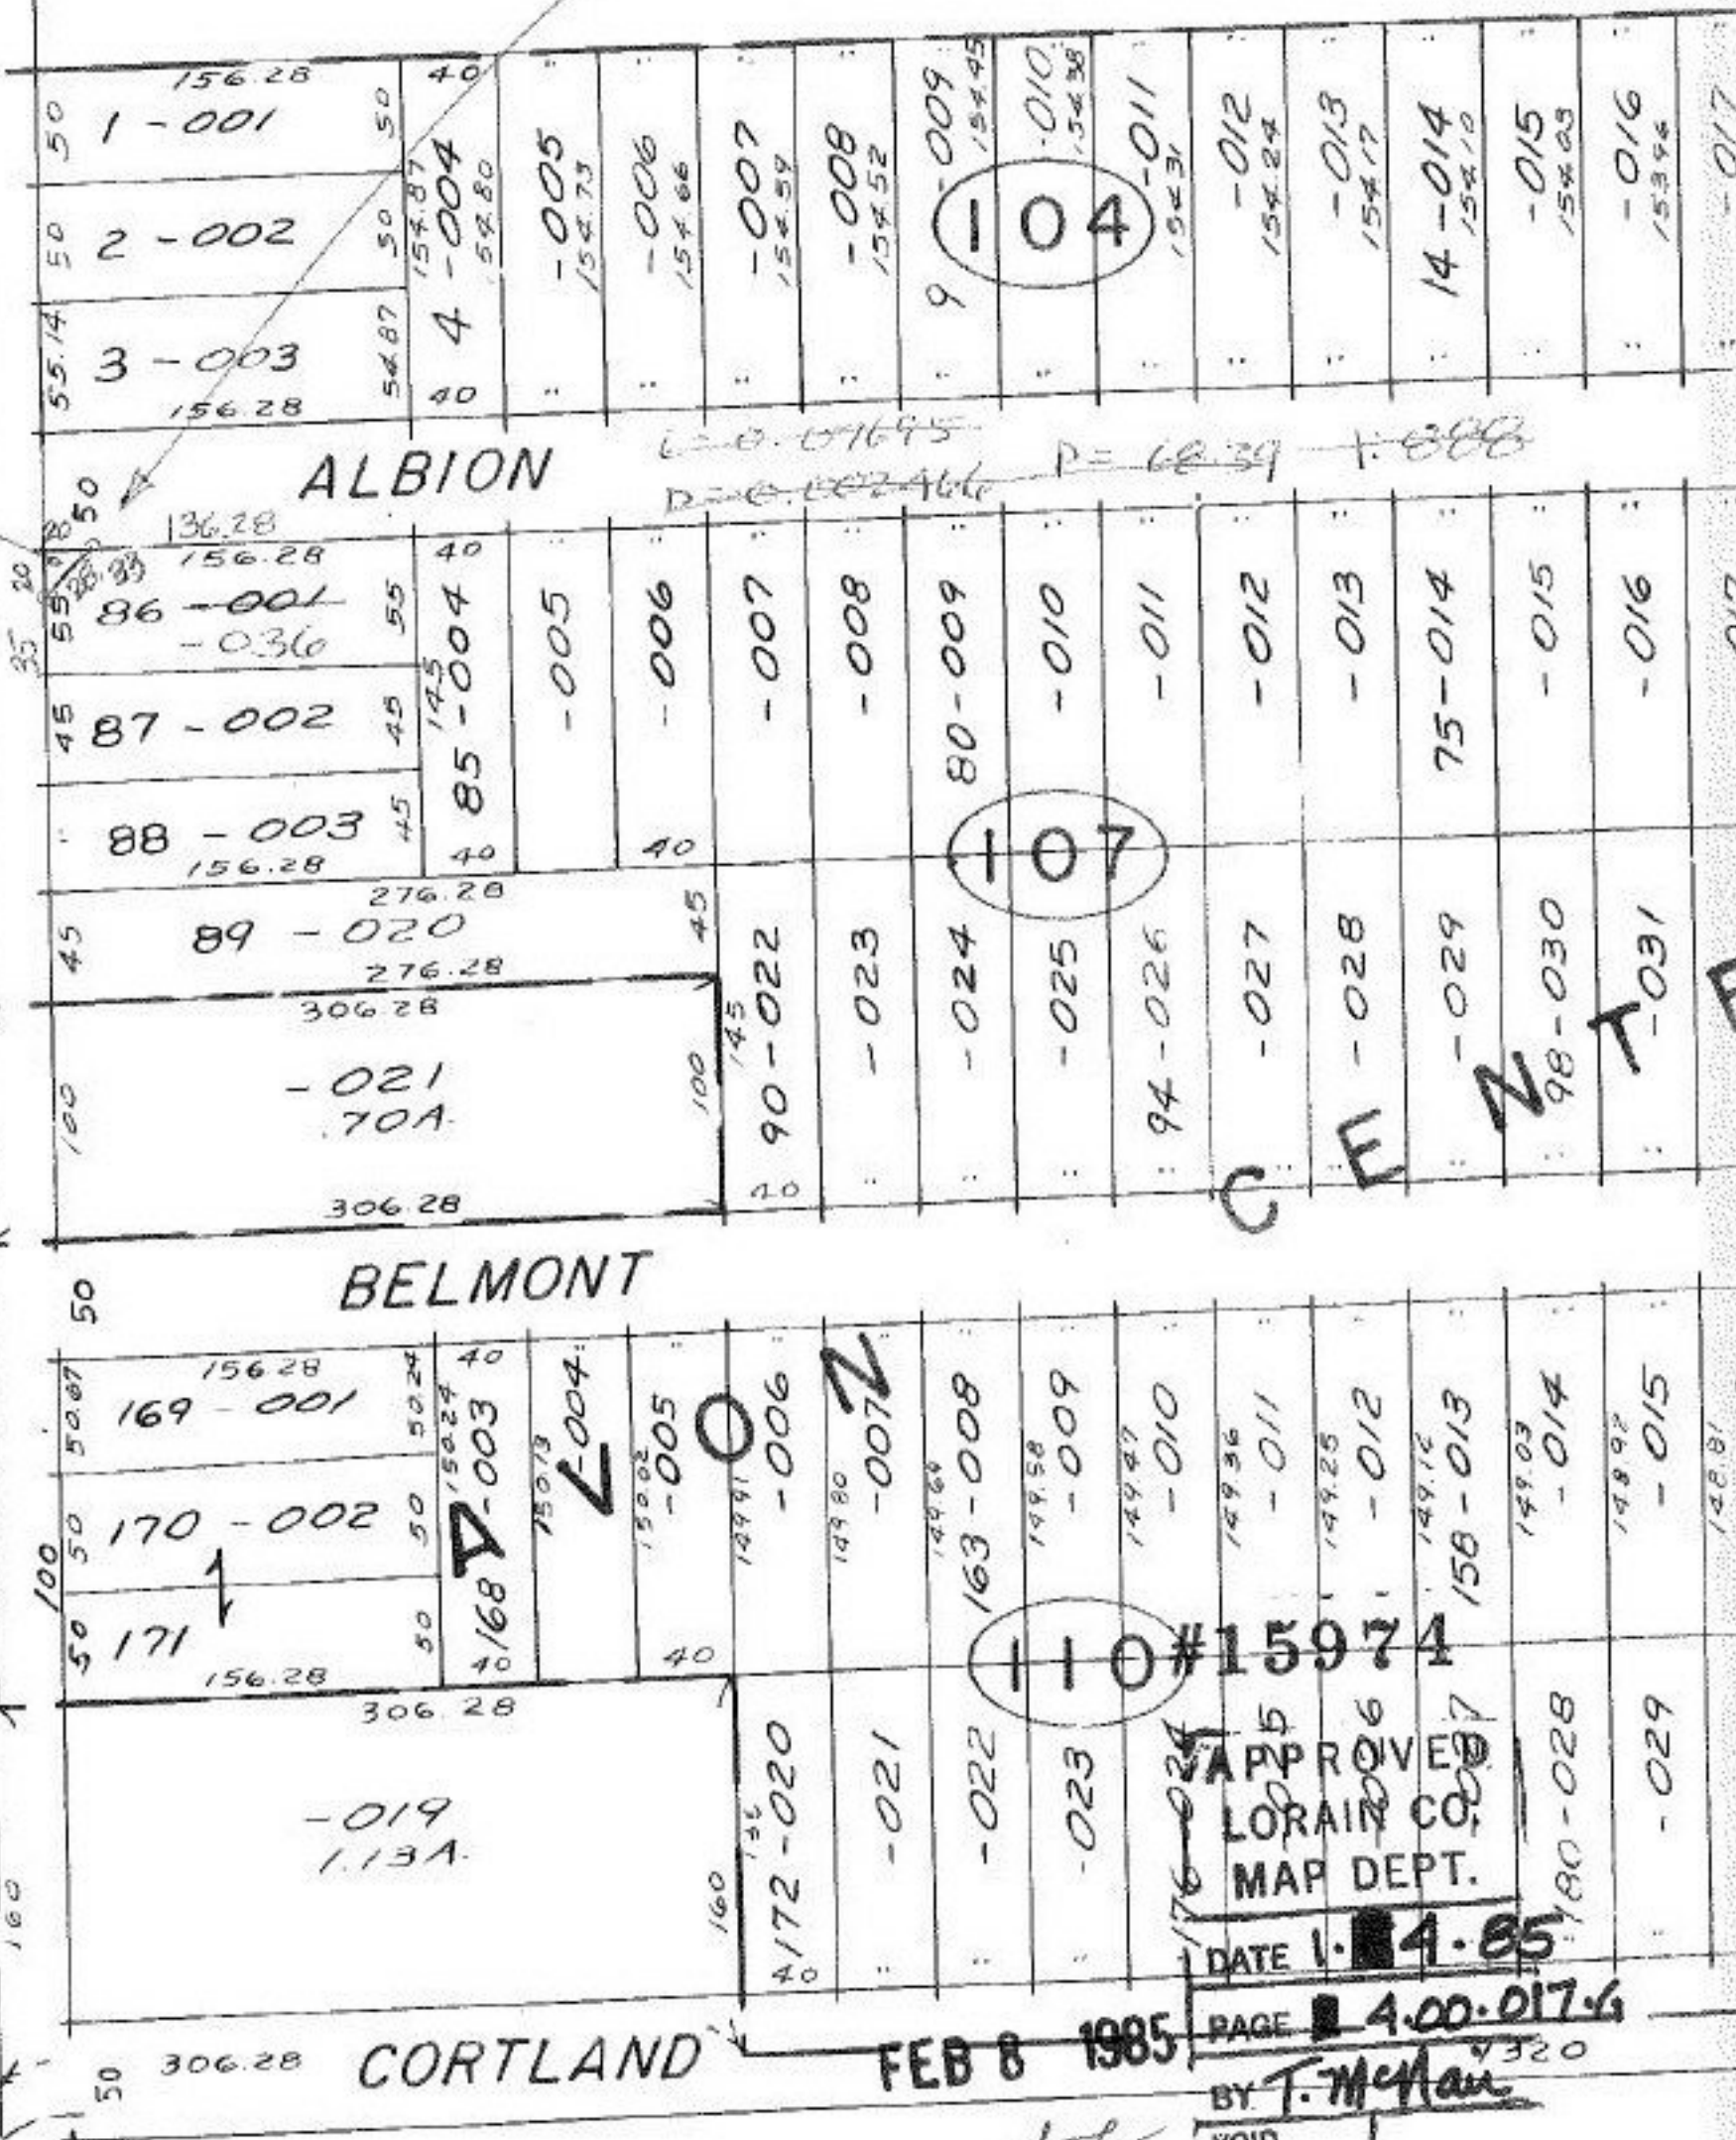

L=0.07695  
P=68.39  
D=0.00246

APPROVED  
LORAIN CO.  
MAP DEPT.

DATE 1-14-85  
PAGE 4-00-017-6

BY T. McMan

VOID

*[Handwritten Signature]*

J. H. 2/8/85