


SEE 4-00-018-J

-057  
0.15 A  
4-27-84  
FROM CORRECTION

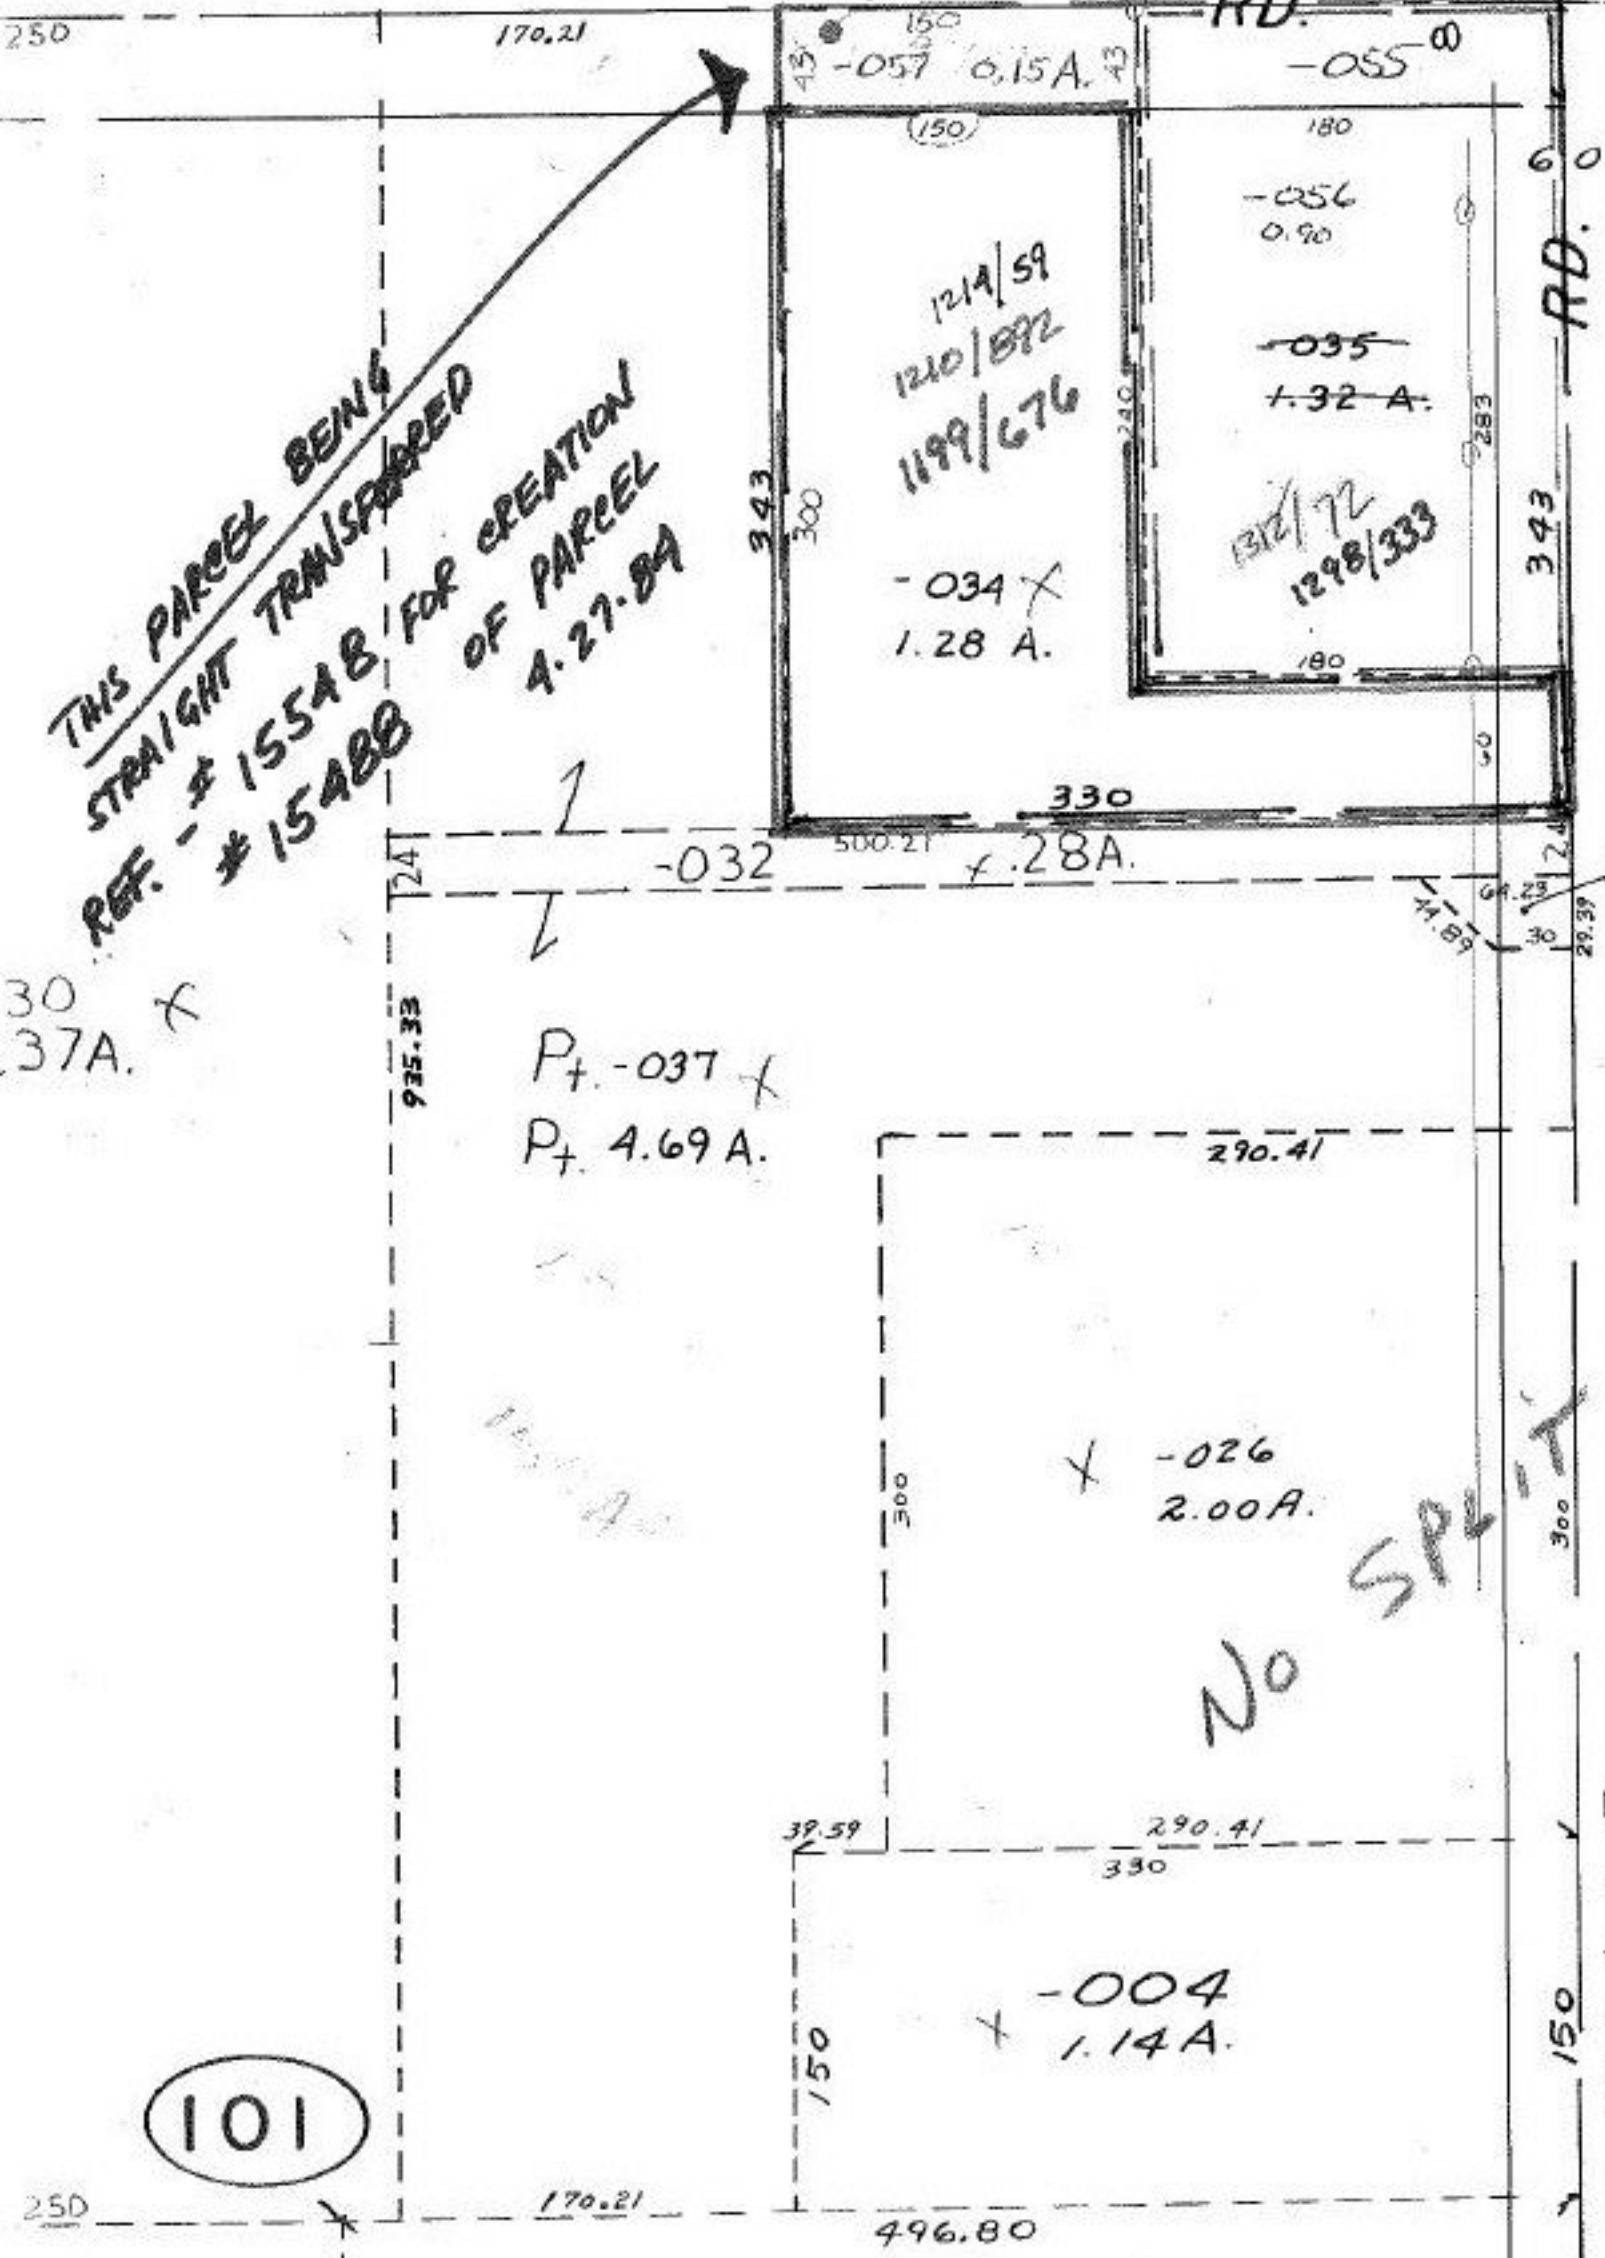

THIS PARCEL BEING  
 STRAIGHT TRANSFERRED  
 REF. # 1554B FOR CREATION  
 OF PARCEL  
 # 1548B 4-27-84

30  
 37A. X

P+ -037 X  
 P+ 4.69 A.

X -026  
 2.00 A.

No SP

X -004  
 1.14 A.

-036 X  
 0.03 A.

2-1-85

#15978  
 APPROVED  
 LORAIN CO.  
 MAP DEPT.

DATE 1-7-85  
 PAGE 4-00-017-B  
 BY T. McVain  
 VOID

101

SEE # 1554B