

6-88

105


LONGFELLOW ST.

21

SEE 15990

ST.

RD. 6

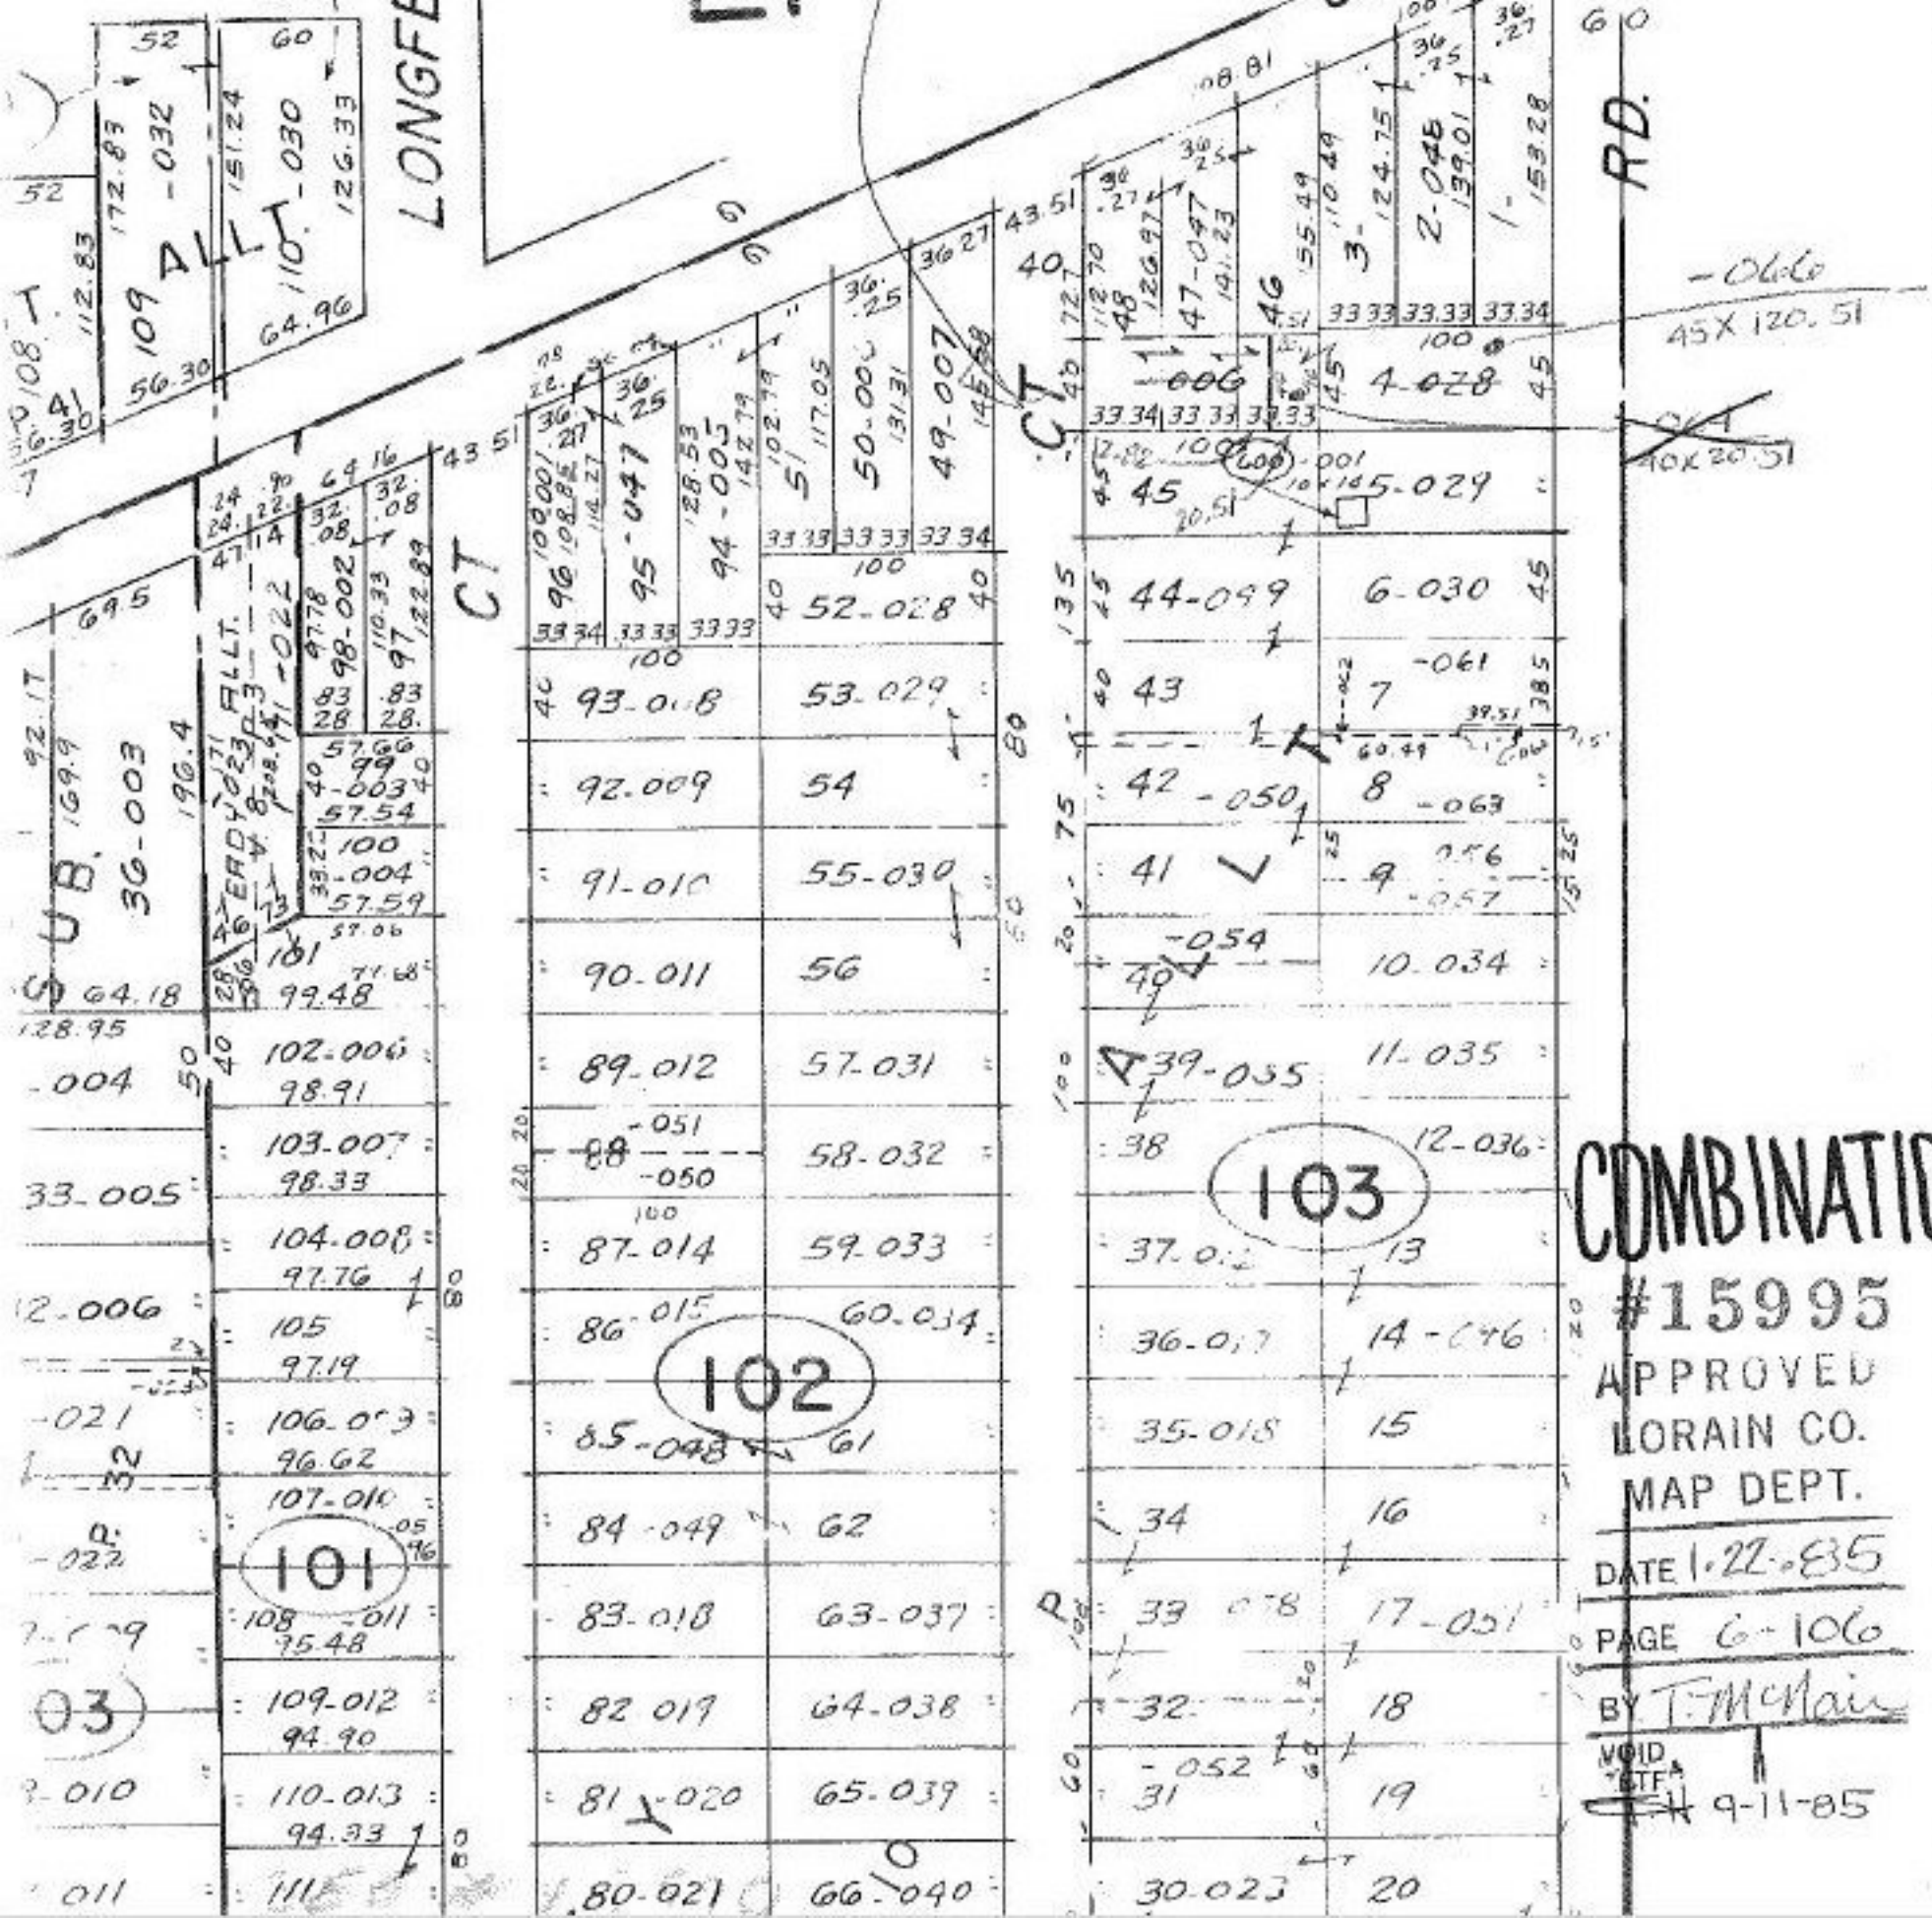

-066
45X 120.51

10X 20.51

COMBINATION

#15995
APPROVED
LORAIN CO.
MAP DEPT.

DATE 1-22-85
PAGE 6-106
BY T. McHair

VOID
IF
9-11-85