


PARENT PARCEL: 15-00-050-000-010

CHILD PARCEL: 15-00-050-000-011 & -012

STARTING POINT: 1" I.P. MON. BOX, CL OF S.R. 303 & CL OF CHAMBERLAIN RD. (STA 53+35.96) LOR-303-14.09

16-00735

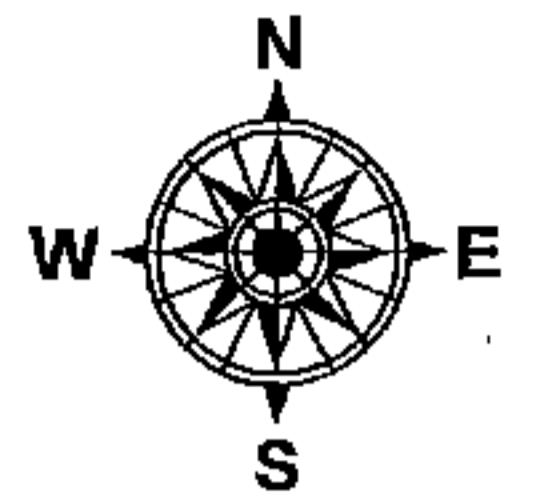

~~-010~~
~~75.35~~
-012
75.10 A.

1106.16

Pl. 15-00-050-000-010
PL 75.35

WAKEMAN LAGRANGE RICHFIELD RD

26.02
95.70
78.05

479.04	-017 2.16	479.04	479.04	-015 .93	479.04	-053 1.25	479.04	-048 2.19
--------	--------------	--------	--------	-------------	--------	--------------	--------	--------------



SPLITS/DEEDS PROCESSED
LORAIN COUNTY TAX MAP DEPARTMENT
226 MIDDLE AVE. ELYRIA, OH

SURVEYED BY:	SCOTT HAWKINS
CLOSURE:	1: 33,000
MAP PAGE(S):	15-00-050
APPROVED BY:	TJS DATE: 8/10/16
SCALE:	1" = 200
PRIOR INSTRUMENT:	OR 626/282