


PARENT PARCEL: 09-00-095-108-007

CHILD PARCEL: 09-00-095-108-056, -057

STARTING POINT: INTERSECTION OF C/L OF LINCOLN ST. AND C/L OF S. PROFESSOR ST.

16-00739

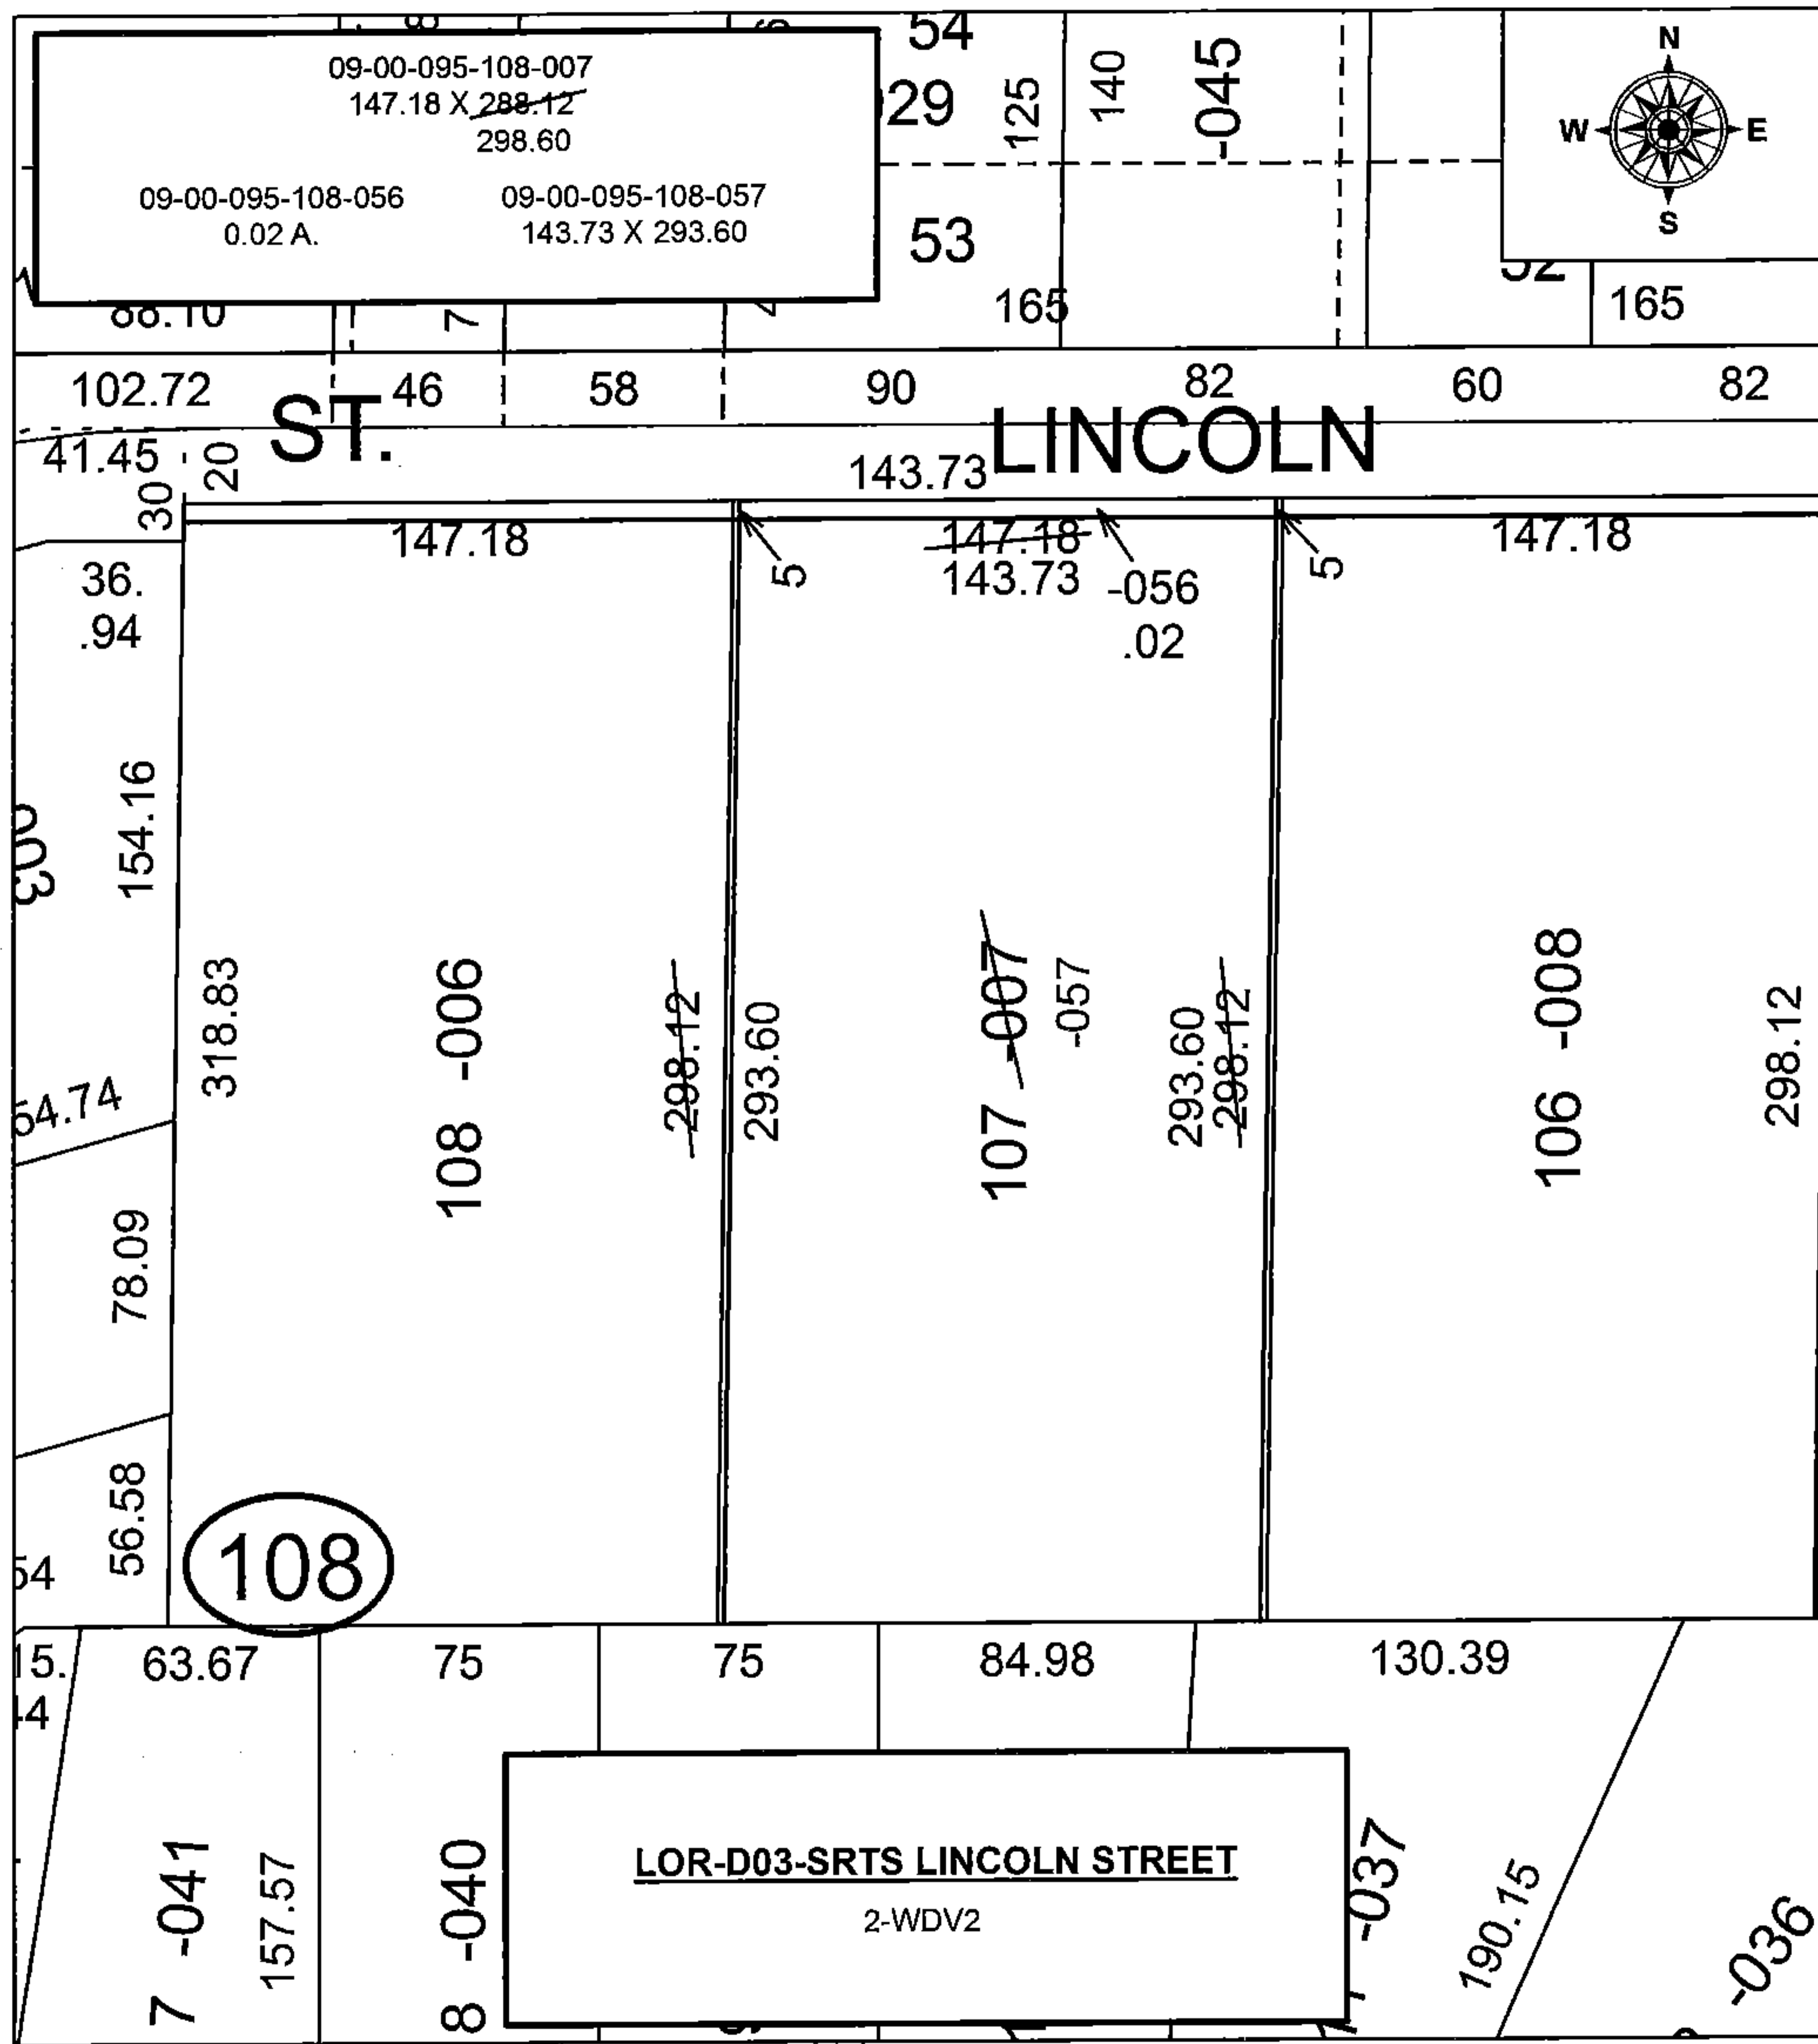

108

LOR-D03-SRTS LINCOLN STREET

2-WDV2

SPLITS/DEEDS PROCESSED

LORAIN COUNTY TAX MAP DEPARTMENT
226 MIDDLE AVE. ELYRIA, OH

SURVEYED BY: TREVORA. BIXLER

CLOSURE: 1:2147483648

MAP PAGE(S): 9-00-095

APPROVED BY: RRM DATE: 10-19-16

SCALE: 1" = 60' PRIOR INSTRUMENT: OR 349/800